




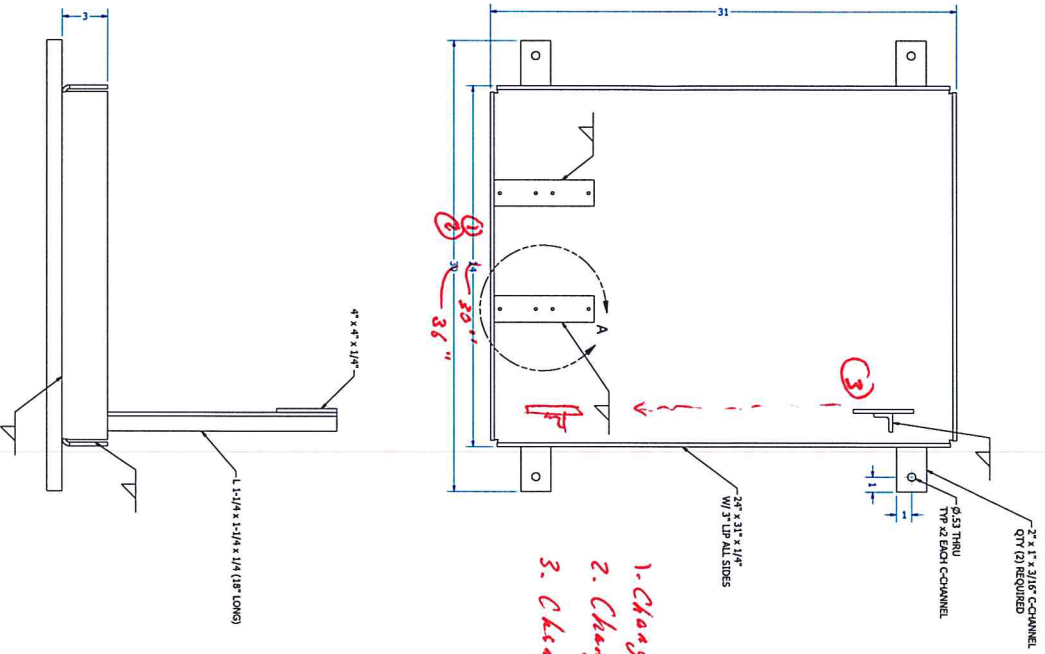

1. Changed to 30" I
2. Changed to 36" I
3. Changed position

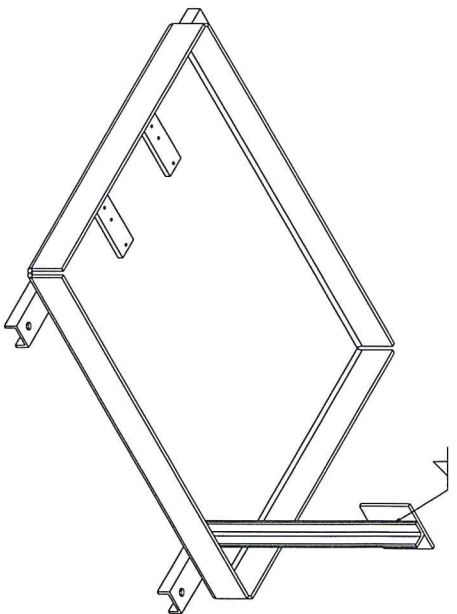

DETAIL A
SCALE 1:1

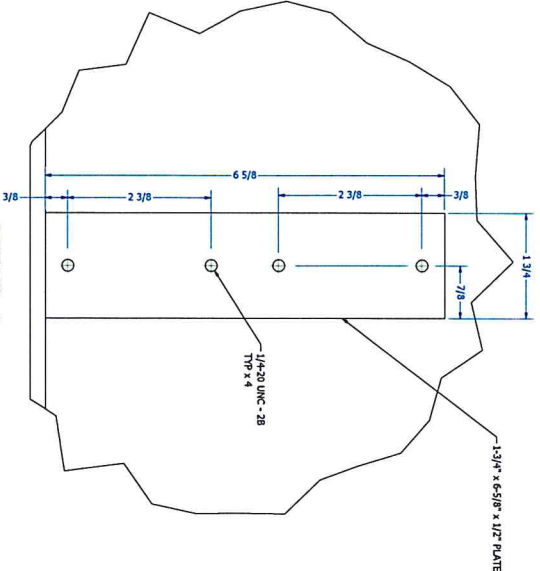

NOTE:
ALL MATERIAL 304SS