
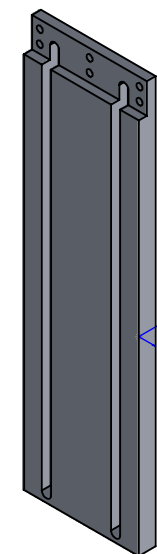


		REVISIONS		
ZONE	REV.	DESCRIPTION	DATE	APPROVED
		INITIAL RELEASE	XX/XX/02	J.E.

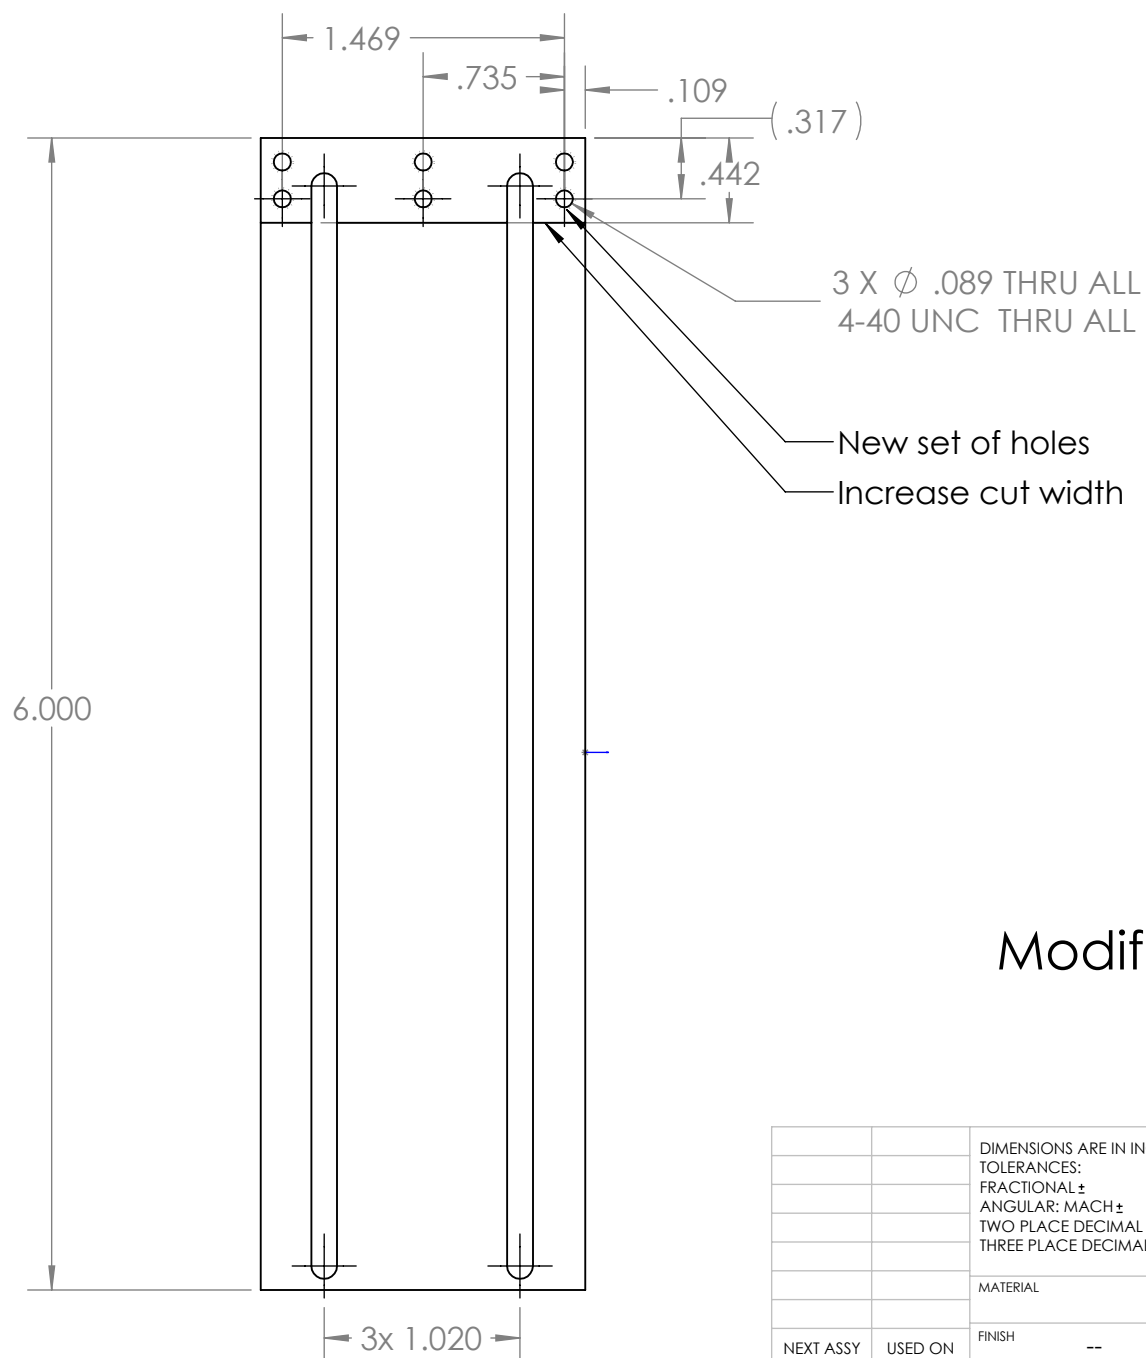

Modification Drawing

		DIMENSIONS ARE IN INCHES TOLERANCES: FRACTIONAL ± ANGULAR: MACH ± BEND ± TWO PLACE DECIMAL ± THREE PLACE DECIMAL ±	APPROVALS		DATE	Monterey Bay Aquarium Research Institute MBARI 7700 Sandholdt RD. Moss Landing, CA 95039 PH: (831) 775-1700		
			DRAWN					
			ENGINEER					
			CHECKED					
		MATERIAL	PROJECT NO.	XXXXXXXXXX		ML Tracking Mesobot Stereo Camera Mount Plate		
		FINISH	PROJECT	XXXXXXXXXX				
NEXT ASSY	USED ON	---	WEIGHT	0.201 lb.		SIZE A	DWG. NO. P-100221503-21	REV.
APPLICATION		DO NOT SCALE DRAWING				SCALE: 1:1	WEIGHT: X0.201X	SHEET 1 OF 1