

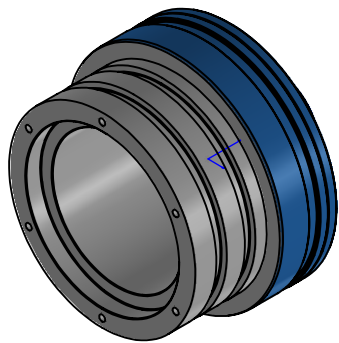


		REVISIONS			
ZONE	REV.	DESCRIPTION		DATE	APPROVED
		INITIAL RELEASE		XX/XX/02	J.E.

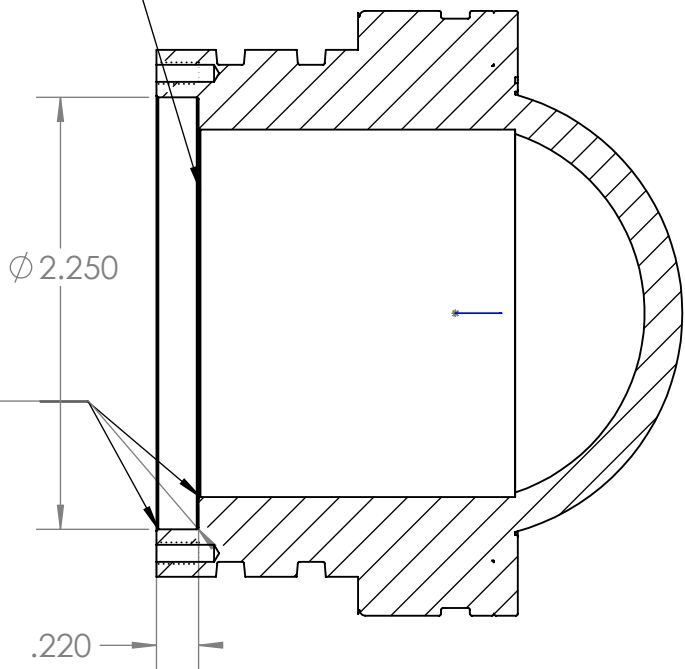

Add $\varnothing 2.25$ Bore

Modification Drawing

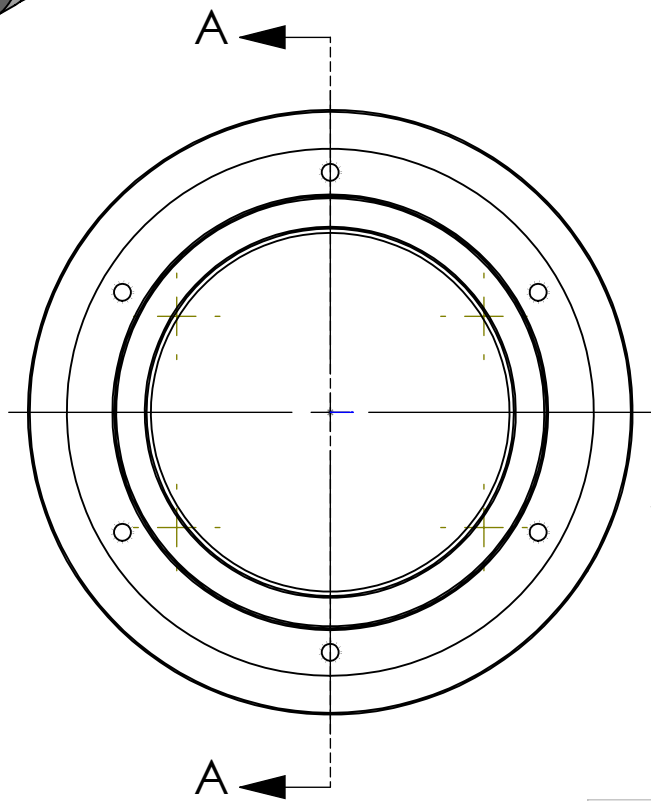

SECTION A-A
SCALE 1 : 1

		DIMENSIONS ARE IN INCHES TOLERANCES: FRACTIONAL ± ANGULAR: MACH ± BEND ± TWO PLACE DECIMAL ± THREE PLACE DECIMAL ±	APPROVALS		DATE	Monterey Bay Aquarium Research Institute MBARI 7700 Sandholdt RD. Moss Landing, CA 95039 PH: (831) 775-1700			
			DRAWN						
			ENGINEER						
			CHECKED						
		MATERIAL	PROJECT NO.		XXXXXXXX	PROJECT NAME MITMS-FT_endcap			
		FINISH	PROJECT		XXXXXXXX				
NEXT ASSY	USED ON	--	WEIGHT		lb.	SIZE A	DWG. NO. .DWG	REV.	
APPLICATION		DO NOT SCALE DRAWING	SCALE:1:2					WEIGHT: XX	SHEET 1 OF 1