SES and TT mooring array

15m (length of 1/2" Spectra 12 strand) between floats
MTS 22,500 lbs
with stopper ring

Shackles - galvanized shackle w/screw pin 1/2" diameter
WLL 2 metric tons
(seized with UV resistant cable tie)

Swivels galvanized eye and eye swivel
1/2"3600 lbs WLL

All stopper rings bent into line. Bringing pear links for future.
to stop off mooring line during recovery
1/2" dia. stock 4" diameter 316 SS ring
WLL = 1600 lbs

All Spectra line has galv thimbles whipped in eye

Releases - Benthos 865A:
a)
receive 10.5 enable F
transmit 11.5 release H
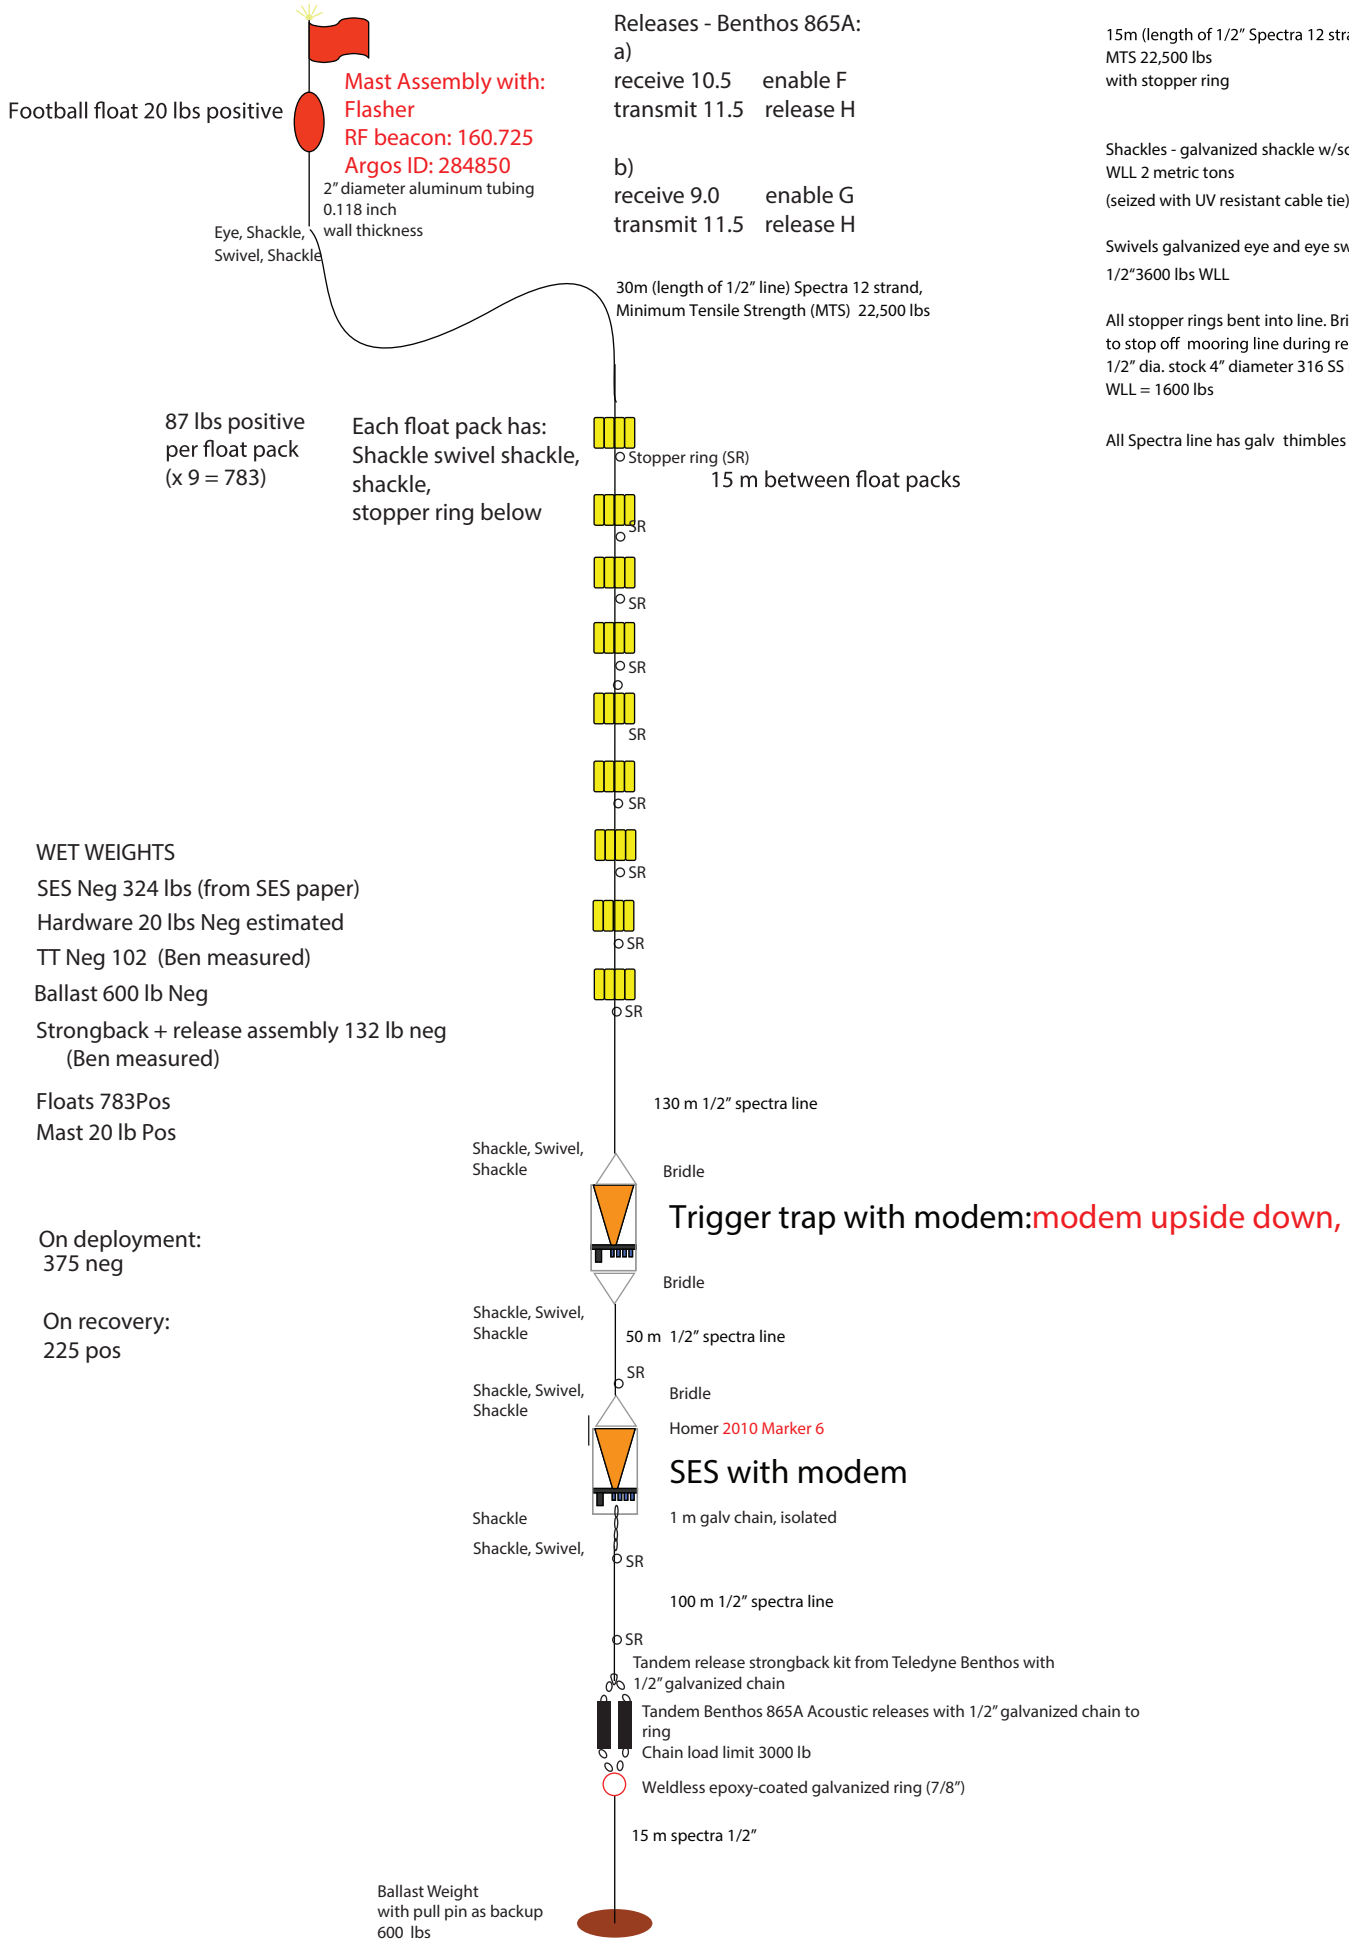
b)
receive 9.0 enable G
transmit 11.5 release H