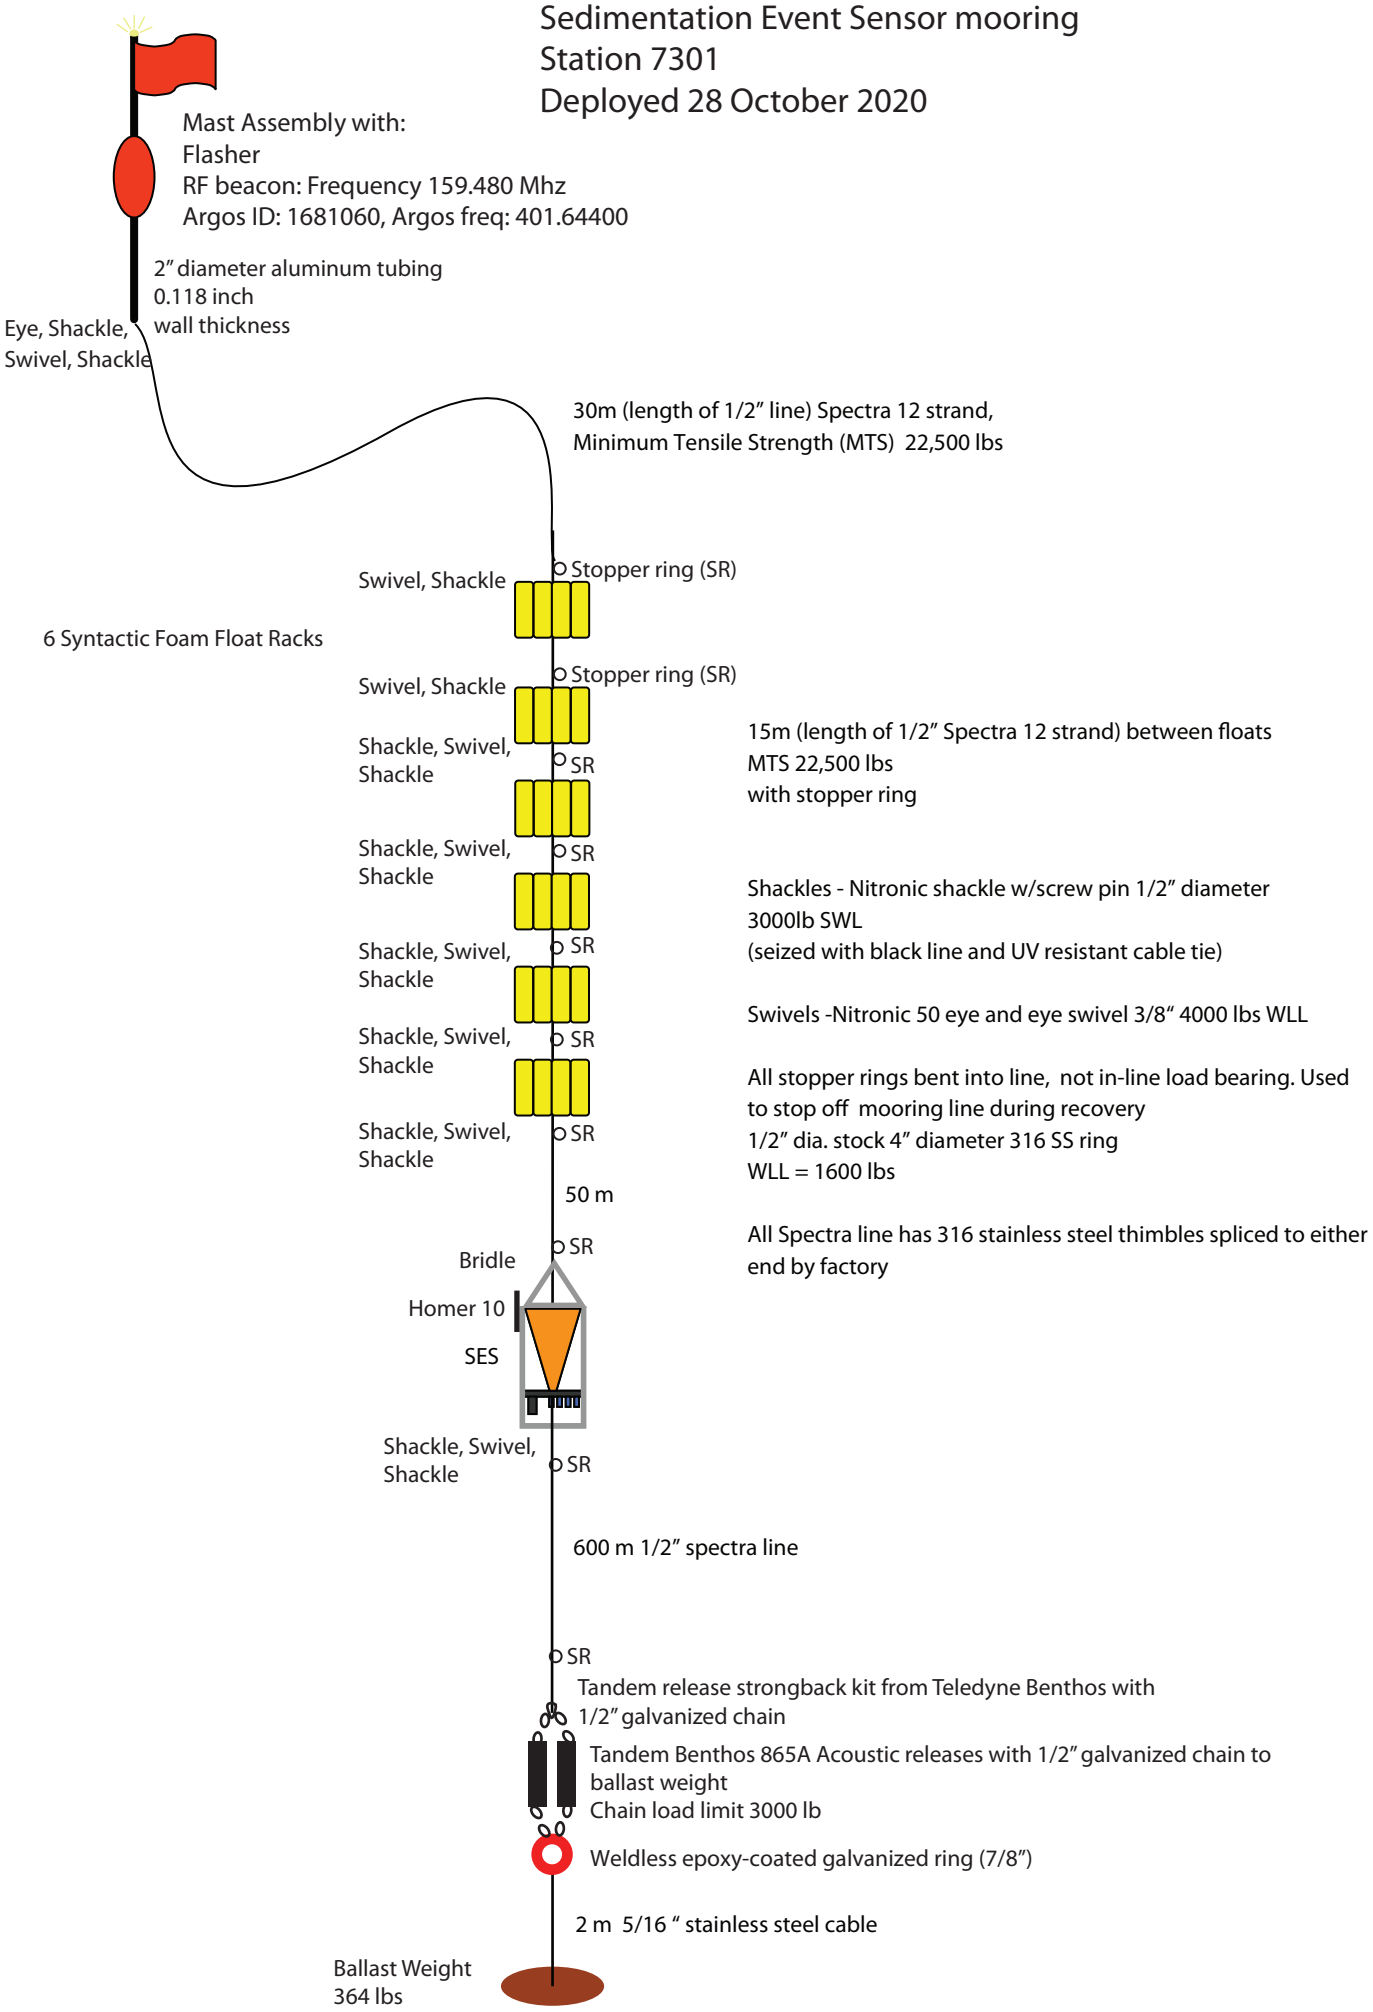Sedimentation Event Sensor mooring
Station 7301
Deployed 28 October 2020