

12-13-2023


EW

THE INFORMATION CONTAINED IN THIS DRAWING IS THE SOLE PROPERTY OF MBARI. ANY REPRODUCTION IN PART OR WHOLE WITHOUT THE WRITTEN PERMISSION OF MBARI IS PROHIBITED.

Measured two of each

REVISIONS				
ZONE	REV.	DESCRIPTION	DATE	APPROVED
	A	ORIGINAL RELEASE		


PART #1

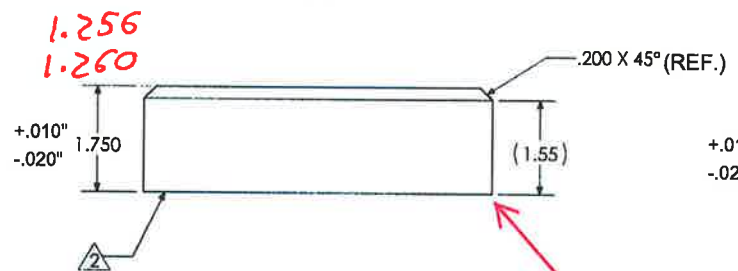


BREAK SHARP EDGE AT 45 DEGREES
(STONE or FINE GROUND FINISH)

Ø 5.750
+/- .010"

5.753
5.753

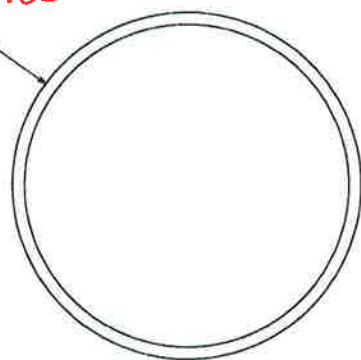


PART #2

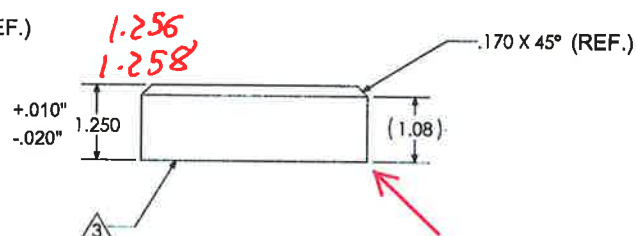

BREAK SHARP EDGE AT 45 DEGREES
(STONE or FINE GROUND FINISH)

Ø 3.750
+/- .010"

3.713
3.713

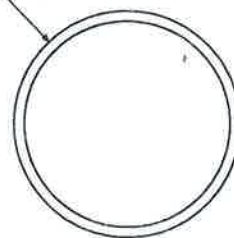

PLANO SURFACES FLAT TO 0.0003"

PRISM = 0.005" MAX.

CONCENTRICITY = 0.005"

PLANO SURFACES TO MEET 60/40 SCRATCH/DIG

O.D. IS FINE DIAMOND FINISH

BEVEL IS FINE DIAMOND or FINE GROUND FINISH

NOTES:

1. MATERIAL IS ~~BOX~~ THERMALLY TEMPERED SCHOTT N-BK-7, GA/FA
2. SUPPORTED ID 4.8125
3. SUPPORTED ID 3.0625
4. DESIGNED WORKING DEPTH 1000m

UNLESS OTHERWISE SPECIFIED

TOLERANCES ARE:

1. DIMENSIONS ARE IN INCHES
2. DIMENSIONS ARE HELD AFTER PLATING
3. REMOVE BURRS AND SHARP EDGES DIS MAX
4. MACHINED BEVEL RADIUS .010-.020
5. MACHINED DIMENSIONS ON A COMMON CENTERLINE CONCENTRIC WITH .001
6. PERPENDICULARITY & PARALLELISM OF MACHINED SURFACES .002 PER INCH MAX. 0.001 INCHES FOR SINGLE SURFACE

DO NOT SCALE DRAWING

APPROVALS

DRAWN

ENGINEER

CHECKED

PROJECT NO.

PROJECT

DATE

SCALE

WEIGHT: 4.00 LB.

DATE

2023-06-28








**MONTEREY BAY AQUARIUM
RESEARCH INSTITUTE**

MBARI

SINKER GLASS PORTS

SHEET 1 OF 1

SCALE 1:2











MBARI DRAWING #18928 REV. A MODIFIED