



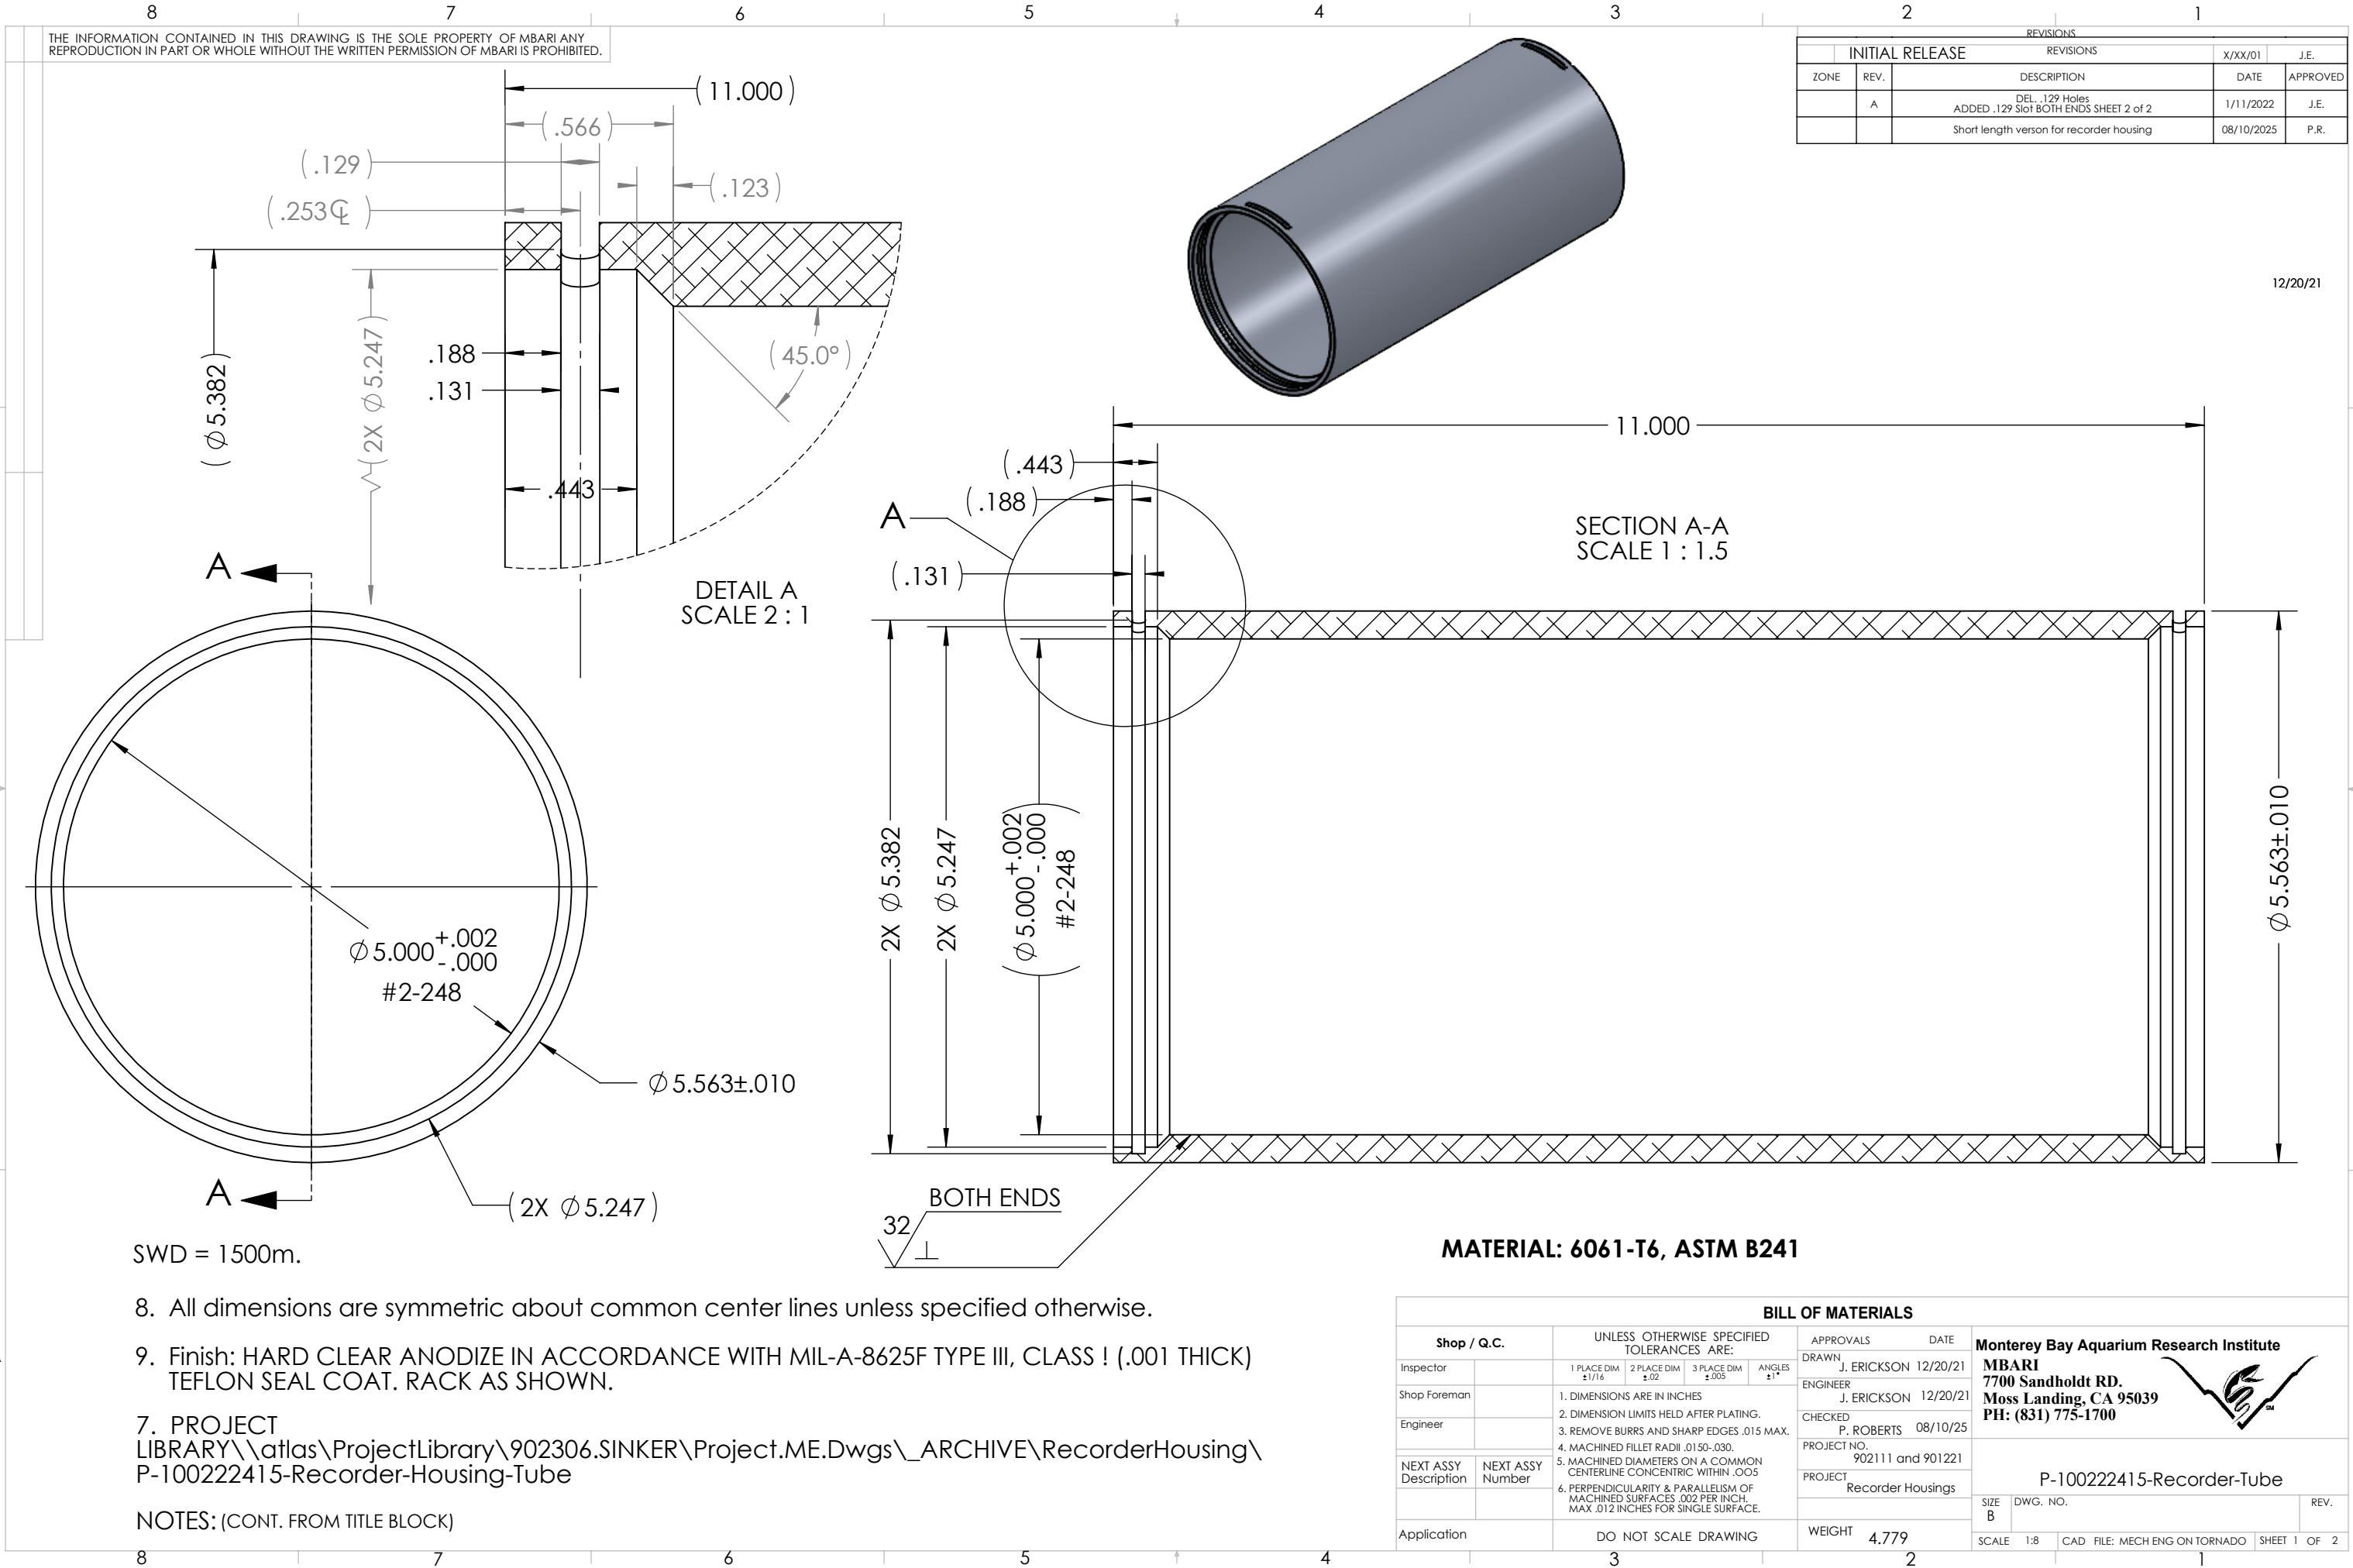


THE INFORMATION CONTAINED IN THIS DRAWING IS THE SOLE PROPERTY OF MBARI ANY REPRODUCTION IN PART OR WHOLE WITHOUT THE WRITTEN PERMISSION OF MBARI IS PROHIBITED.

REVISIONS			
REV.	DESCRIPTION	DATE	APPROVED
	INITIAL RELEASE	X/XX/00	J.E.

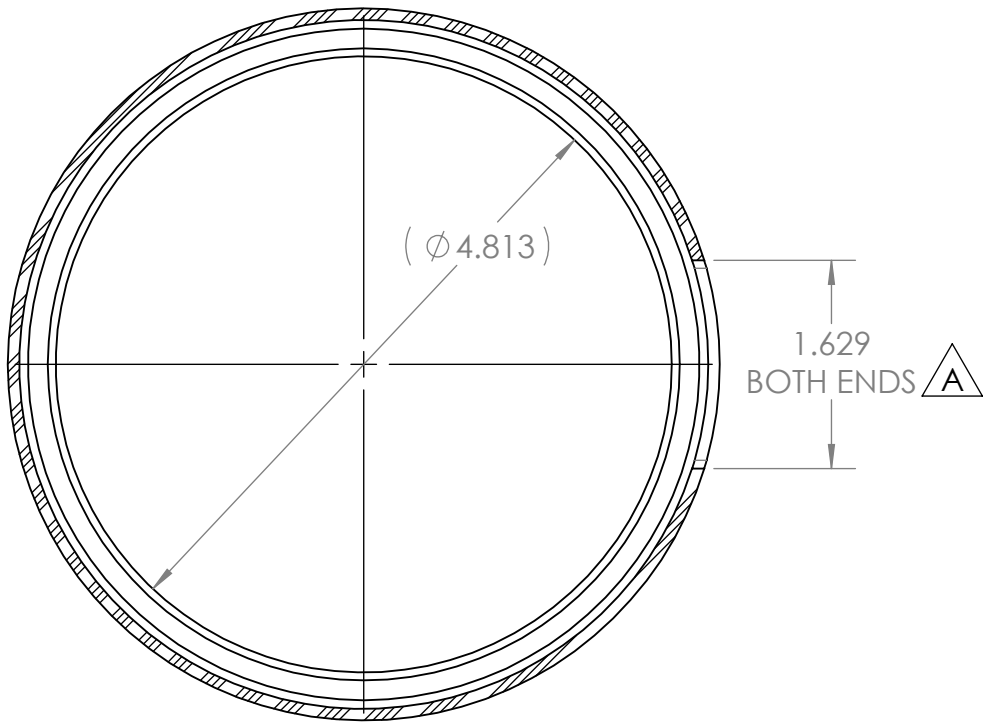

SECTION B-B
SCALE 1 : 1.5
BOTH ENDS

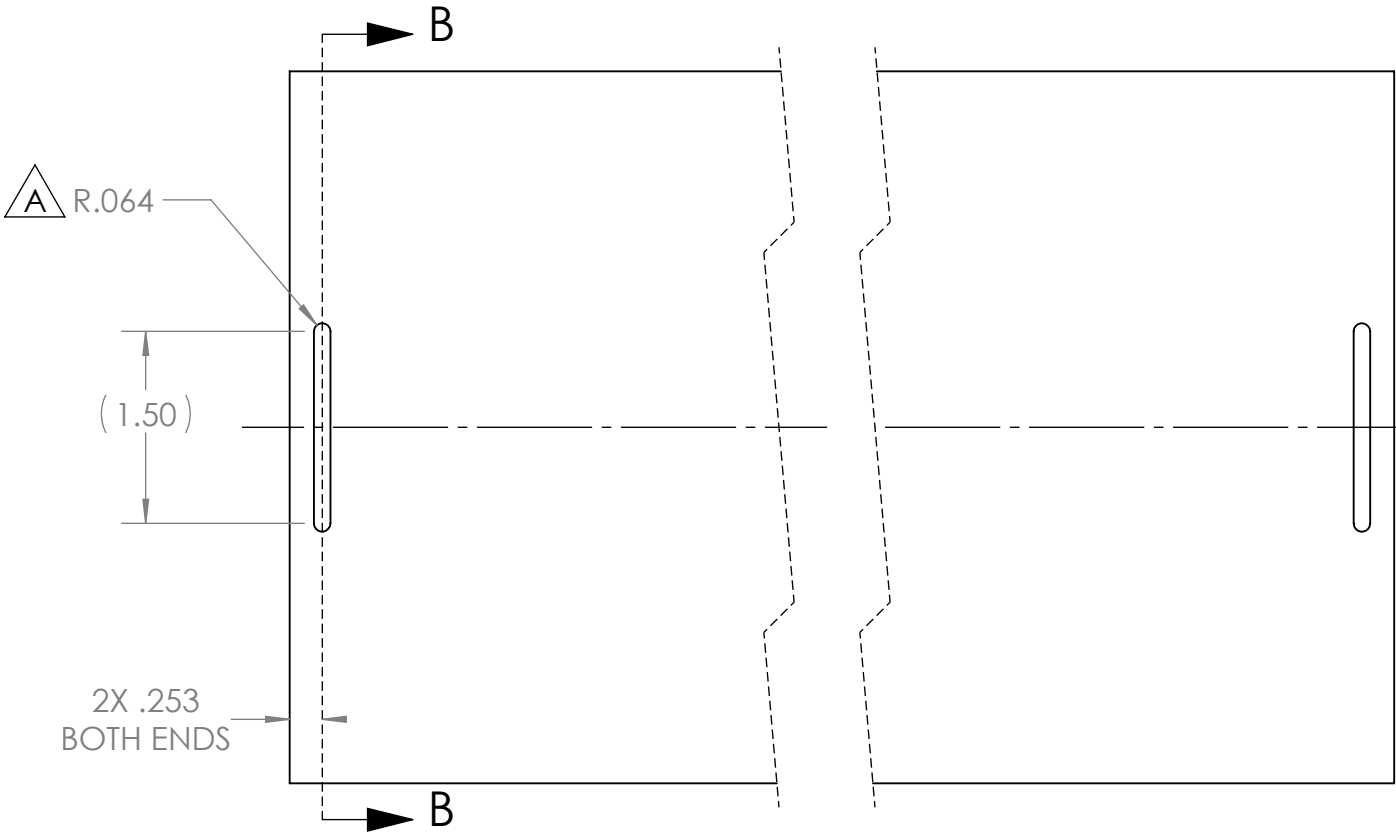

NOTES: (CONT. FROM TITLE BLOCK)

ITEM NO.	QTY.	PART NO.	DESCRIPTION	VENDOR	MATERIAL SPECIFICATION
BILL OF MATERIALS					
Shop / Q.C.		UNLESS OTHERWISE SPECIFIED TOLERANCES ARE:		APPROVALS DATE	
Inspector		1 PLACE DIM ±1/16	2 PLACE DIM ±.02	3 PLACE DIM ±.005	ANGLES ±1°
Shop Foreman		1. DIMENSIONS ARE IN INCHES		DRAWN	J. ERICKSON 12/20/21
Engineer		2. DIMENSION LIMITS HELD AFTER PLATING.		ENGINEER	J. ERICKSON 12/20/21
		3. REMOVE BURRS AND SHARP EDGES .015 MAX.		CHECKED	P. ROBERTS 08/10/2025
		4. MACHINED FILLET RADII .0150-.030.		PROJECT NO.	902004
NEXT ASSY Description	NEXT ASSY Number	5. MACHINED DIAMETERS ON A COMMON CENTERLINE CONCENTRIC WITHIN .005		PROJECT	Recorder Housings
		6. PERPENDICULARITY & PARALLELISM OF MACHINED SURFACES .002 PER INCH. MAX .012 INCHES FOR SINGLE SURFACE.			
Application		DO NOT SCALE DRAWING		WEIGHT	6.269 lb.
				SIZE B	DWG. NO.
				SCALE 1:8	CAD FILE: MECH ENG ON TORNADO
				SHEET 2	OF 2

Monterey Bay Aquarium Research Institute

MBARI

7700 Sandholdt RD.

Moss Landing, CA 95039

PH: (831) 775-1700



Monterey Bay Aquarium Research Institute
MBARI
7700 Sandholdt RD.
Moss Landing, CA 95039
PH: (831) 775-1700



P-100222415-Recorder-Tube