

Geo-sense Deployment Record Sheet

Completed By: Rebecca Englert

Set-up

Date: Feb 2, 2026

Parameter	Comments
Sampling frequency	40 000 Hz RF offset: 1/3 ping rate
Gauge length	6-33m
Channel spacing	6-33m
Number of channels	166 channels
Cable type	1st Indecon cable.
Cable length	~1km
File storage location	mnt/md01 Feb 2026 Raw Feb 2026 HDF5
Data formats	sensor data (HDF5), sensor data 32bit
Data preprocessing	• decimator: 1/2 filter, to 1000 Hz • leaky cutoff: 0.001 Hz ↳ changed to 0.01 Hz Feb 3 @ 2:45pm PST
Configuration file used	Feb2026-config

OTDR

Date: Feb 2, 2026

Attenuation level: ~ -17 dB

Comments: consistent along cable except for higher loss in first few channels.

Length of fibre: 1050m

Measure Noise Floor

Date: Feb 2, 2026

Noise floor level: -78.1 dB

Comments: _____

Deployment

Date: Feb 3 2026

Deployment vessel and type: Elevator deployment from the Carson.
ROV Ventura used to pick up spool and lay cable. End of cable
(black hole) in spool so spool is left on seafloor.


frequency = 156.67500 MHz

Releases, beacons instruments: Novatech RF-700A (S/N: W03-134), Novatech SF400A (S/N: N05-042), hydrophone ST600HF (S/N: 8610), homer beacon: 96 RT6-3000 Sonadyne release (S/N: 312700-001) address: 2013, TAT: 240 UID: 0066 F4 battery voltage: 5.6V

Deployment Location (Instrument)

Latitude: 36°47.5961 Longitude: 121°53.056 Depth: 378mwd. USBL Location

Deployment Location (Cable end)

Latitude: 36°47.3188 Longitude: 121°53.6077 Depth: _____ INS Location

ROV Dive # 4718.

Date/Time (UTC) local	Latitude, Longitude	Event Log (deployment begun, frame on seafloor, cable laying etc.)
8:17	36°47.5904 121°53.1388	Elevator dropped 100m - 3 min 160m - 4 min 214m - 6 min 286 in 8 min
8:28	drifted 80m @ heading 70° - took 11 min to drop	Elevator landed @ 378mwd. 350 in 10 min 378 in 11 min
8:37		ROV going down
8:57		ROV @ bottom.
9:01	36°47.5961 121 53.056?	@ elevator - checked comp. 24, 3.75 (2)
9:14	36°47.5962 121 53.06	toast plugged in. communicating w instrument. load looks good, checked noise floor
9:32		disengaged deep sea connect.
9:47		start to cable laying.
10:00 → off	seafloor? for cleaning?	
10:21		Starting to unspool maybe not in the right direction yet.

load normal

slightly higher
↑
optical setup recorders, RF + sequencing

elevator
→
ROV path pulling cable.

10:32 Set down spool 36°47.571 ?
follow cable 121°53.07
back to elevator.

took off briefly to remove mud from ROV.

10:35 → one loop not on seafloor.
 10:39 → fibre is wrapped around elevator
 10:42 → clearing.

10:46 → back to trying to look at
 cable on elevator. → strong current
 and poor visibility.
 10:52 → clearing

11:16 → heading back to spool

11:21 → picked up spool and
 starting to lay cable.

↳ some kinks in cable on spool
 ↳ wound too loose so not pretty
 watching it unspool

11:49 → changed direction from 130°
 $36^\circ 47.4121$ heading to 148°
 $121 53^\circ.33$.

12:13 → put down spool

$36^\circ 47.3238$ ↳ pulled
 $121 53.60$ tight @ end.
 — placed
 marker.

12:19 → surveying cable back to elevator.
 ↳ ROV directly above cable.

↳ cable is all straight and all on seafloor.


12:49 @ elevator checking out cable.

12:55 deep sea connect

— 60dB noise floor. — 40dB spike
 at very start of cable.

OTDR → cable length is 21.5m; lost all
 signal passed flat part.

↳ Pinkela says due to macro bend in cable
 not break.

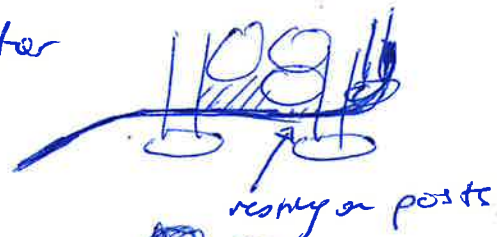

cable
 is making
 a "6" around
 elevator
 frame.



ROV dive 4718



updated.
 cable
 wrapped
 around
 3 legs

VARIS

Date/Time (UTC)	Latitude, Longitude	Event Log (deployment begun, frame on seafloor, cable laying etc.)
1:12 pm		Going to try to spin elevator to loosen/unwind cable.
2:16 pm		going to connect to deep sea connect.
	Andri's stops	① OTDR ② Noise test test
		③ turn on recorders ^{change leaky to 1Hz then back.}
2:42 pm		changed leaky to 0.01 Hz
		↳ to compensate for high noise level.
3 pm		ROV ramp recovered.
		
Downloaded files		
* 22:28:36 ⇒ 14:28:36		After adjustments
* 19:06:19 ⇒ 11:06:19		ROV not around, cable wound
22:32:29 ⇒ 14:32:29		After adjustments.
18:03:42 ⇒ 10:03:42		@ seafloor
* 17:38:39 ⇒ 9:38:39		@ seafloor to ROV around.
mm 11	12.52 mm	

17:51:10

Feb 4
ROV
dive #
4719

all
previous
were
USBL
(not as
accurate)

Date/Time (UTC) PST	Latitude, Longitude	Event Log (deployment begun, frame on seafloor, cable laying etc.)
8:00 am	Ship → 36°47.5962 121 53.0814	launching ROV
8:24		at elevator checking comps. Lo look good, out ^{pulls and}
8:36	36 47.5723 121 53.076 (USBL)	dropped weight to NW of cable ~ 1 ft away. ~ 50m along cable.
8:41	36°47.5774 121 53.0757 (INS position)	~ 30m along cable. ~ 1.5 ft away NW of cable NW of cable.
8:45:08	36°47.5823 121 53.0726	~ 20m along cable - 1 ft away NW of cable.
8:48:24	36°47.5804 121 53.0702	10m along cable. → actually more like 17m away. - 1.5 ft NW of cable. - zoomed in cable.
8:52:13	36 47.5925 121 53.0679	On along (10m more along cable) - farther away
8:54:39	36 47.5931 121 53.0684	- 3m along from start of basically at elevator. NW of cable, ROV did not turn around
9:05		- discuss removing loop in cable, decide to pull out strain release
9:15		- connecting to instrument

arcNav
is USBL
position

turn
around
due to
close
prox
to elevator.

12/18/95
36 47 53
Boman



- download logs
- download file before

02.03 18.03.42
12.03 19.06.19

9:51 $\Rightarrow$ unplugging from deepsee connect

*Intel suggests noisy channel is propeller noise or cable flapping.

9:53 $\Rightarrow$ trying to remove loop. $\rightarrow$ abandoned due to poor visibility.

9:59 $\Rightarrow$ going to resume drops

100m drop - 36° 47.5538 } not able to complete
due to poor vis ad current.

10:15 $\Rightarrow$ heading to 121 53.1089
end of cable to see if conditions improve.

10:35:57 250m drop 36° 47.5042
121 53.1932

10:39:45 300m drop 36 47.4850
121 53.2190

10:43:36 350m 36 47.4659
121 53.2415

10:47:34 400m 36 47.4486
121 53.2680

10:50:50 450m 36 47.4301
121 53.2925

10:54:56 500m 36 47.4134
121 53.3173

10:59:40 550m 36 47.4006
121 53.3489

11:03:38 600m 36 47.3911
121 53.3809


11:06:49 650m 36 47.3788
121 53.4117

~1 inch (between layers)
drop NW of cable.

ROV coordinates
log $\Rightarrow$ USBL $\pm 10m$
INS $\Rightarrow$ drift per hour $\times$
to couple meters.
to use other adels

9:24 -7 -58.9 dB (hot fit)
9:26 -6 -58.9

9:44 $\rightarrow$ tapped strain ~~release~~
on waterfall see signal before
refraction
9:46 -59dB
time

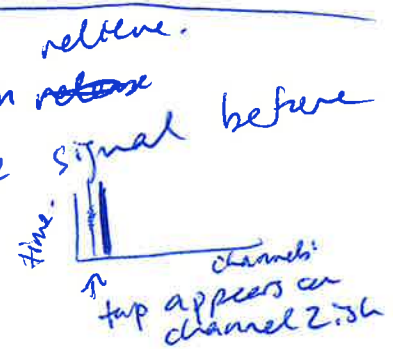

Feb 4 Dive 4719


*distances are approximate, will need to measure.

Date/Time (UTC)	Latitude, Longitude	Event Log (deployment begun, frame on seafloor, cable laying etc.)
11:09:10:01	36 47.3687 121 53.4429	700m weight drop. 2 kink between drop locations
11:13:19	36 47.3629 121 53.4767	750m drop.
11:16:45	36 47.3531 121 53.5077	800m drop. (fish hit right before).
11:20:05	36 47.3407 121 53.5390	850m drop
11:24:02	36 47.3302 121 53.5701	900m drop.
11:28:24	36 47.3196 121 53.6040	950m drop.
11:29:40	36 47.3188 121 53.6072	drop at end of cable/spool 955m drop.
11:32		heading back to get missed drops.
11:47:31	36 47.5225 121 53.1675	200m drop.
11:50:11	36 47.5392 121 53.1371	150m drop.

11:53:02 36 47.5532 100m drop
121 53.1086

11:59 → @ elevator to fix loop.

*need to get take fast + rod on return.

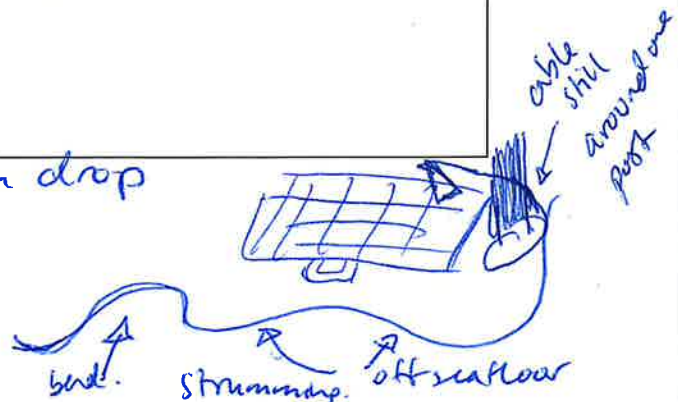

12:14 → heading to Gene elevator.

12:38 @ Jim's elevator

1:13 done at elevator