
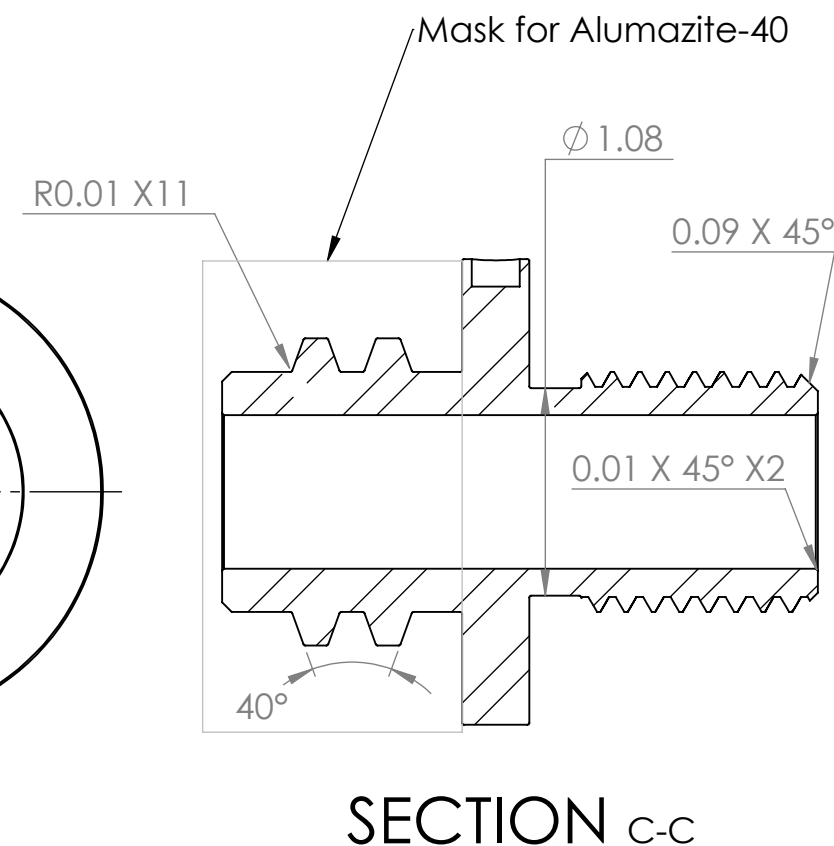
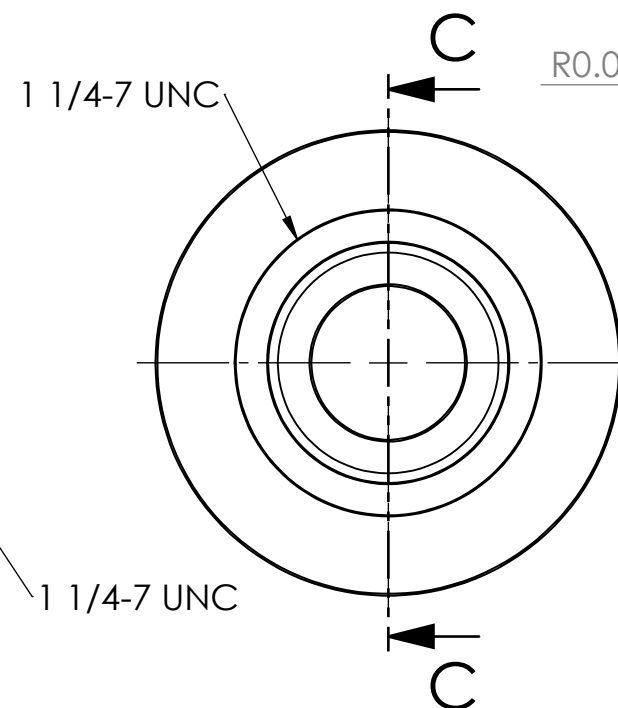
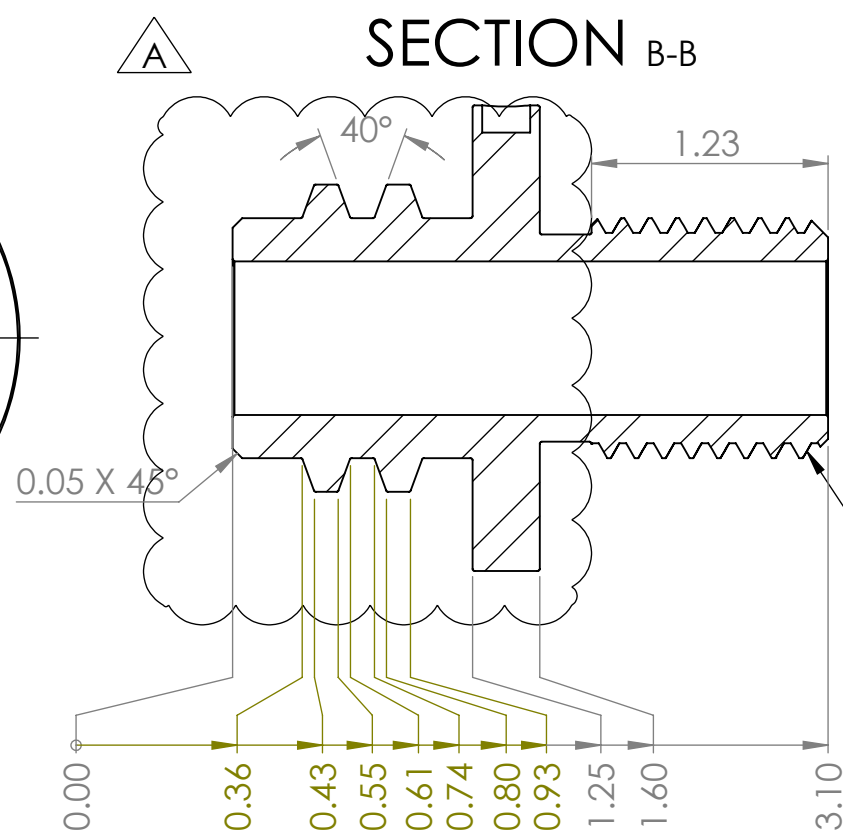
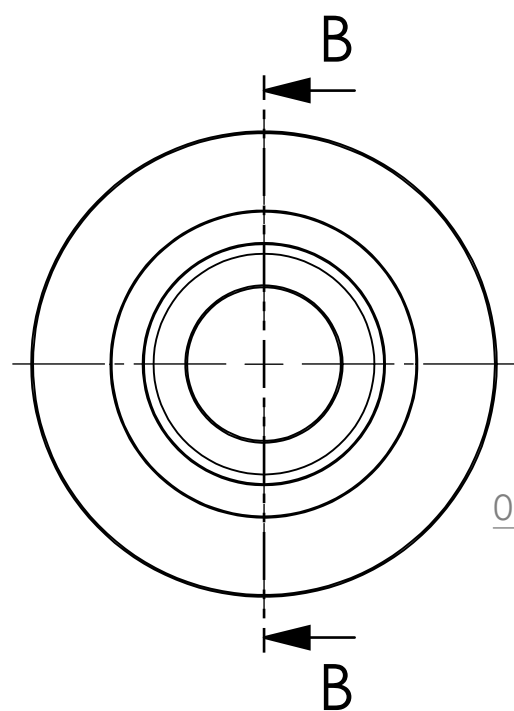
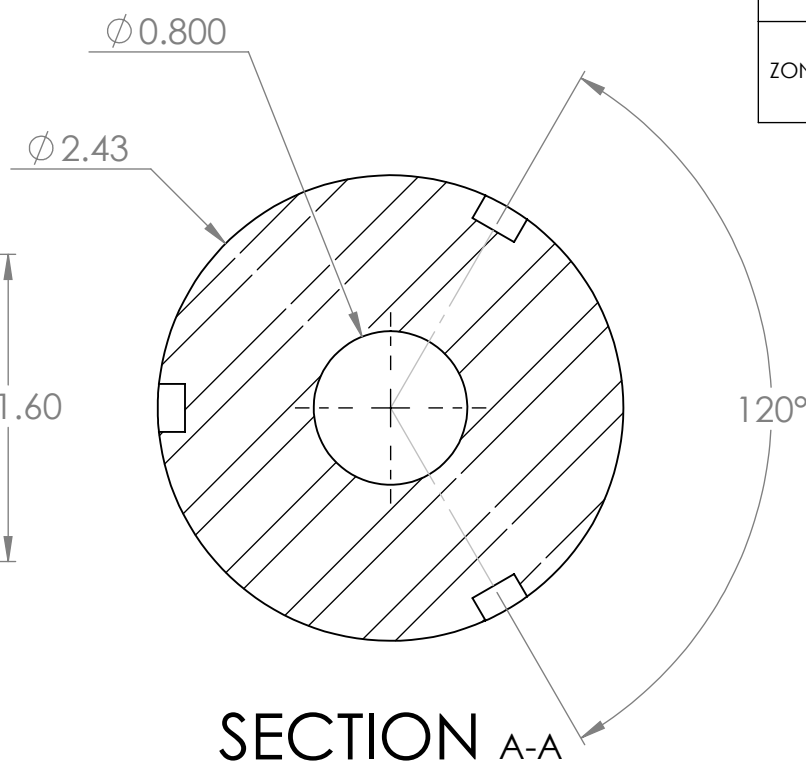
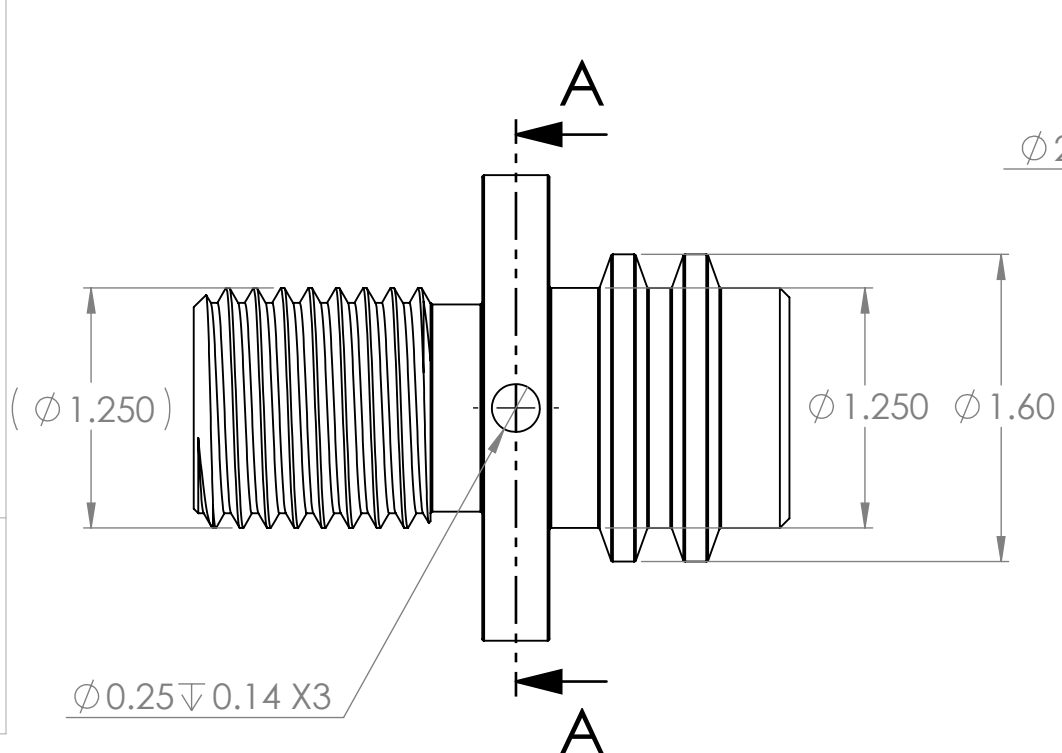


THE INFORMATION CONTAINED IN THIS DRAWING IS THE SOLE PROPERTY OF MBARI ANY REPRODUCTION IN PART OR WHOLE WITHOUT THE WRITTEN PERMISSION OF MBARI IS PROHIBITED.

			REV. REVISIONS DESCRIPTION DATE APPROVED INITIAL RELEASE		
ZONE	REV.A	Increased length of the bending strain relief bonding surface(*See revision cloud)	DATE	APPROVED	

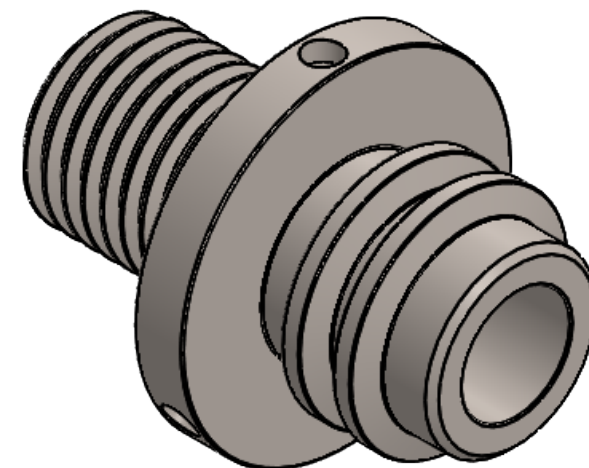

Note:

1. Quantity 2
2. Material: 316L Stainless Steel
3. SURFACE FINISH: PASSIVATE per ASTM A380-96 CODE F
4. Coating: Alumazite ZM-40(Please allow 0.001" for build-up)

BILL OF MATERIALS											
Shop / Q.C.		UNLESS OTHERWISE SPECIFIED TOLERANCES ARE:				APPROVALS		DATE		Monterey Bay Aquarium Research Institute MBARI 7700 Sandholdt RD. Moss Landing, CA 95039 PH: (831) 775-1700 	
Inspector		1 PLACE DIM ±1/16	2 PLACE DIM ±.02	3 PLACE DIM ±.005	ANGLES ±1°	DRAWN Aaron Schnittgter	8/27/23	ENGINEER Aaron Schnittgter	8/27/23		
Shop Foreman		1. DIMENSIONS ARE IN INCHES 2. DIMENSION LIMITS HELD AFTER PLATING. 3. REMOVE BURRS AND SHARP EDGES .015 MAX. 4. MACHINED FILLET RADII .0150-.030.				CHECKED					
Engineer		5. MACHINED DIAMETERS ON A COMMON CENTERLINE CONCENTRIC WITHIN .005 6. PERPENDICULARITY & PARALLELISM OF MACHINED SURFACES .002 PER INCH. MAX .012 INCHES FOR SINGLE SURFACE.				PROJECT NO.	902401	100222320_StrainRelief_Boss			
NEXT ASSY Description	NEXT ASSY Number					PROJECT	GeoSense				
						DO NOT SCALE DRAWING				WEIGHT	
Application											