
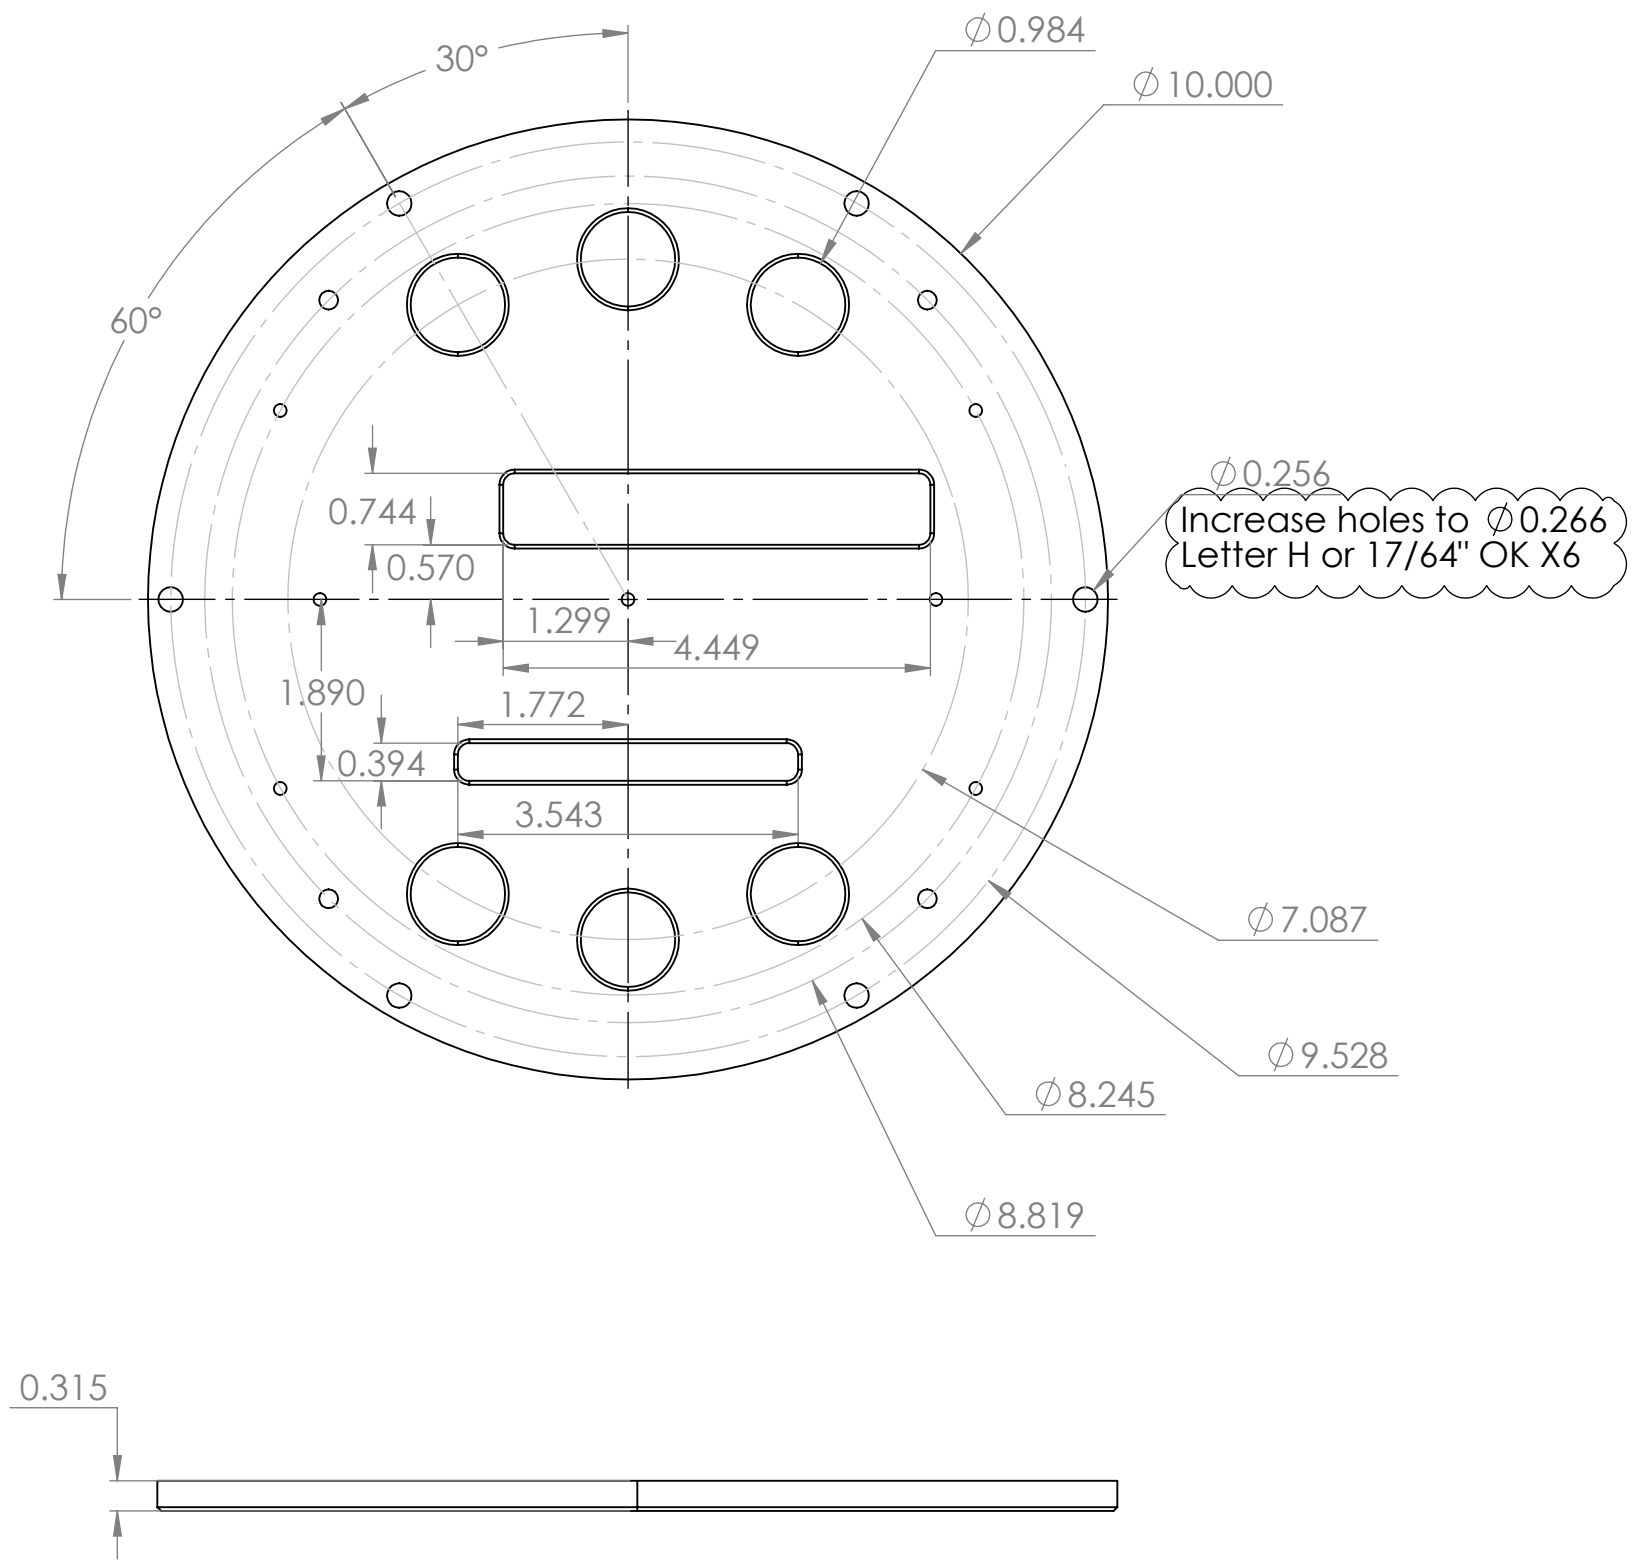


THE INFORMATION CONTAINED IN THIS DRAWING IS THE SOLE PROPERTY OF MBARI ANY REPRODUCTION IN PART OR WHOLE WITHOUT THE WRITTEN PERMISSION OF MBARI IS PROHIBITED.

REVISIONS			
REV.	DESCRIPTION	DATE	APPROVED
	INITIAL RELEASE		

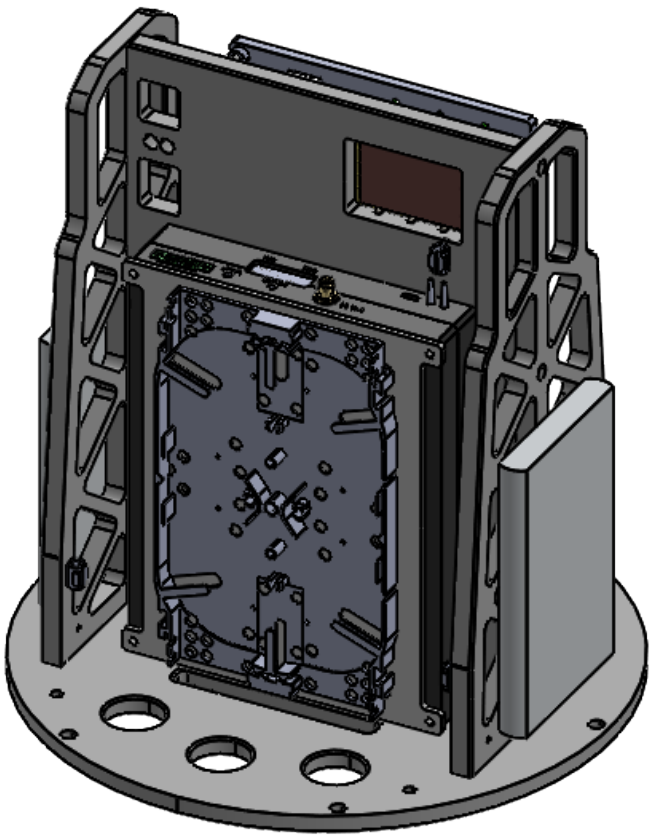

BILL OF MATERIALS											
Shop / Q.C.		UNLESS OTHERWISE SPECIFIED TOLERANCES ARE:				APPROVALS		DATE		Monterey Bay Aquarium Research Institute MBARI 7700 Sandholdt RD. Moss Landing, CA 95039 PH: (831) 775-1700 	
Inspector		1 PLACE DIM ±1/16	2 PLACE DIM ±.02	3 PLACE DIM ±.005	ANGLES ±1°	DRAWN Aaron Schnittger	8/27/23	ENGINEER Aaron Schnittger	9/27/23		
Shop Foreman		1. DIMENSIONS ARE IN INCHES				CHECKED				AGT 282901 MBARI Assy - Proto Rev 00-00 BASE	
Engineer		2. DIMENSION LIMITS HELD AFTER PLATING.				PROJECT NO.		XXX			
NEXT ASSY Description	NEXT ASSY Number	3. REMOVE BURRS AND SHARP EDGES .015 MAX.				PROJECT		ZZZZZZZZ		SIZE B	
		4. MACHINED FILLET RADII .0150-.030.								DWG. NO.	
		5. MACHINED DIAMETERS ON A COMMON CENTERLINE CONCENTRIC WITHIN .005								100XXXDWG	
		6. PERPENDICULARITY & PARALLELISM OF MACHINED SURFACES .002 PER CH. MAX .012 INCHES FOR SINGLE SURFACE.								REV.	
Application		DO NOT SCALE DRAWING				WEIGHT				SCALE 1:5	
								CAD FILE: MECH ENG ON TORNADO		SHEET 1 OF 1	

AGT 282901 MBARI Assy - Proto Rev 00-00 BASE
BASE