

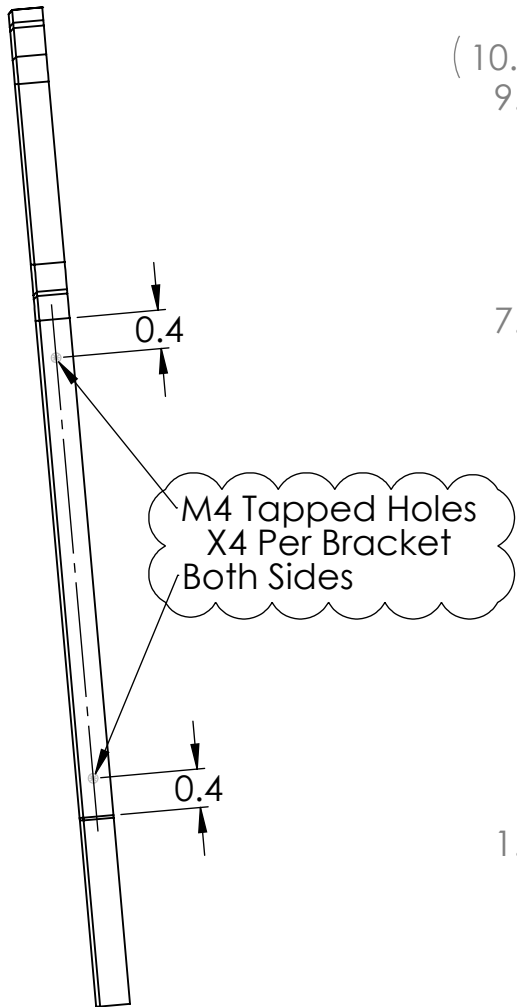
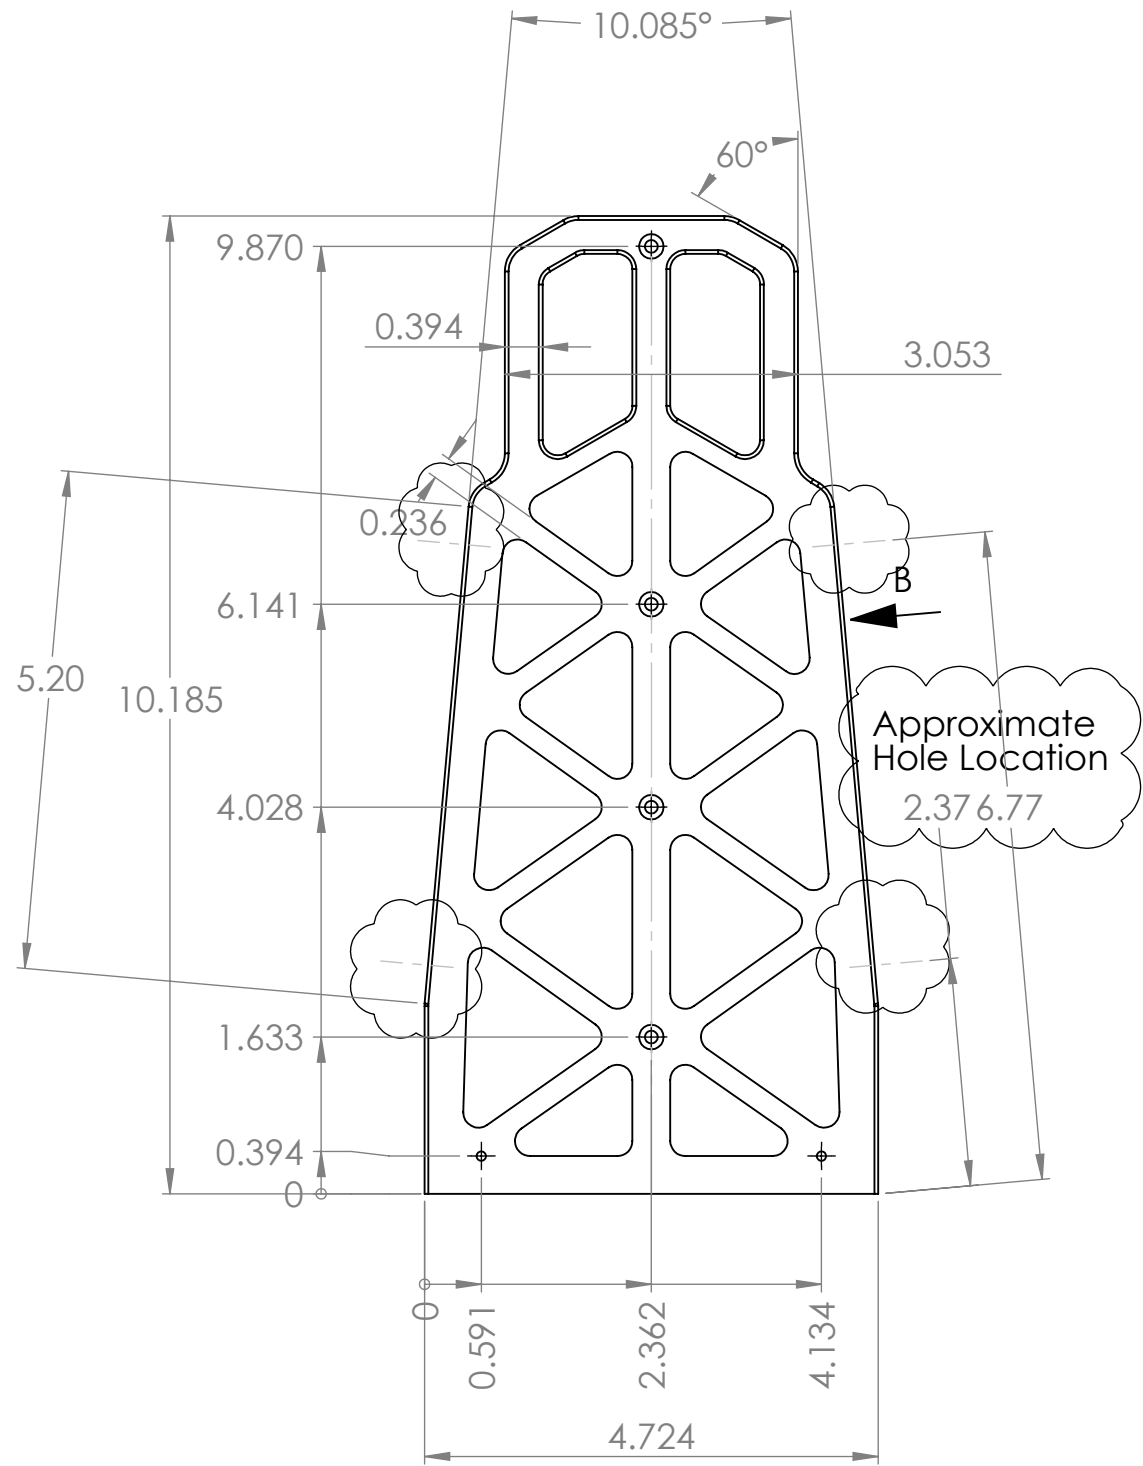


THE INFORMATION CONTAINED IN THIS DRAWING IS THE SOLE PROPERTY OF MBARI ANY REPRODUCTION IN PART OR WHOLE WITHOUT THE WRITTEN PERMISSION OF MBARI IS PROHIBITED.

REVISIONS			
REV.	DESCRIPTION	DATE	APPROVED
	INITIAL RELEASE		

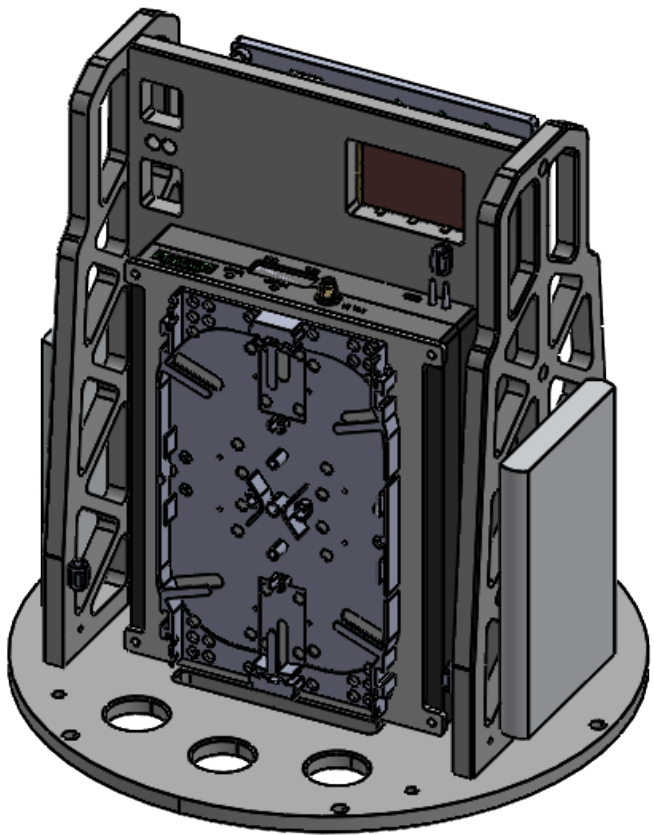

VIEW B
SCALE 1 : 2

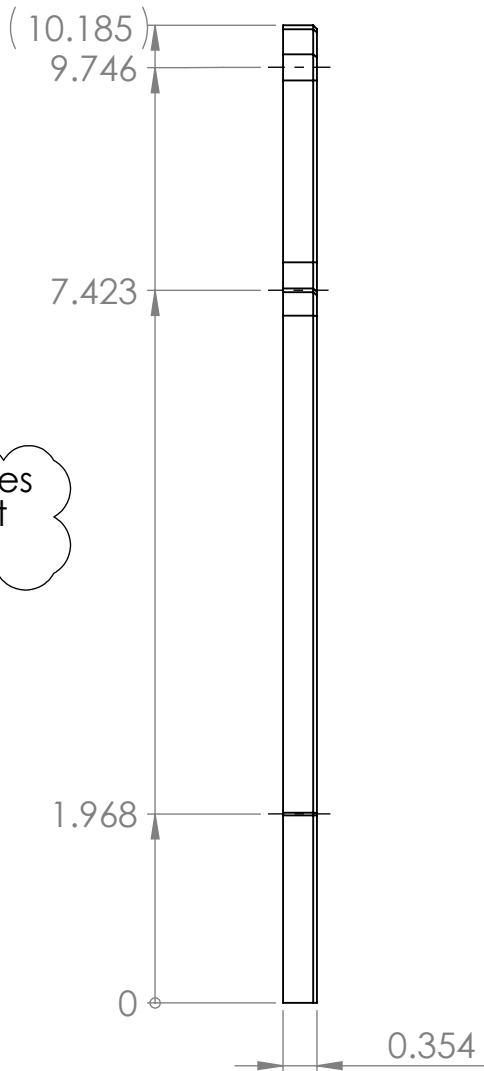

BILL OF MATERIALS									
Shop / Q.C.		UNLESS OTHERWISE SPECIFIED TOLERANCES ARE:				APPROVALS	DATE	Monterey Bay Aquarium Research Institute MBARI 7700 Sandholdt RD. Moss Landing, CA 95039 PH: (831) 775-1700	
Inspector		1 PLACE DIM ±1/16	2 PLACE DIM ±.02	3 PLACE DIM ±.005	ANGLES ±1°	DRAWN Aaron Schnittger	8/27/23		
Shop Foreman		1. DIMENSIONS ARE IN INCHES				ENGINEER Aaron Schnittger	9/27/23		
Engineer		2. DIMENSION LIMITS HELD AFTER PLATING. 3. REMOVE BURRS AND SHARP EDGES .015 MAX. 4. MACHINED FILLET RADII .0150-.030. 5. MACHINED DIAMETERS ON A COMMON CENTERLINE CONCENTRIC WITHIN .005 6. PERPENDICULARITY & PARALLELISM OF MACHINED SURFACES .002 PER INCH, MAX .012 INCHES FOR SINGLE SURFACE.				CHECKED			
NEXT ASSY Description	NEXT ASSY Number					PROJECT NO. XXX		AGT 282901 MBARI Assy - Proto Rev 00-00_SidePlate	
						PROJECT ZZZZZZZZ			
Application		DO NOT SCALE DRAWING				WEIGHT		SIZE B	DWG. NO. 100XXWDWG
								SCALE 1:5	CAD FILE: MECH ENG ON TORNADO
								SHEET 1	OF 1