


MATERIALS/COMPONENTS FOR ONE UNIT			
QTY	REF	DESCRIPTION	MANUFACTURER
1	1	PEN. SHELL	C-10557 ISE
1	2	INSERT	B-10577 ISE
1	3	BACKSHELL	C-10556 ISE
1	4	O-RING	2-008 PARKER
2	5	O-RING	2-123 PARKER
4	6	SKT HD SCREW	8-32UNC X 1/2 316SS
4	7	LOCK WASHER	#8 316SS
1	8	PORT SCREW	B-11643 ISE
2	9	HOSE FITTING	0503-8-6C HYSECO
1	10	45° FITTING	3703-6-6C HYSECO
1	11	BRAIDED HOSE	G157-06 X 10' / GREENLINE G4005-SS-06-06 (BOTH ENDS)
△ 1 12 REDUCER SS-6410-12-8 TOMPAKINS or EQUAL			
△ 57 13 TEFLON TUBE TFT-200-17 ECS or EQUAL			
△ 1 14 OPTIC FIBER SM 900 MICRON ADC. or EQUAL			
12 15 ST CONNECTOR FI-0069 FIS			
57 16 FURCATION TUBING FOOFR3RO FIS			

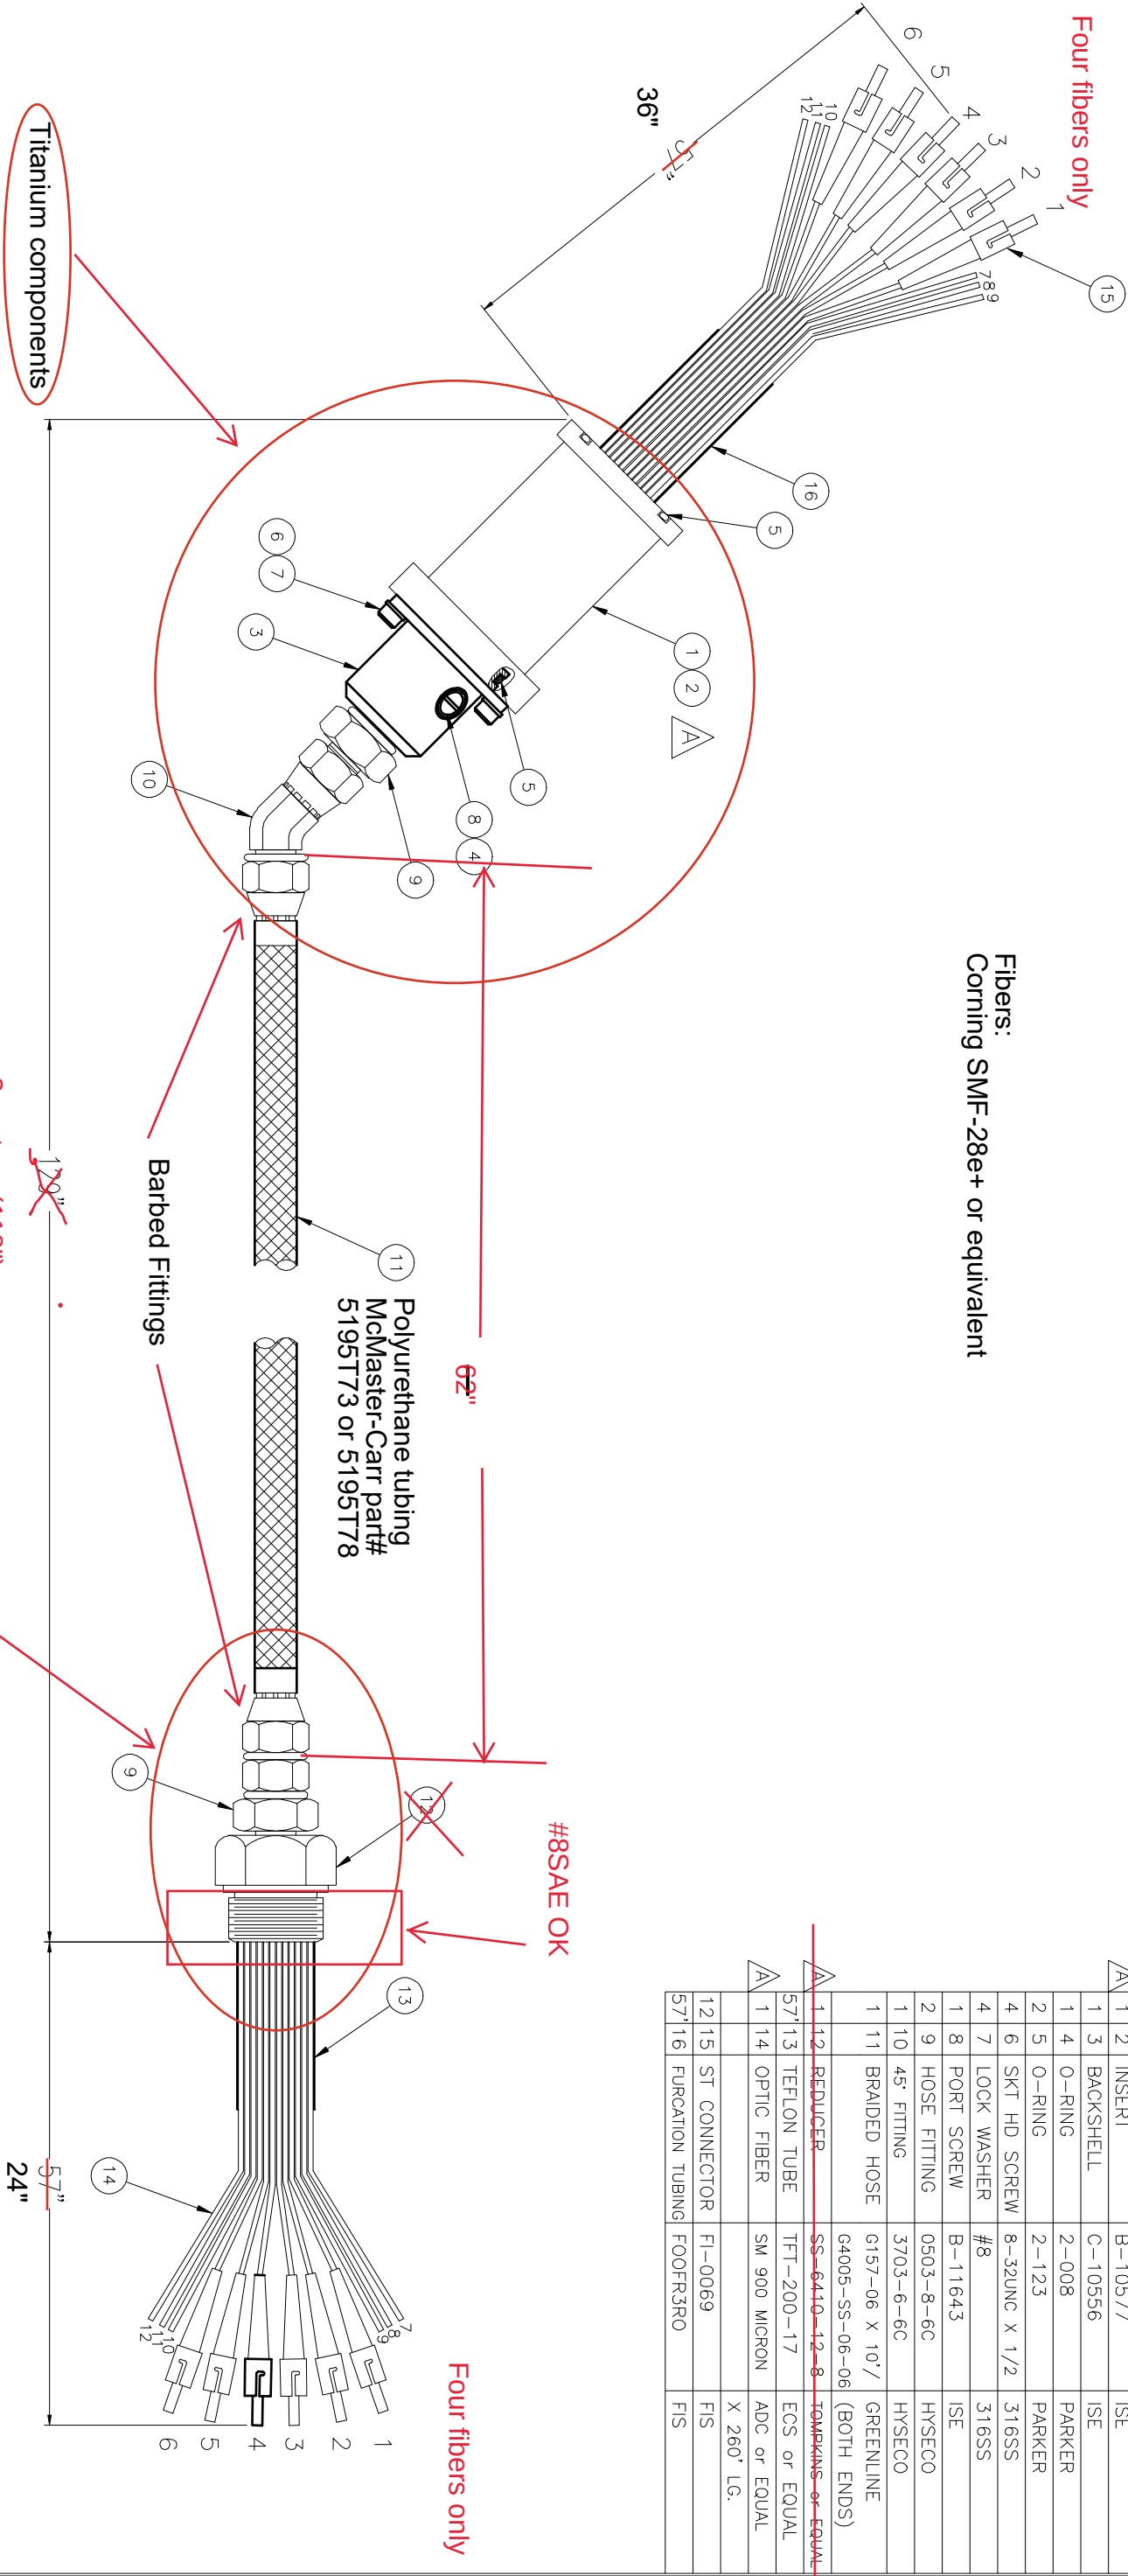

THIS DRAWING MAY REVEAL DESIGNS OR INFORMATION PROPRIETARY TO I.S.E. BY ACCEPTANCE OF A REPRODUCTION RECIPIENTS AGREE TO PROTECT I.S.E.'S RIGHTS AND ARE WARNED AGAINST USE OF THE DOCUMENT FOR ANY PURPOSE OTHER THAN THAT FOR WHICH IT WAS TENDERED				NOTICE:		
		Y/M/D		DSN	PL	02/05/10
				DRN	JO	02/05/16
				CHK	RS	02/05/21
				APV	JS	02/05/21
PROJECT: OCEANEERING				PROJECT #:		
TITLE: FIBRE—OPTIC CABLE ASSEMBLY						



NEXT ASSY DWG.		SCALE	DWG.No./PART No.	REV
		NTS	B-17732	1 of 1 - A