
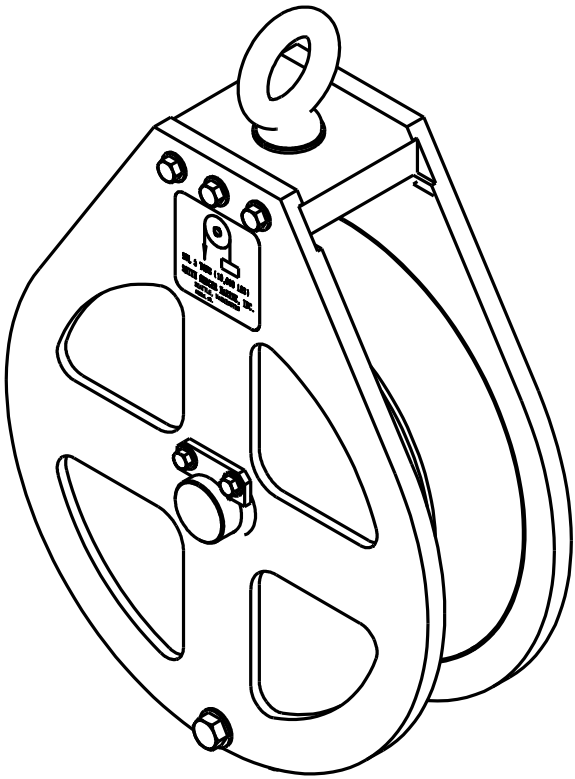


SPECIFICATIONS AND NOTES (UNLESS OTHERWISE SPECIFIED):

1. MAXIMUM SWL OF 5 TONS (10,000 LBS) AT 180° WRAP
WITH 5 TO 1 FACTOR SAFETY.

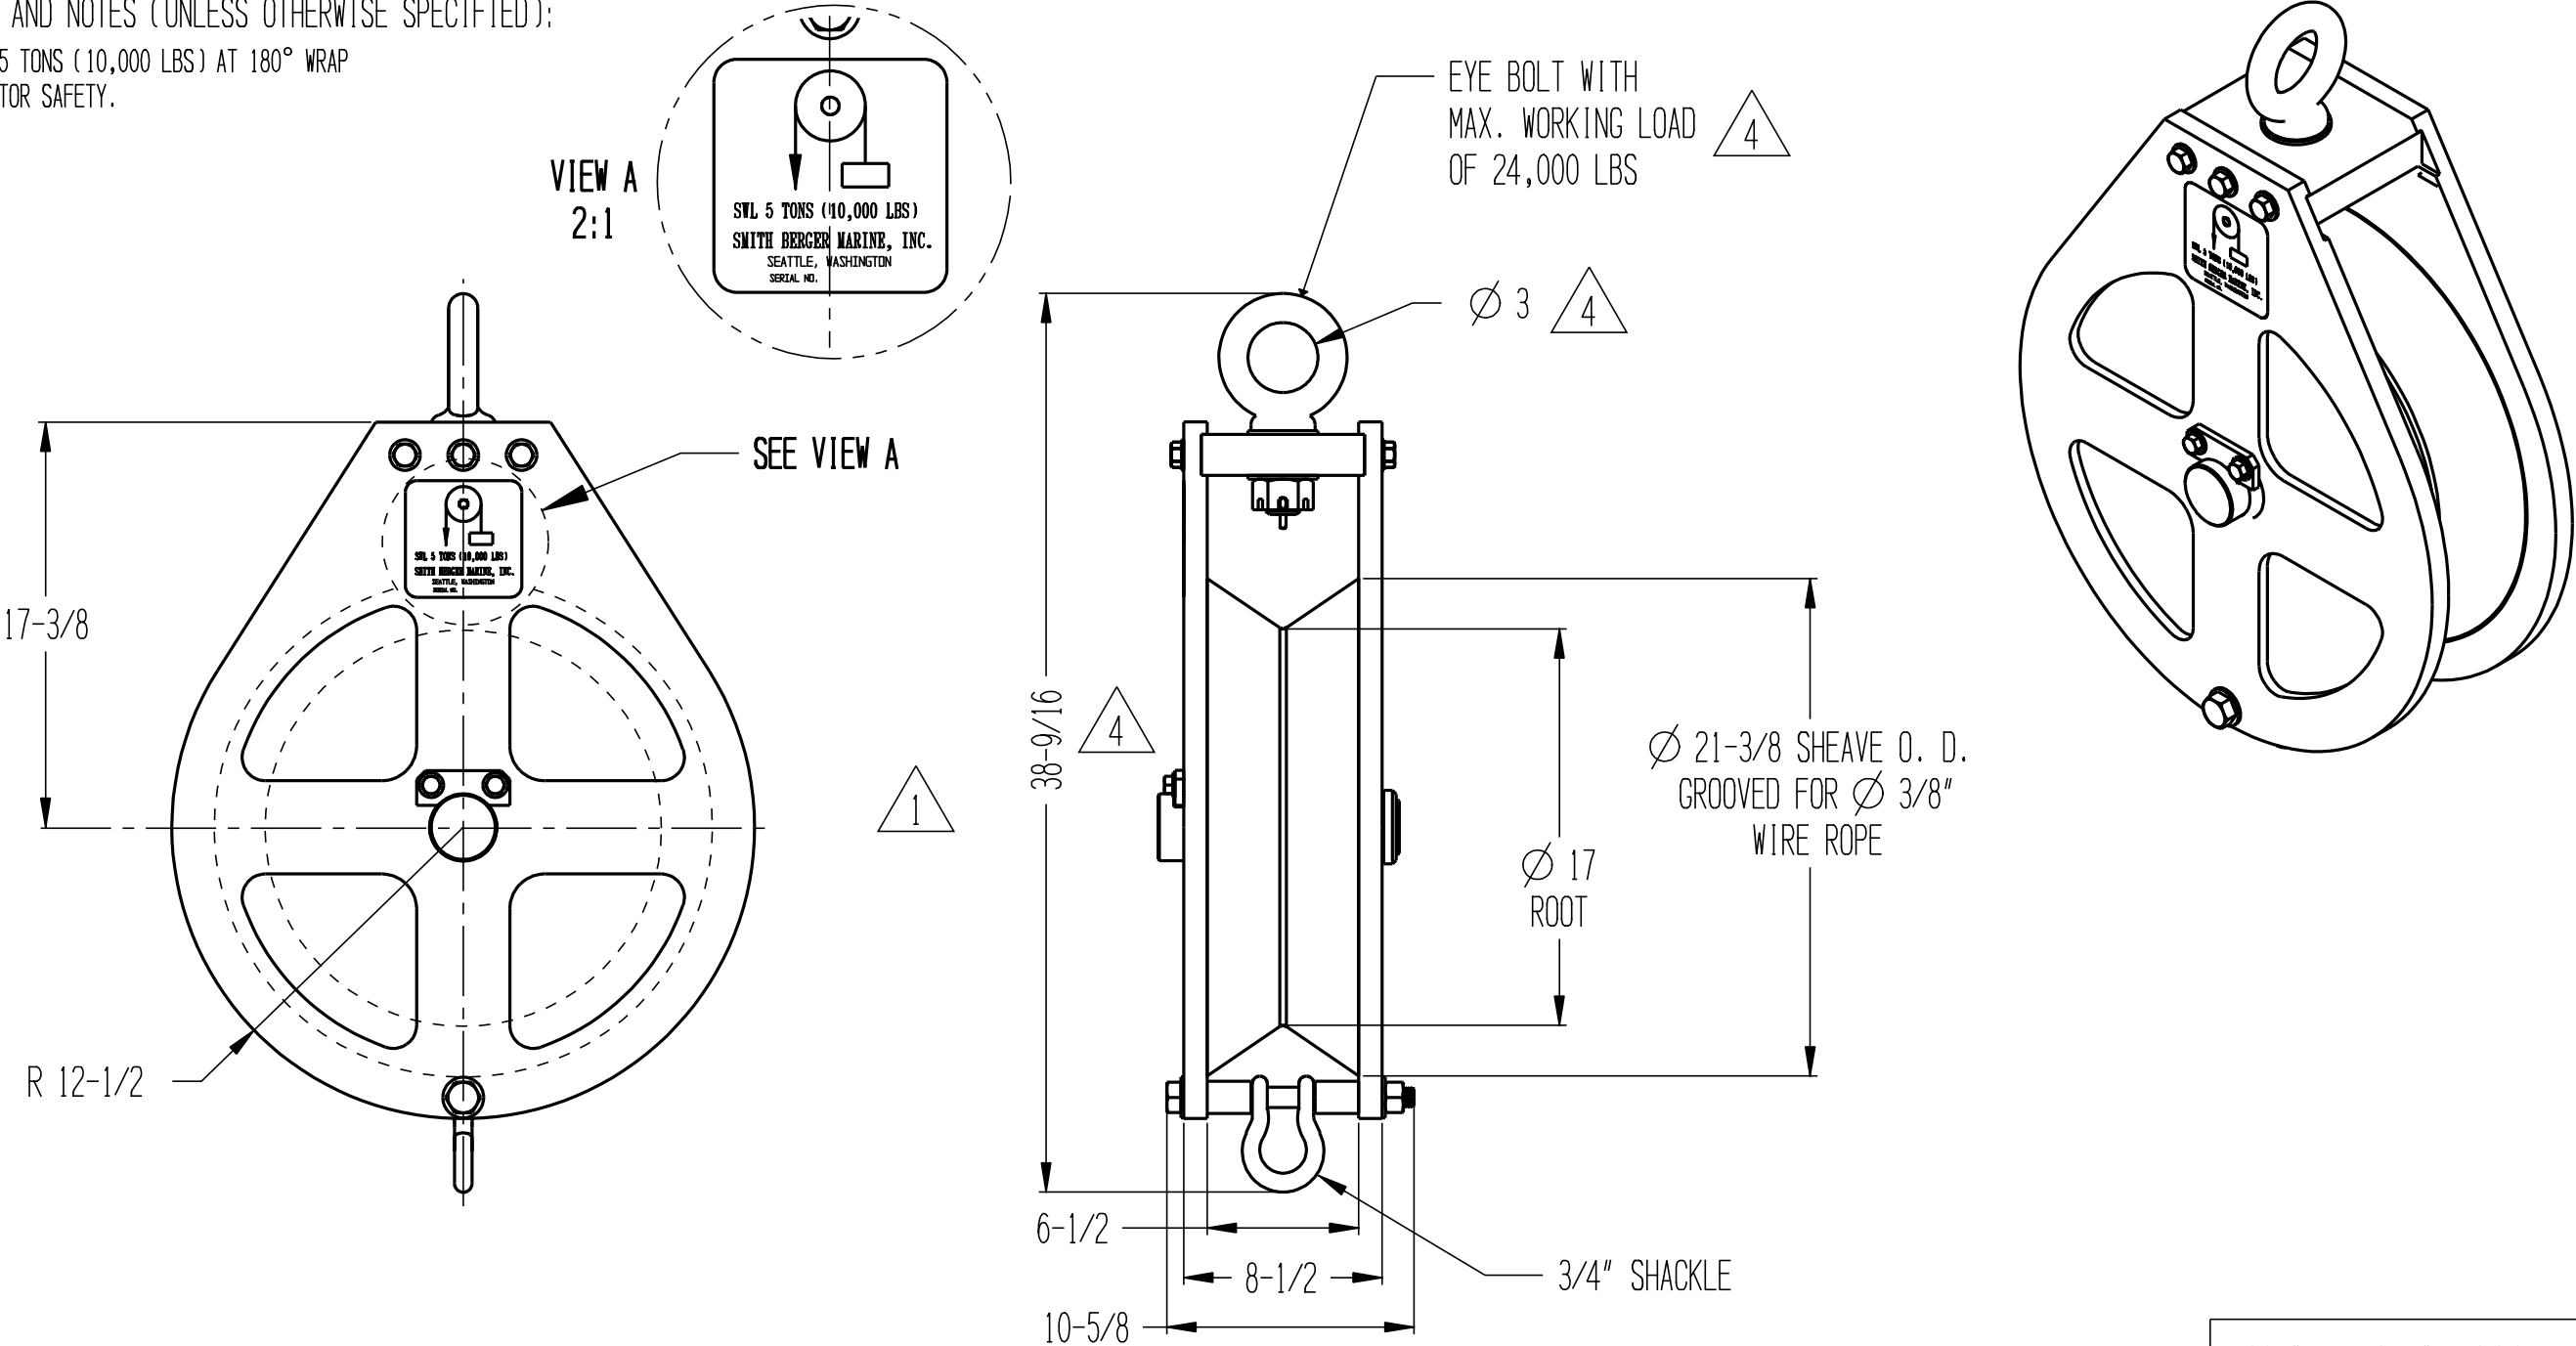

FOR WORKING

PROPRIETARY	This document is the sole property of Smith Berger Marine Inc. and contains confidential and proprietary information. No reproduction, disclosure to third parties, or other use of this document is permitted without the express written consent of Smith Berger Marine. Document must be returned on request.			FRACTIONS ± 1/16		TOLERANCES DECIMALS .xx ± .030 .xxx ± .010		ANGLES ± 1°					Smith Berger Marine, Inc. Seattle, Wa.									
				INTERPRET DIMENSIONS PER ANSI Y14.5M-1982						4	04-20-11	3 WAS 2-1/2, 24000 LBS WAS 26000, 38-9/16 WAS 38-5/8	SJ	GENERAL ARRANGEMENT								
				MAT'L -						3	04-19-11	ADDED FOR WORKING, GENERAL REVISION	SJ									
										2	03-23-11	TONS WAS Kg, 240 LBS WAS 340 LBS	PJ	MODEL 22-HB BLOCK								
										1	03-17-11	GENERAL REVISION	PJ									
										NO.	DATE	REVISIONS		BY	DRAWN BY	PAP	SCALE	.125	DRAWING NO.	SH. NO.		
USED ON			C61234													CHECKED BY		DATE	10/21/10	B61064	1 1	
			NEXT ASSY.	RGH. WT.		FIN. WT.	240 LBS															