

	1	2	3	4	5	6	7	8
A	=GENERAL							


Customer : CNP Freire
Ship/Hull : MBARI
Project no. : 4/60185
Drawing no.: E-4500


Customer : CNP Freire
Ship/Hull : MBARI
Project no. : 4/60185
Drawing no.: E-4500

[illegible]

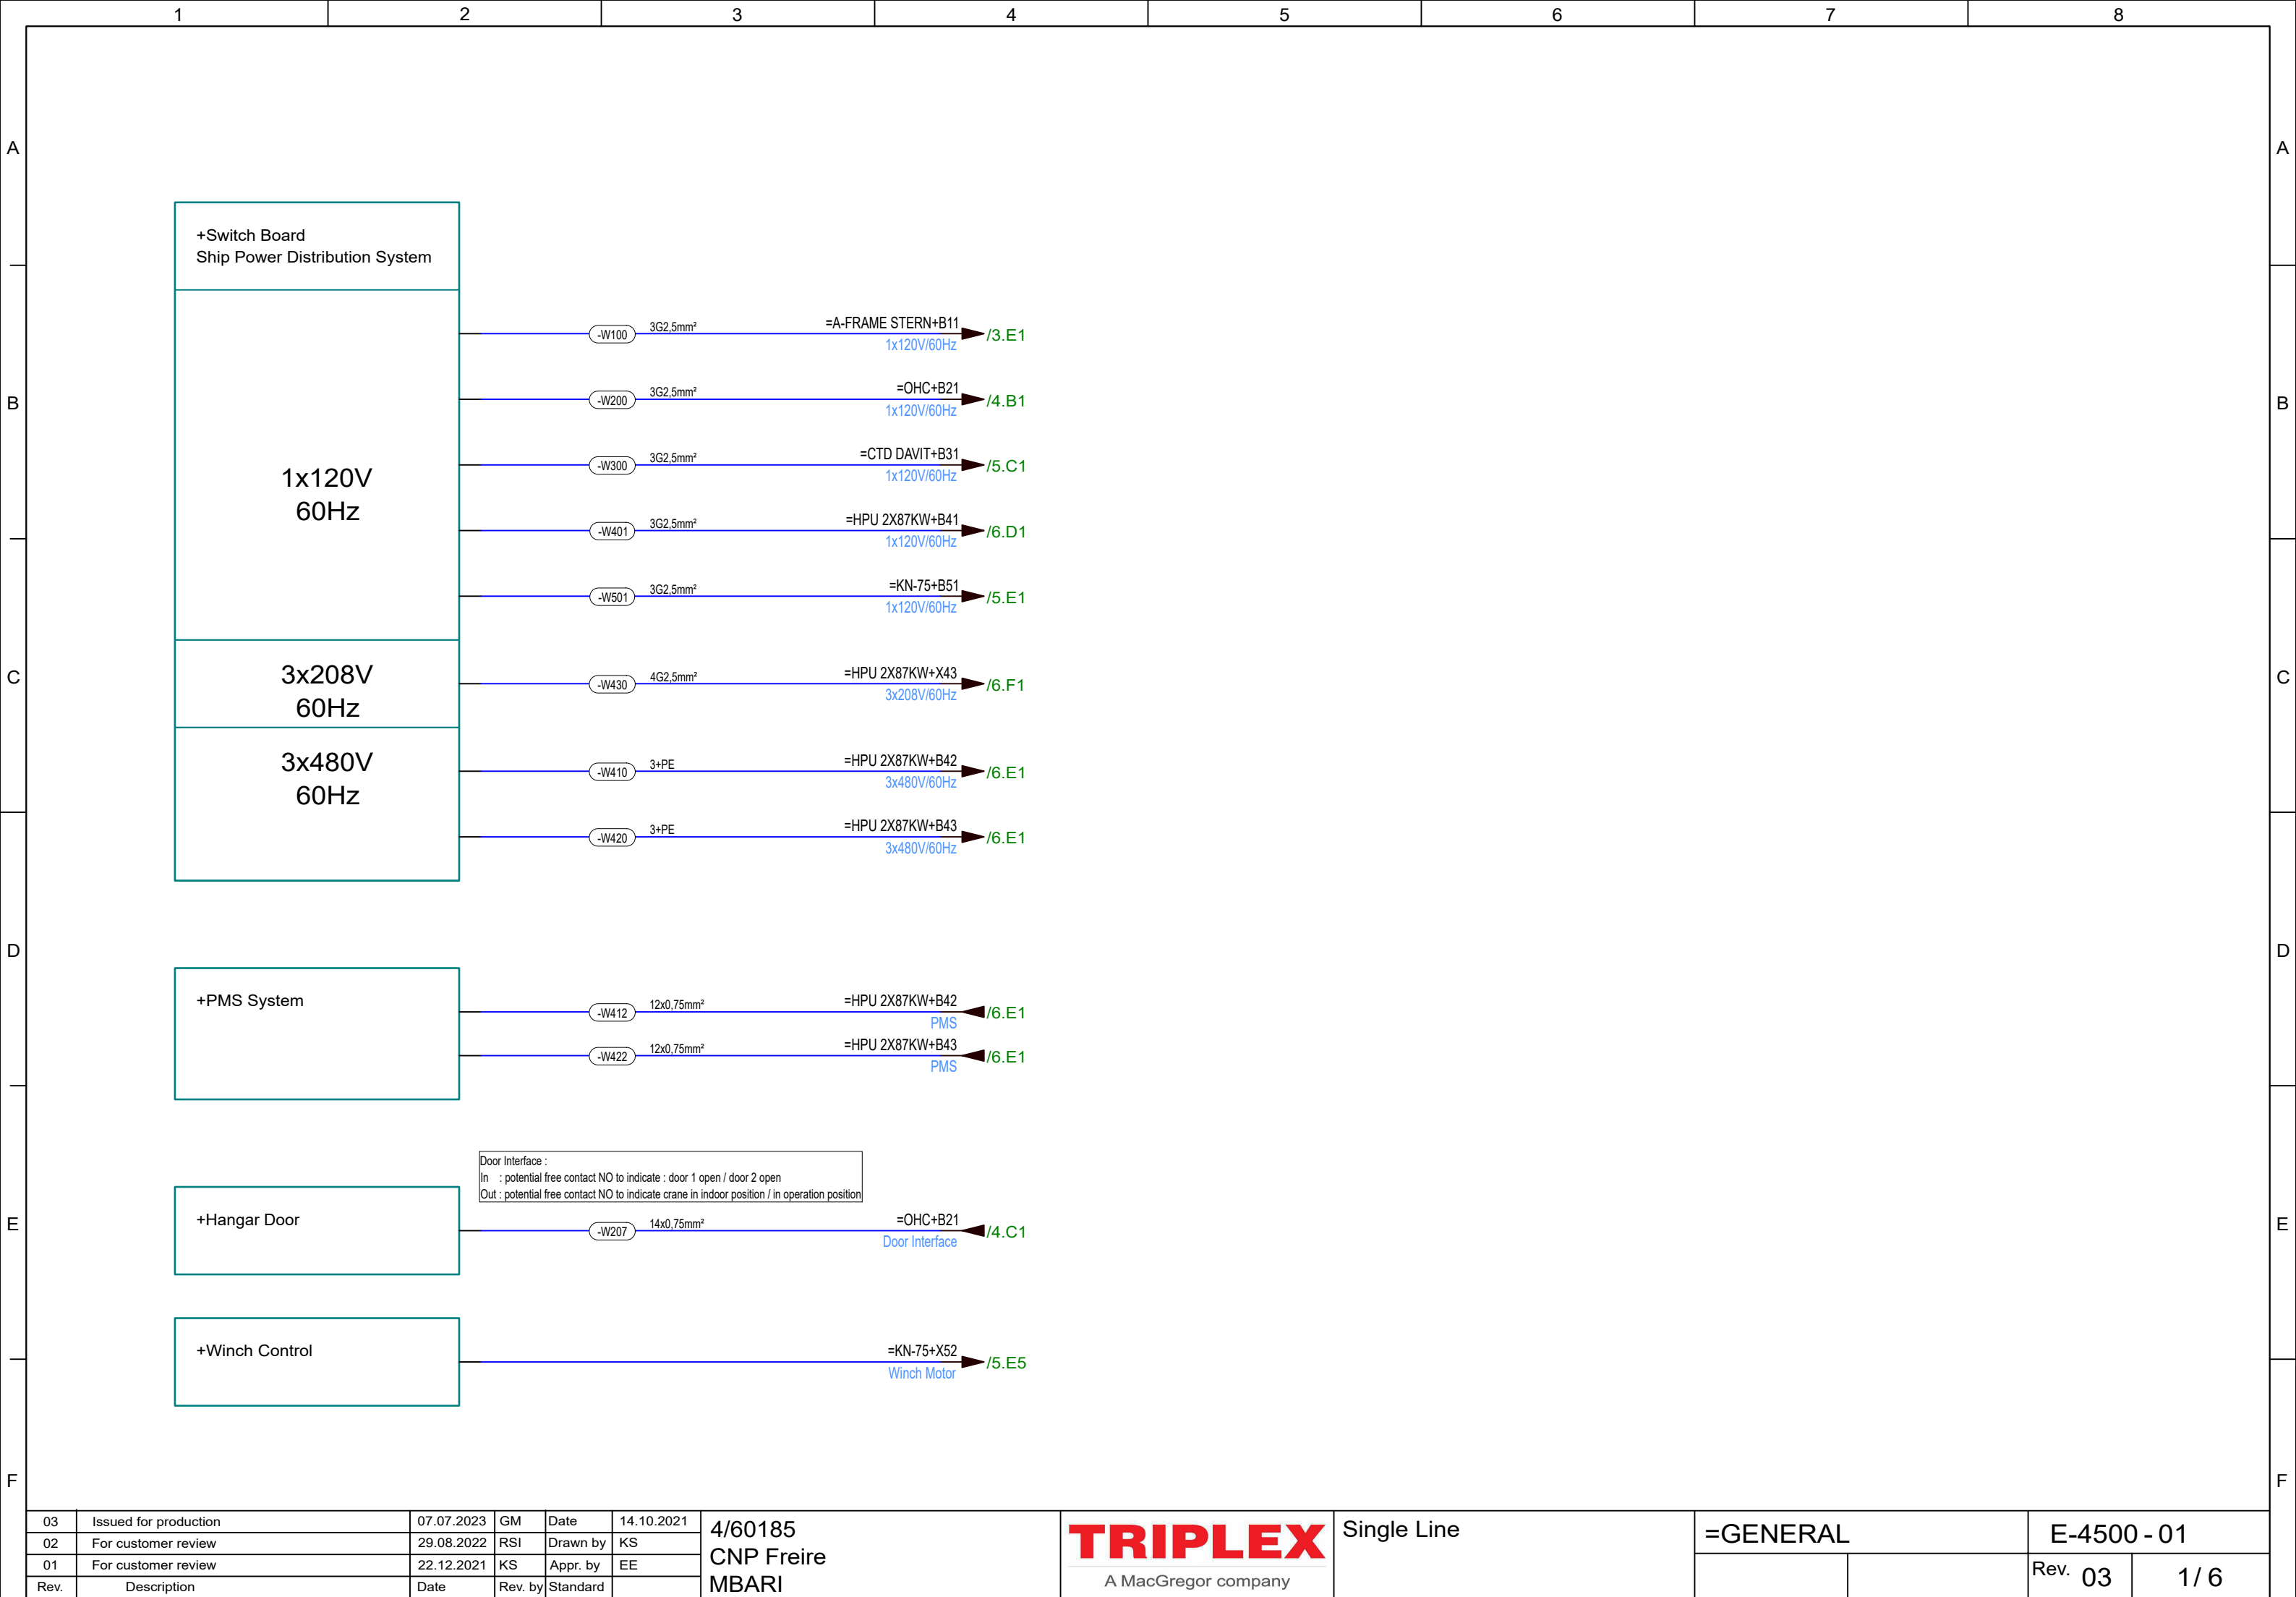


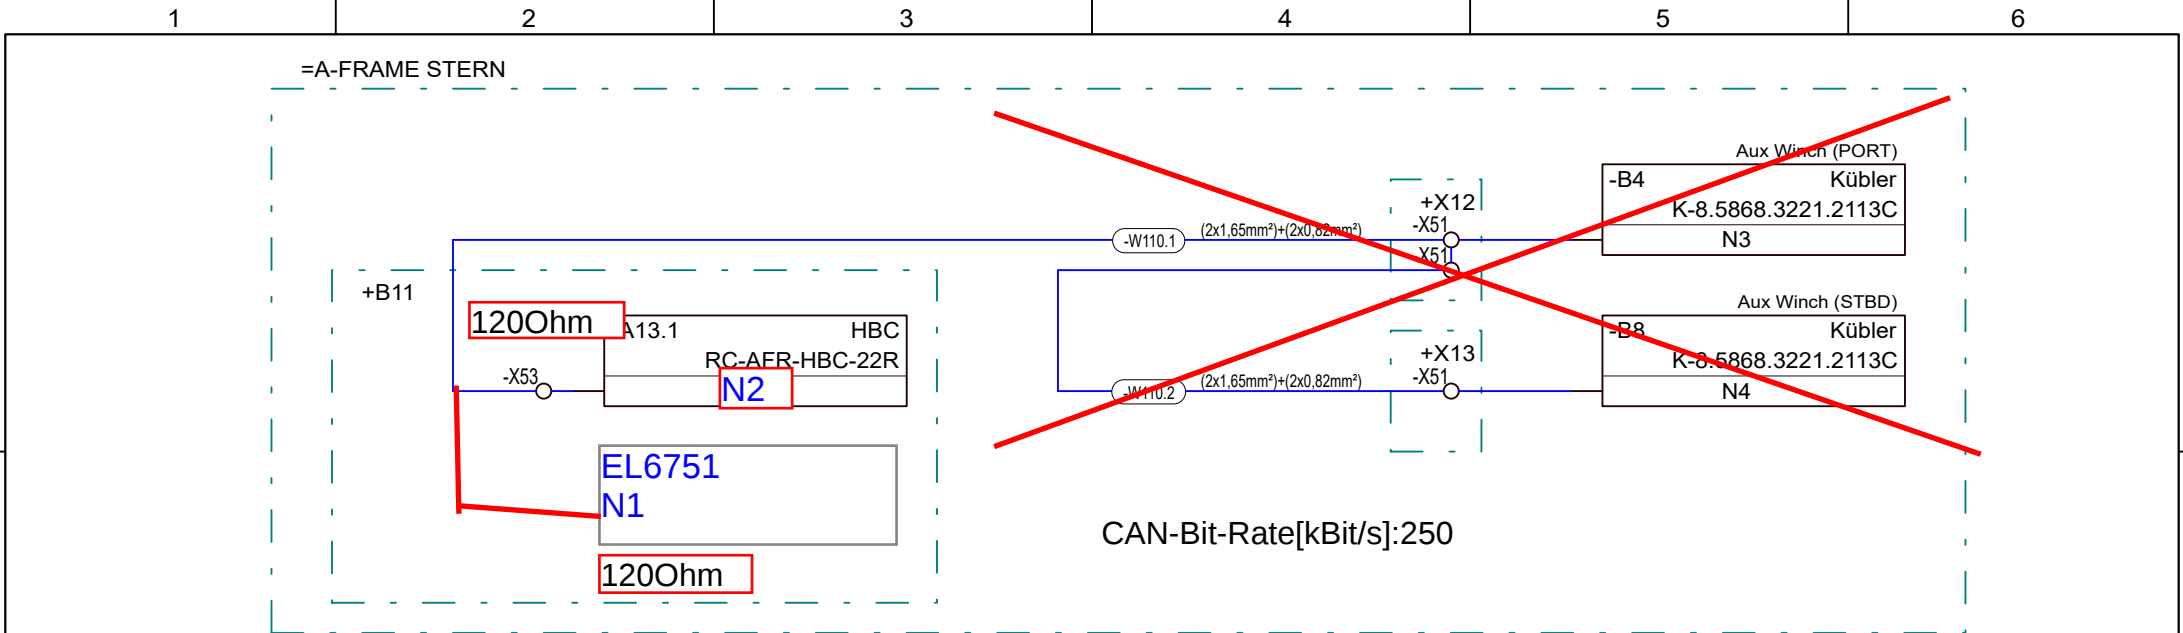


OHC ROV LARS

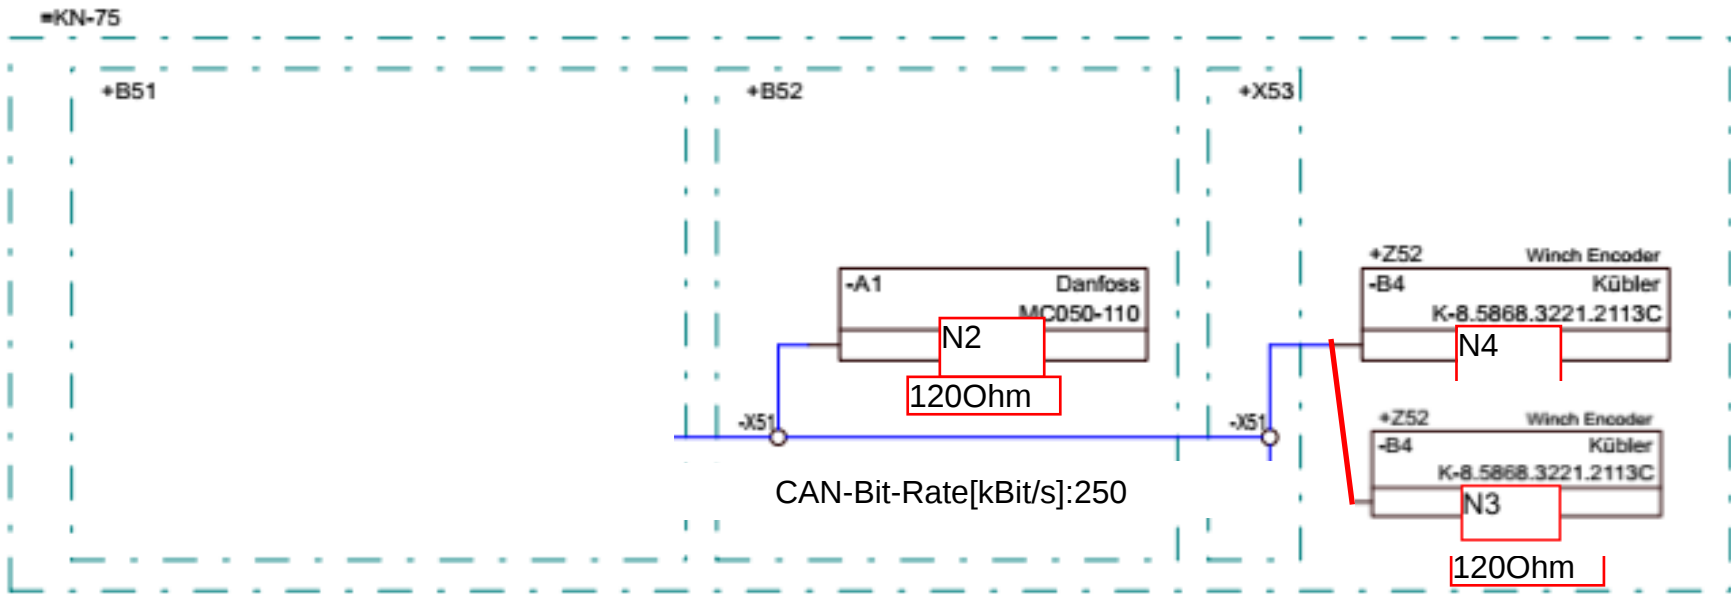

4/60185 CNP Freire MBARI				TRIPLEX A MacGregor company		BUS			
03	Issued for production	07.07.2023	GM	Date	14.10.2021	=GENERAL		E-4500 - 01	
02	For customer review	29.08.2022	RSI	Drawn by	KS				
01	For customer review	22.12.2021	KS	Appr. by	EE			Rev. 03	2 / 6
Rev.	Description	Date	Rev. by	Standard					

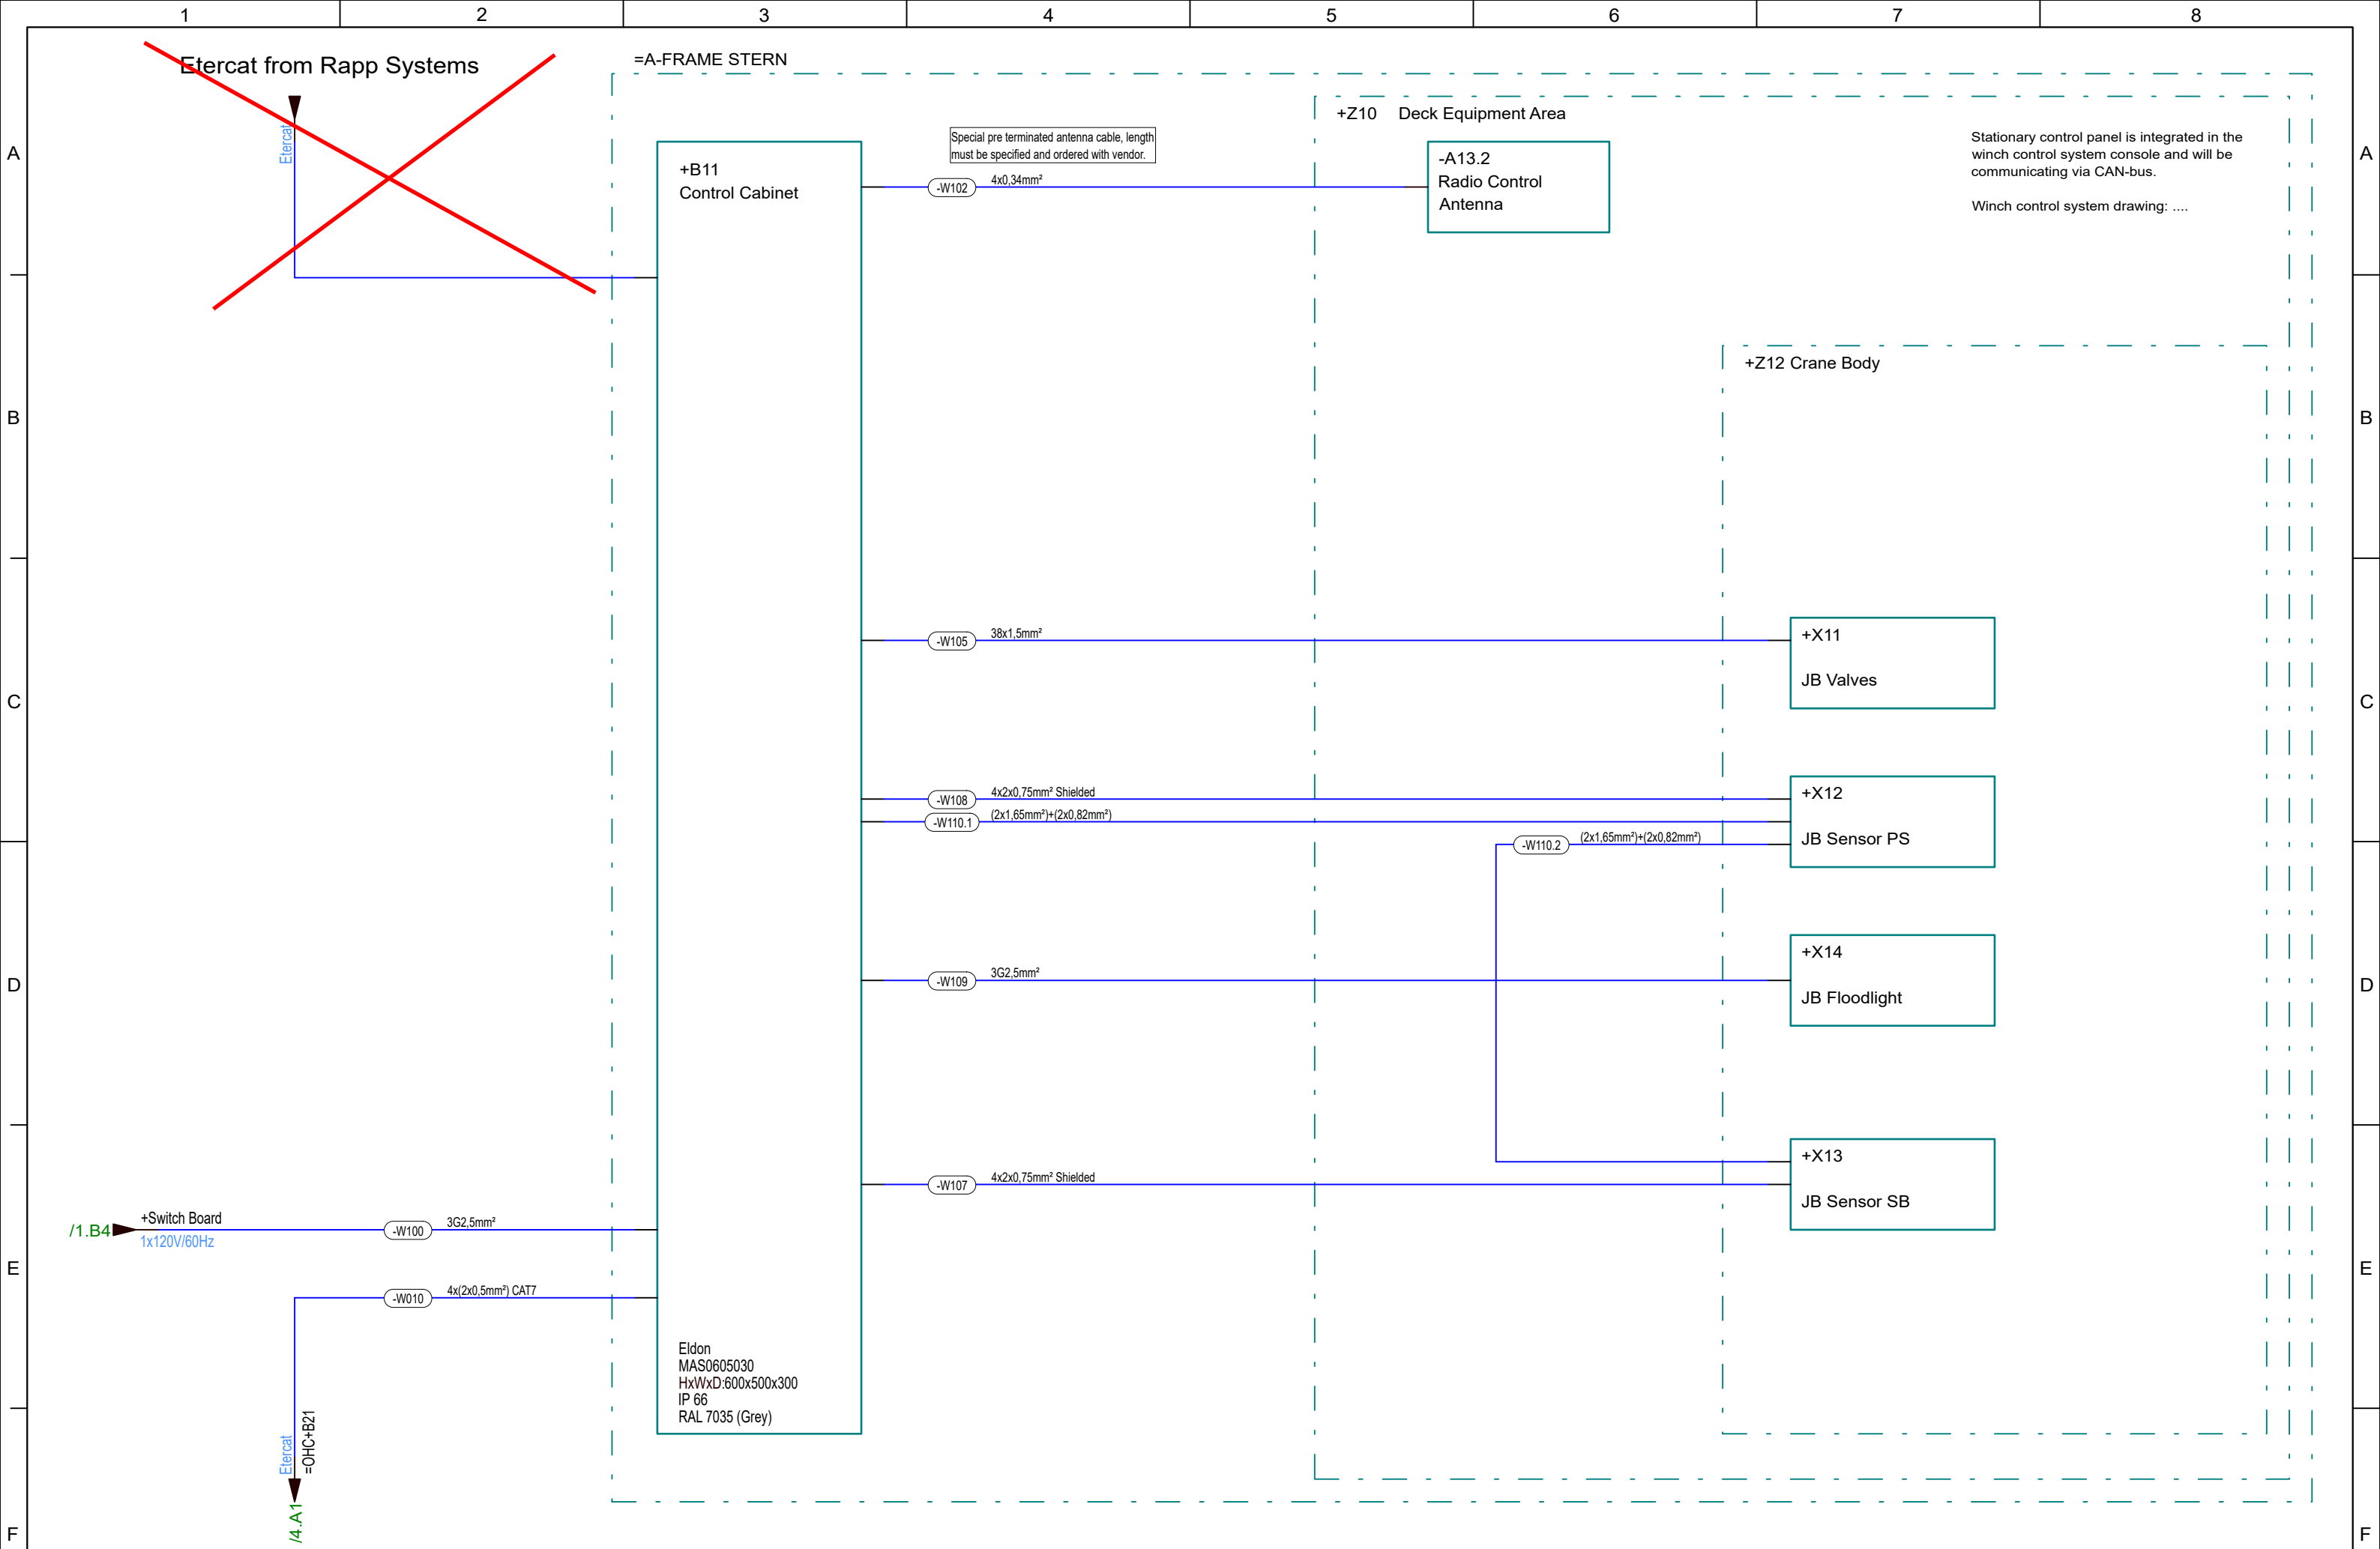

03	Issued for production	07.07.2023	GM	Date	14.10.2021	4/60185 CNP Freire MBARI	TRIPLEX A MacGregor company	Single Line A-Frame	=GENERAL		E-4500 - 01	
02	For customer review	29.08.2022	RSI	Drawn by	KS							
01	For customer review	22.12.2021	KS	Appr. by	EE							
Rev.	Description	Date	Rev. by	Standard								

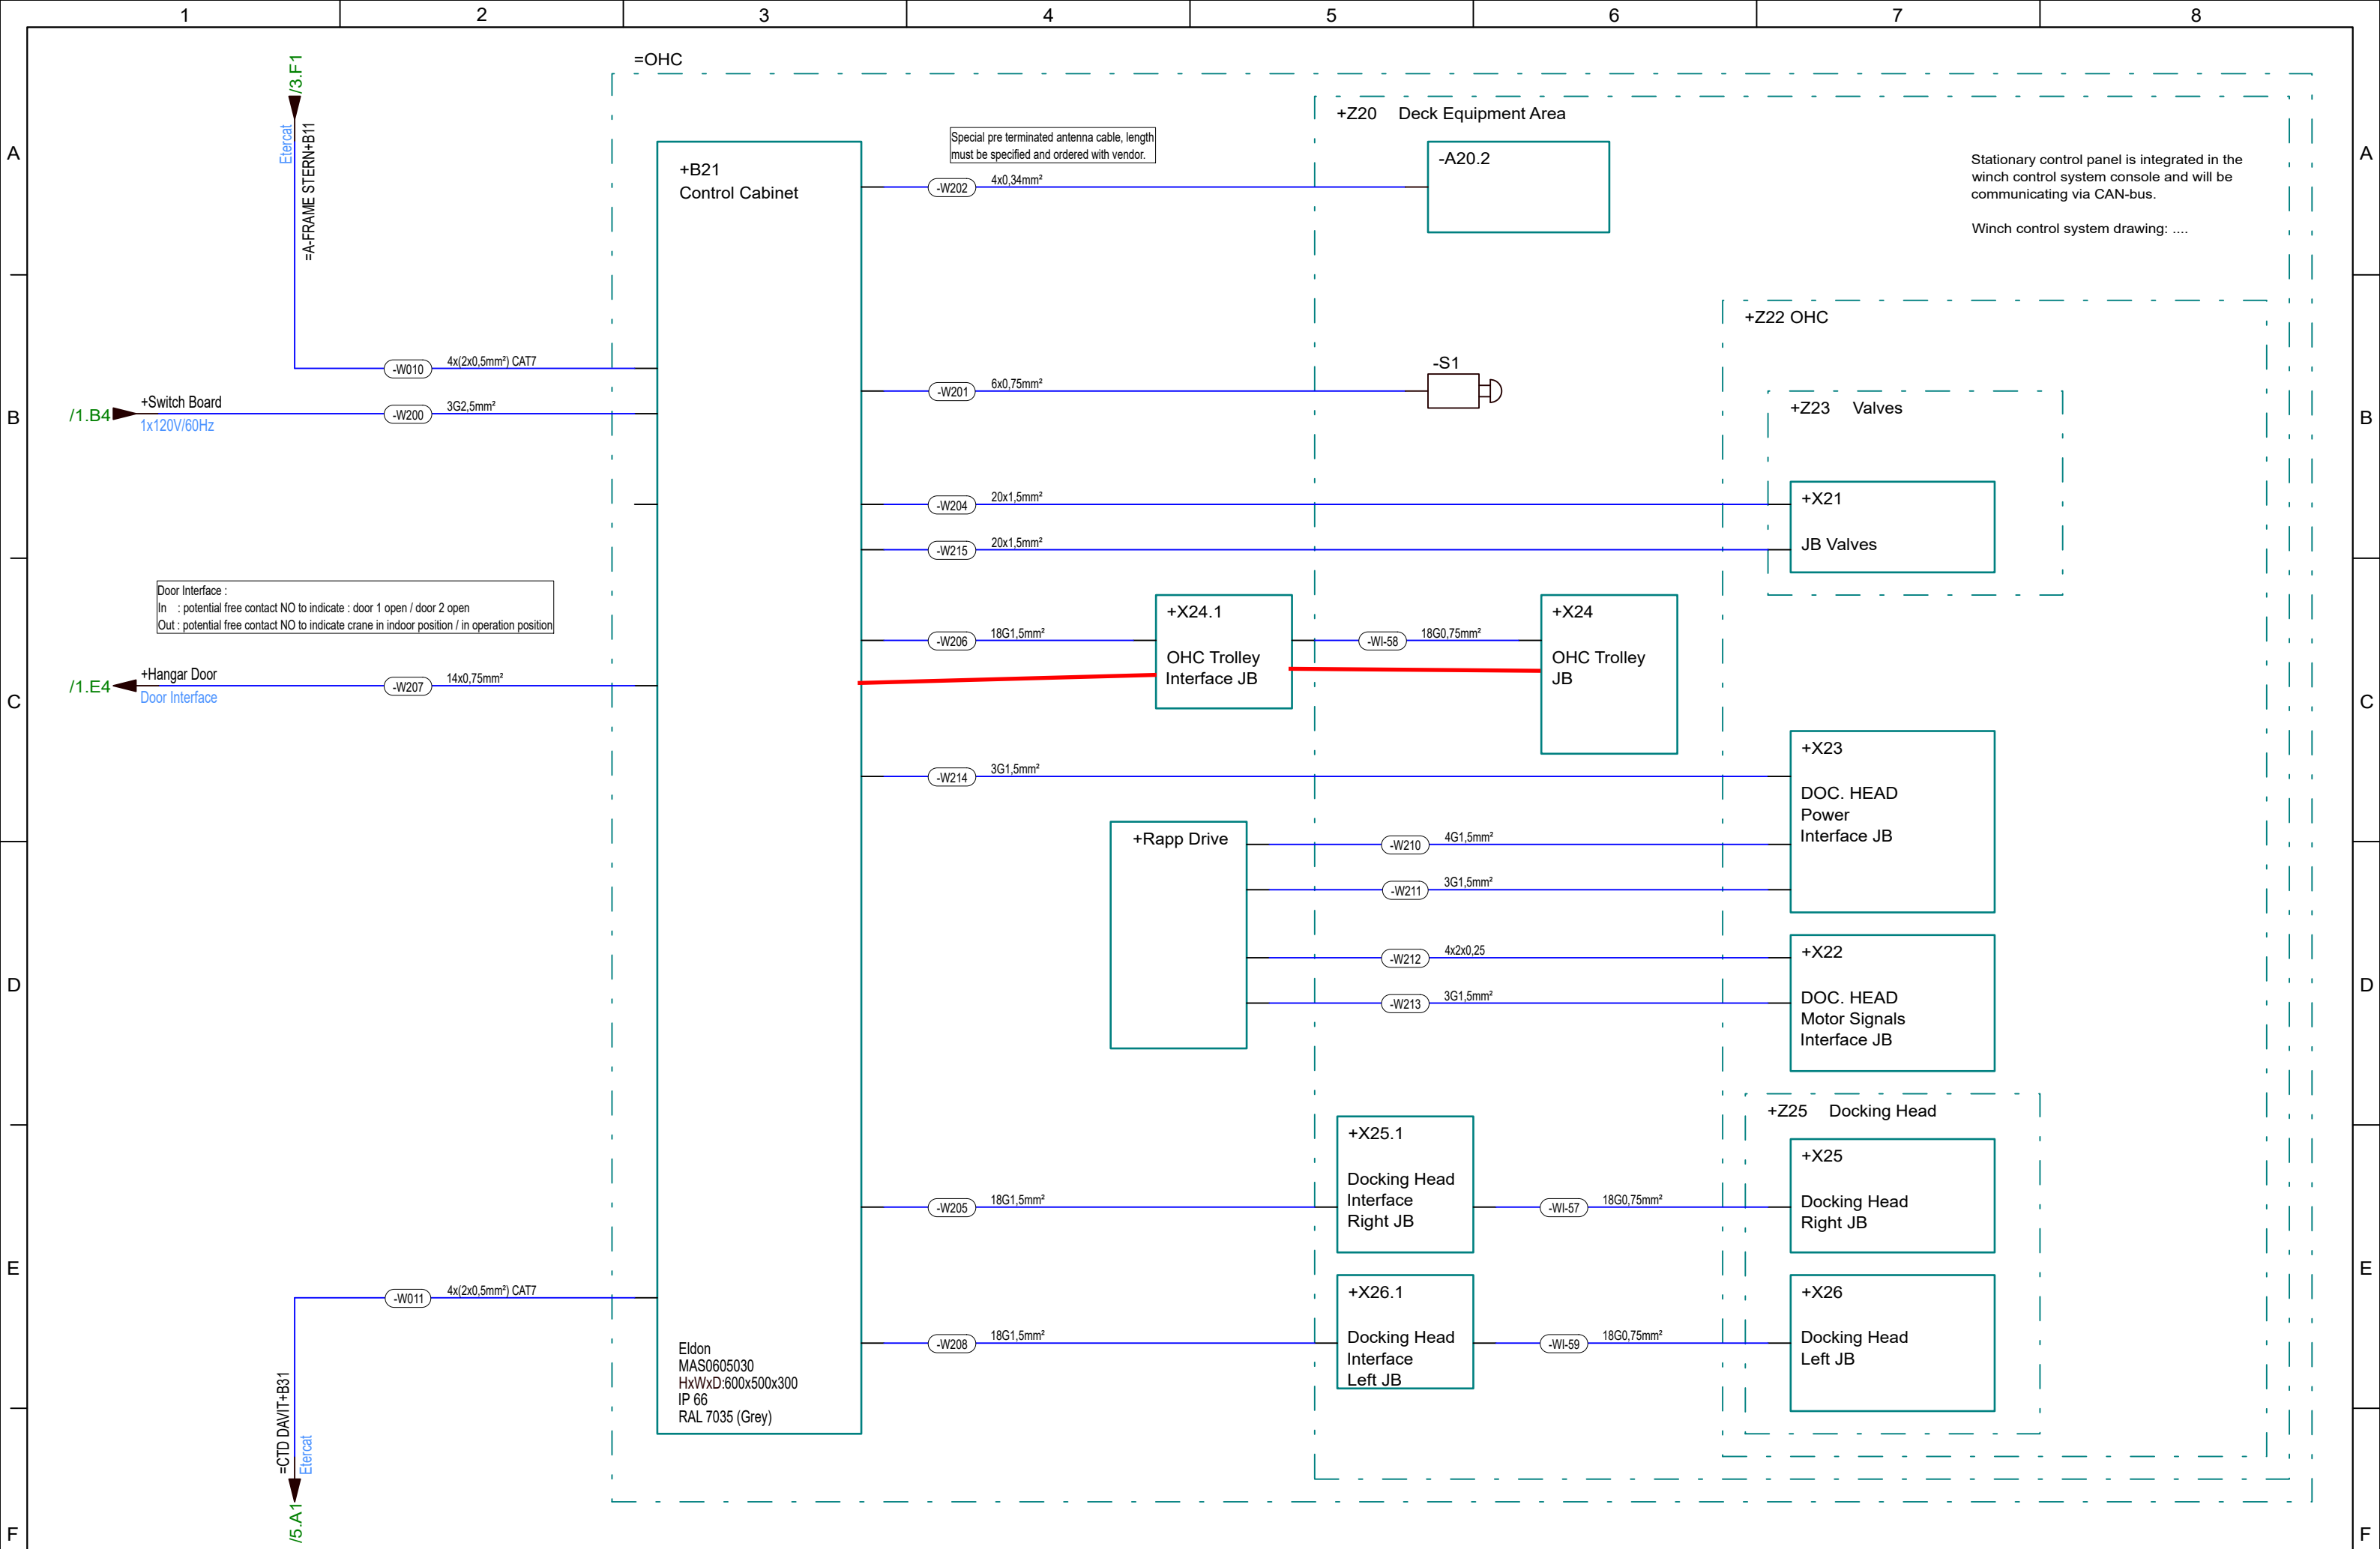

03	Issued for production	07.07.2023	GM	Date	14.10.2021
02	For customer review	29.08.2022	RSI	Drawn by	KS
01	For customer review	22.12.2021	KS	Appr. by	EE
Rev.	Description	Date	Rev. by	Standard	

4/60185
CNP Freire
MBARI

TRIPLEX
A MacGregor company


Single Line

=GENERAL

E-4500 - 01

Rev. 03

4 / 6

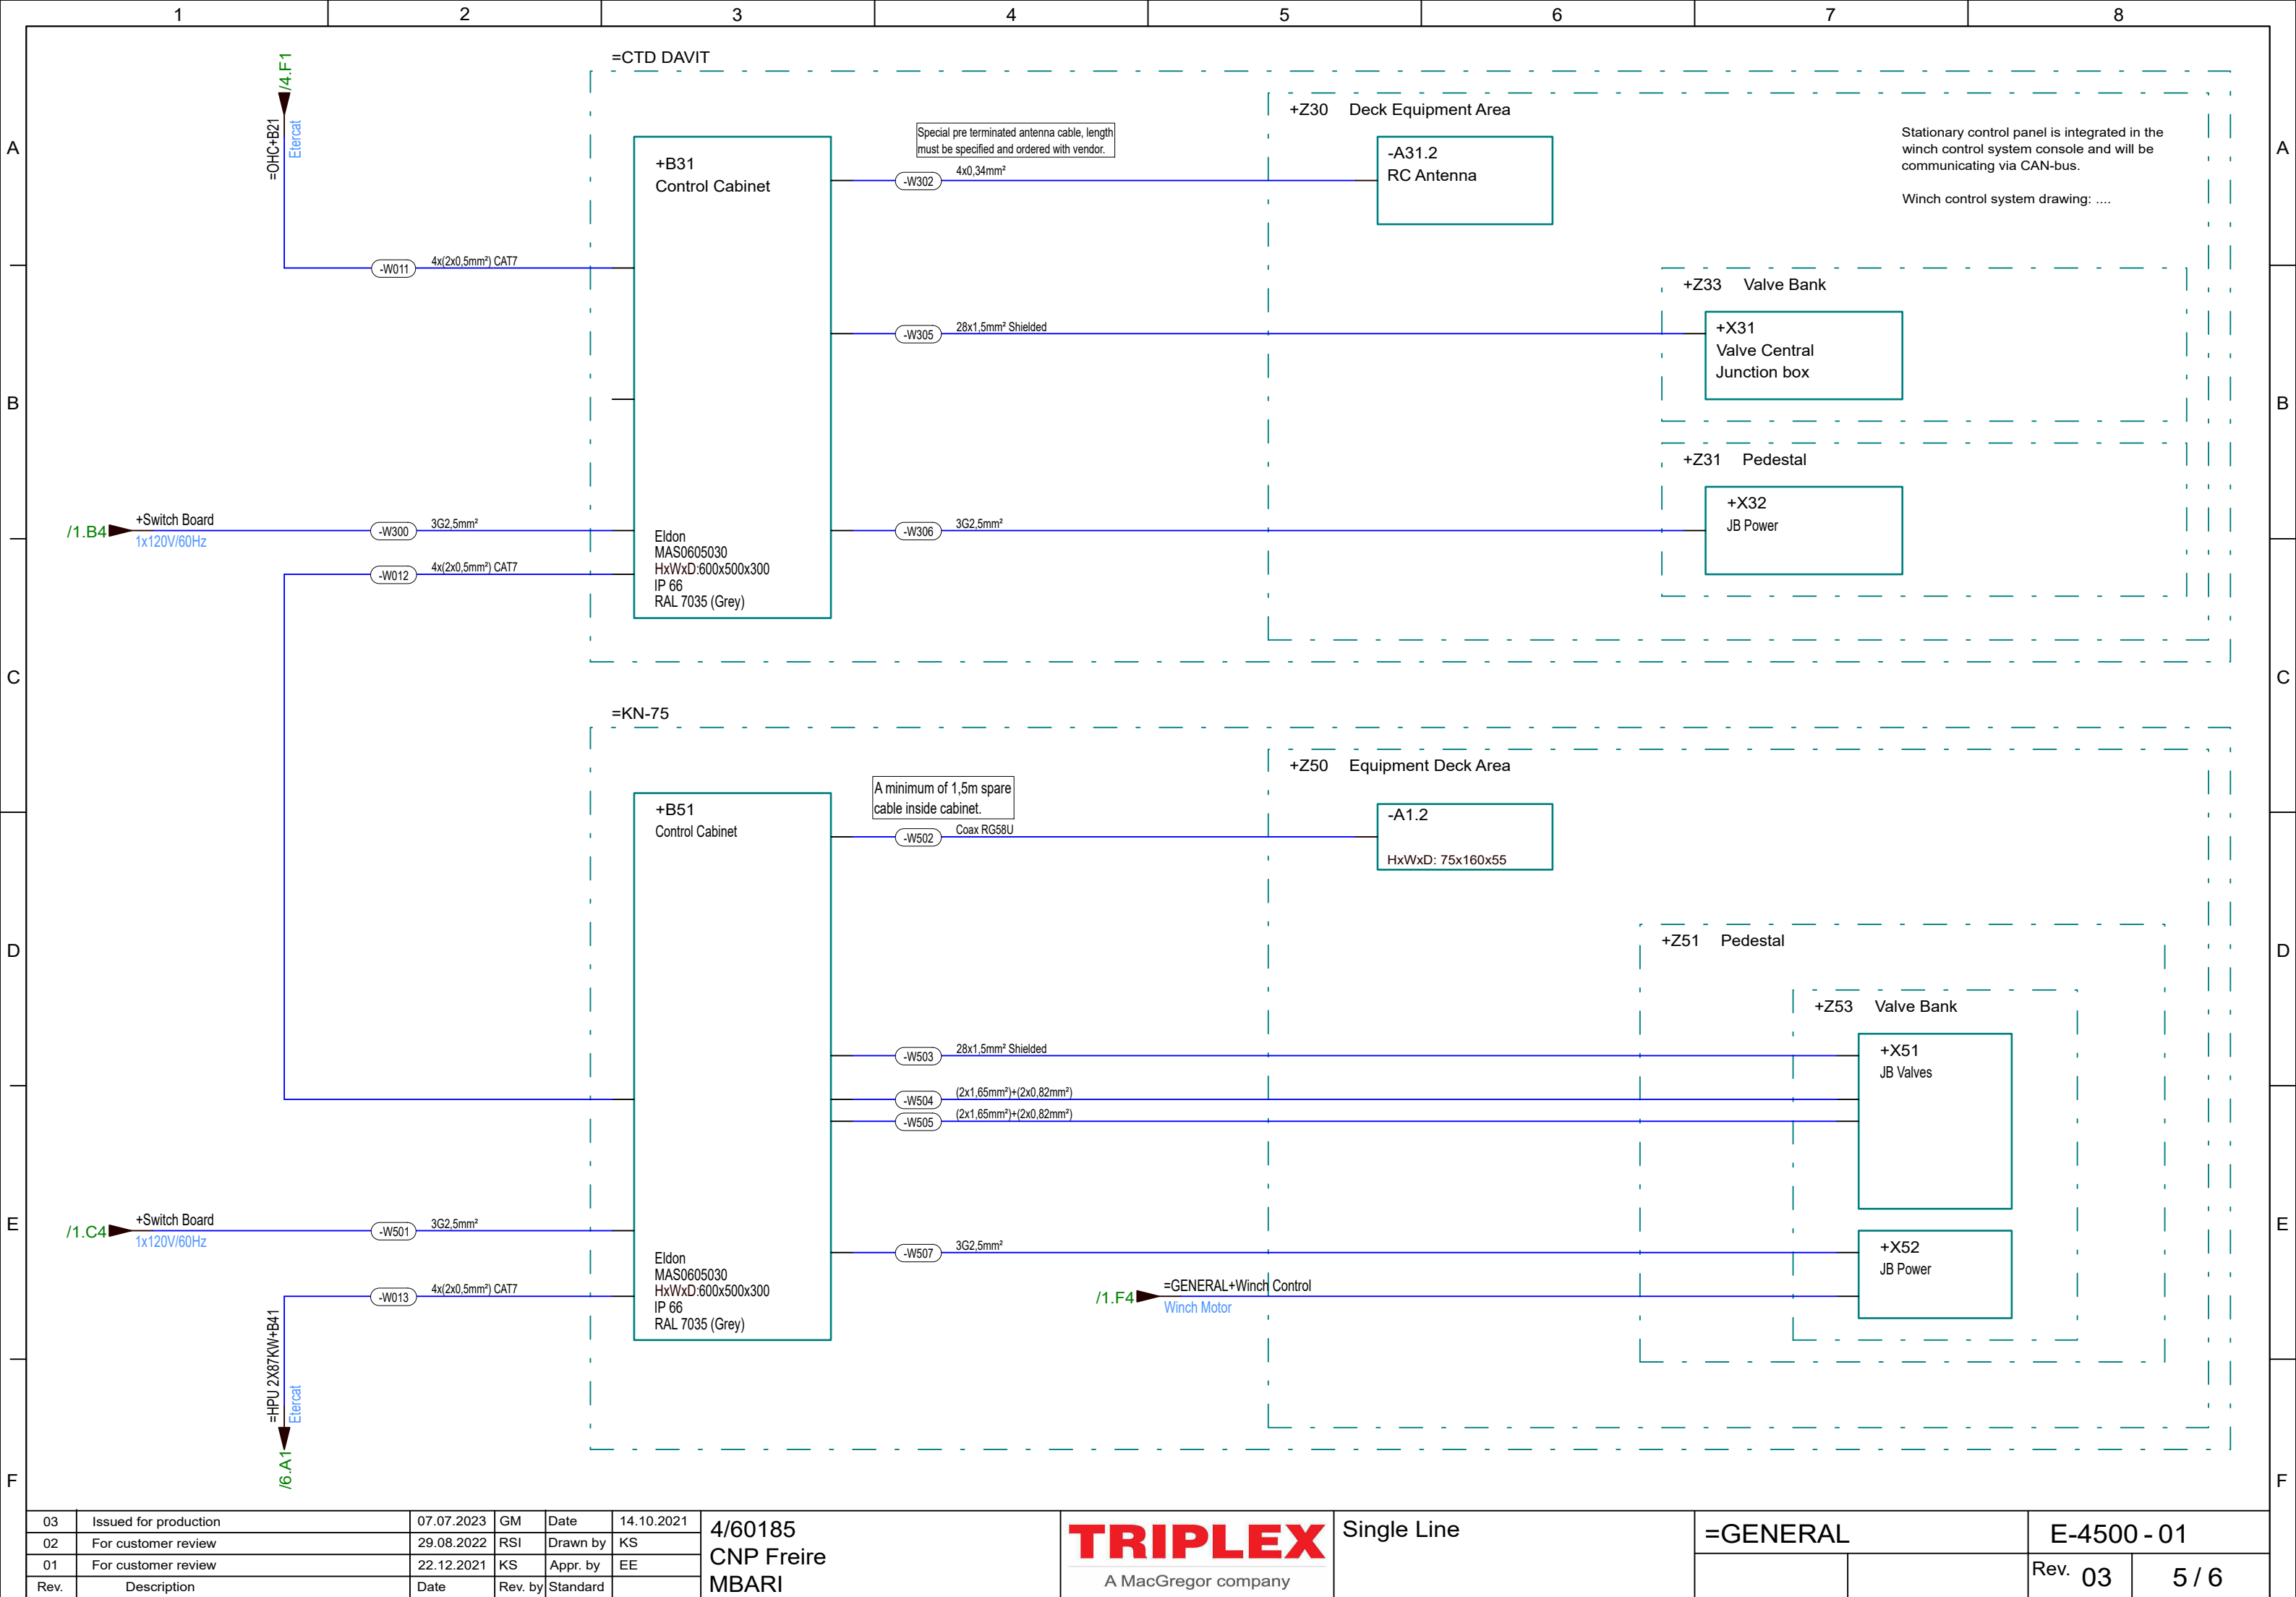

03	Issued for production	07.07.2023	GM	Date	14.10.2021
02	For customer review	29.08.2022	RSI	Drawn by	KS
01	For customer review	22.12.2021	KS	Appr. by	EE
Rev.	Description	Date	Rev. by	Standard	

4/60185
CNP Freire
MBARI



Single Line

=GENERAL

E-4500 - 01

Rev. 03 5 / 6

