





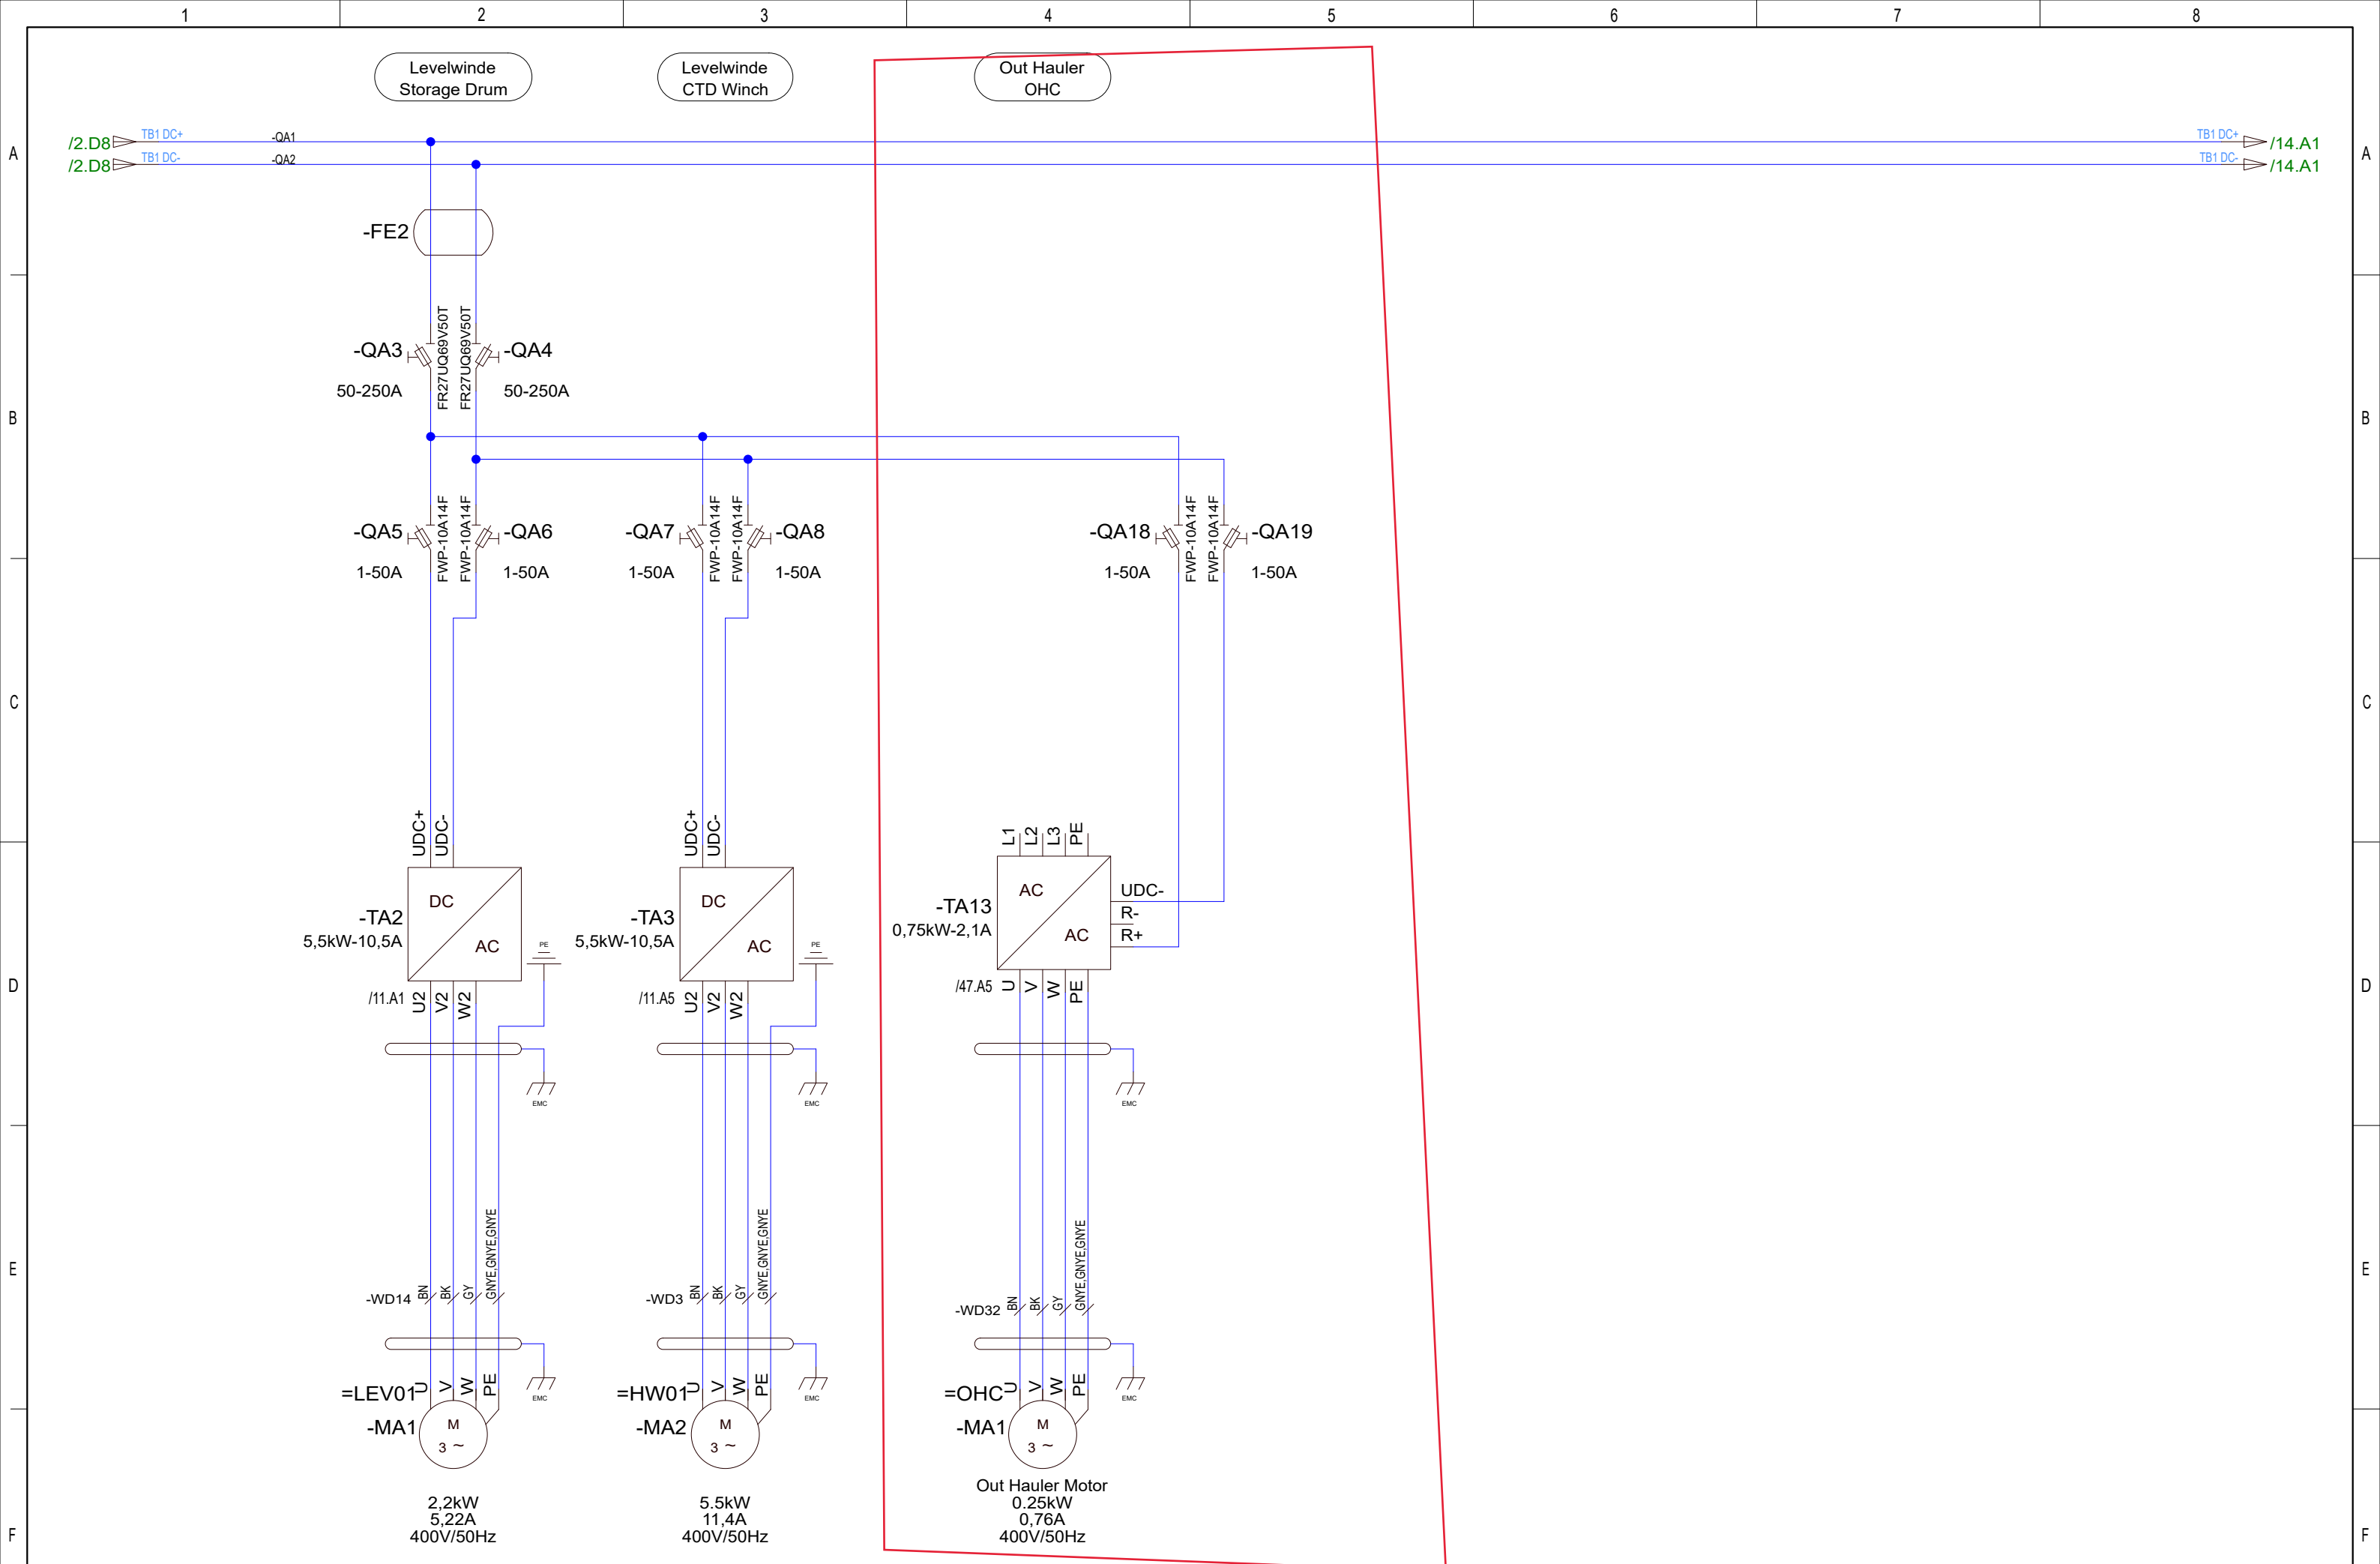


Date		17/11-2021		CNP Freire		Main VFD Cabinet Pentagon		400092375		=WCS01	
User		GSK		MBar		Levelwindes				+UH01	
Approved		RAJ		Version		Index		Repl. by		Rev.	
Status		AS BUILT		Date		Name		Standard		Sheet	
Change		19.08.2022		SS		Approved		RAJ		Next	

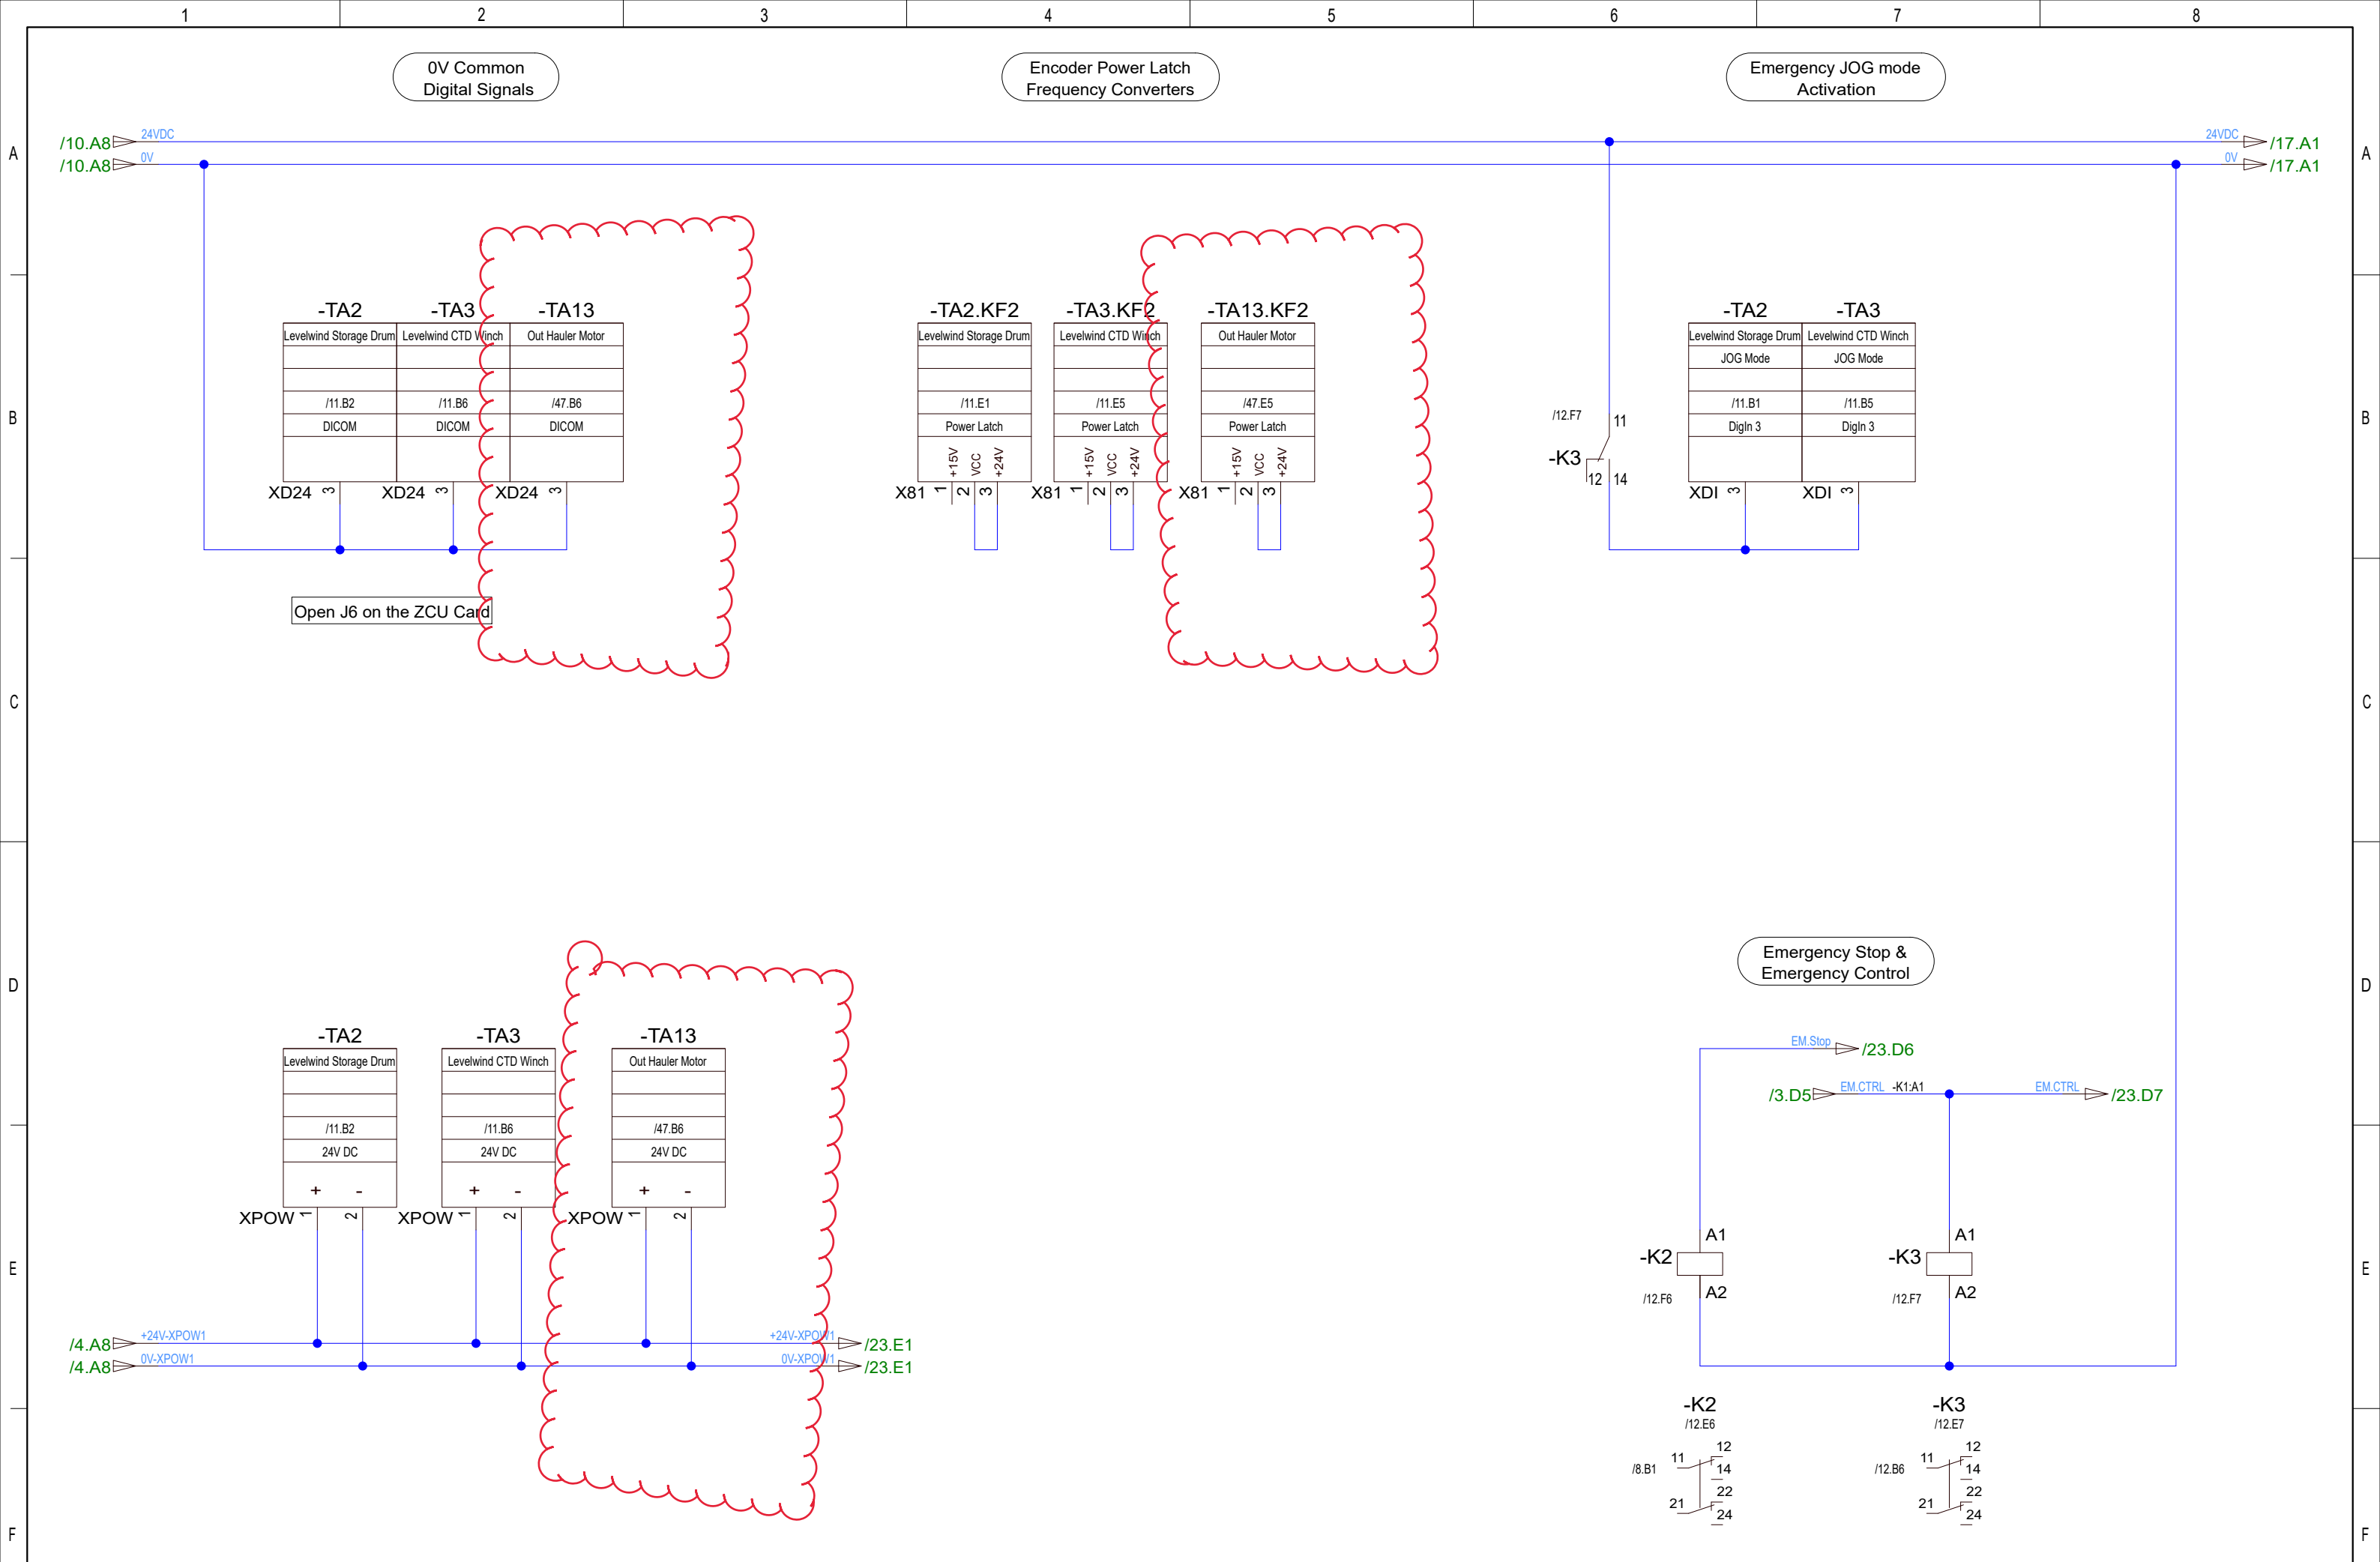

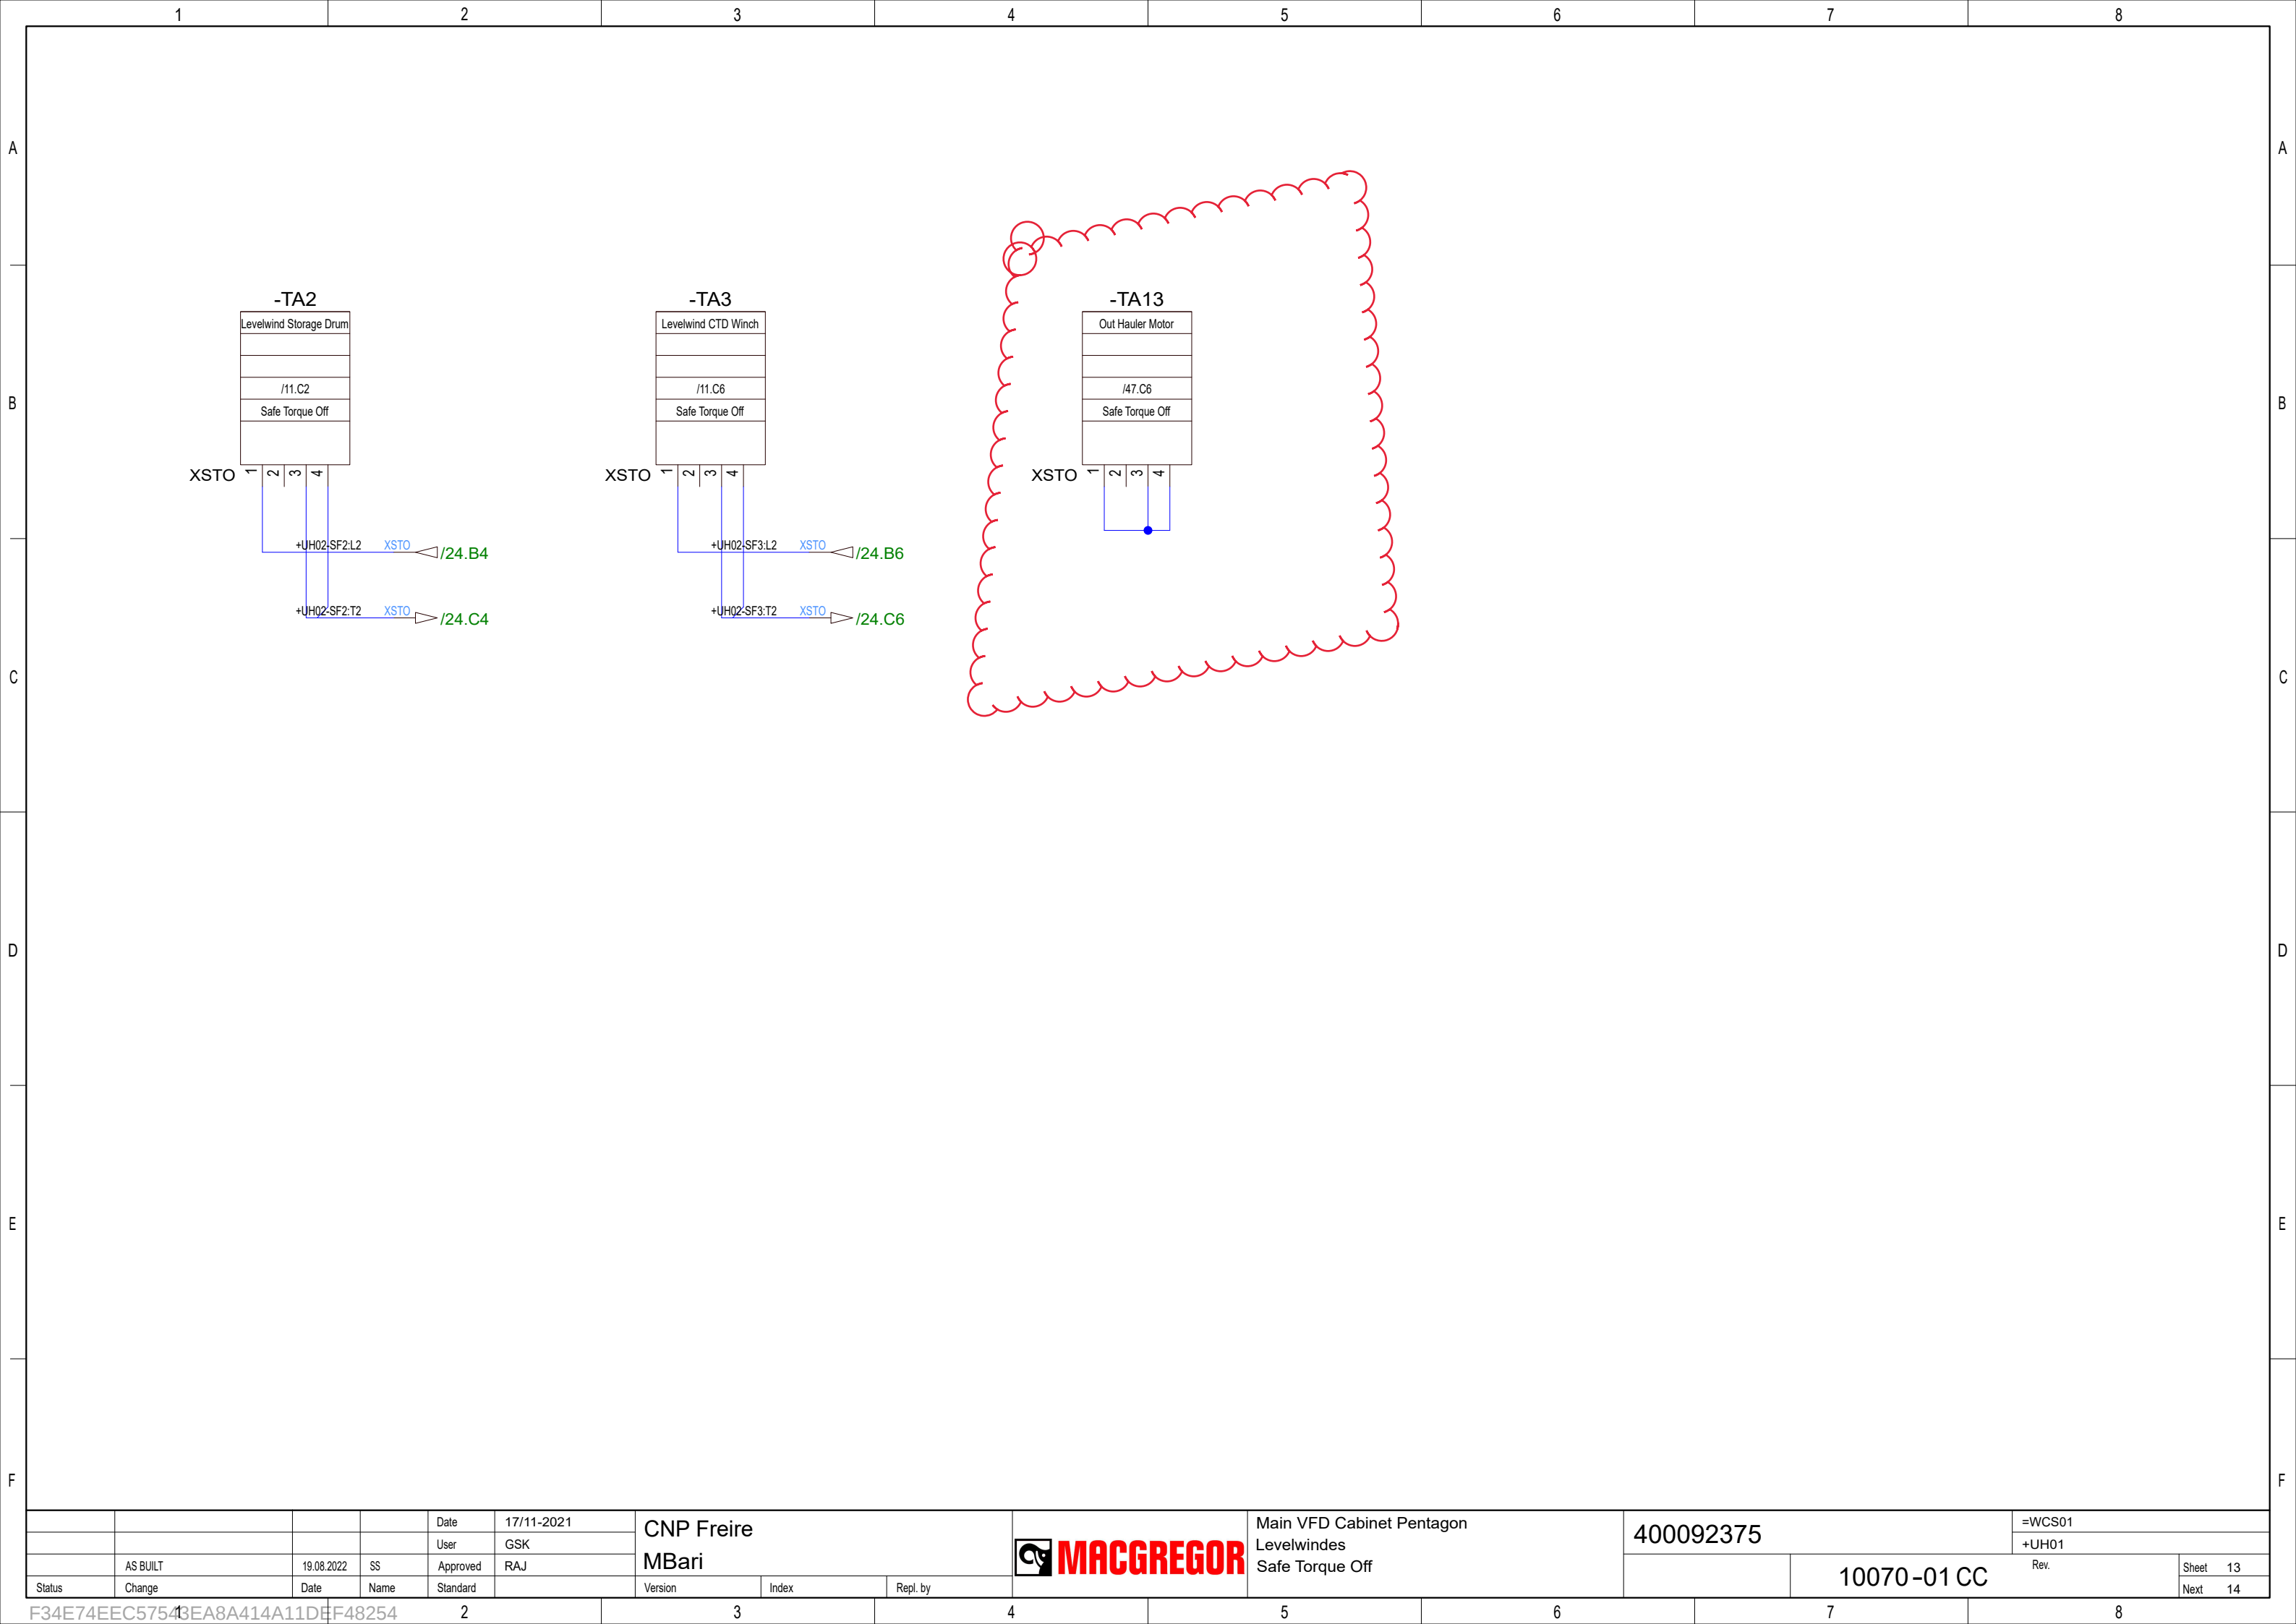

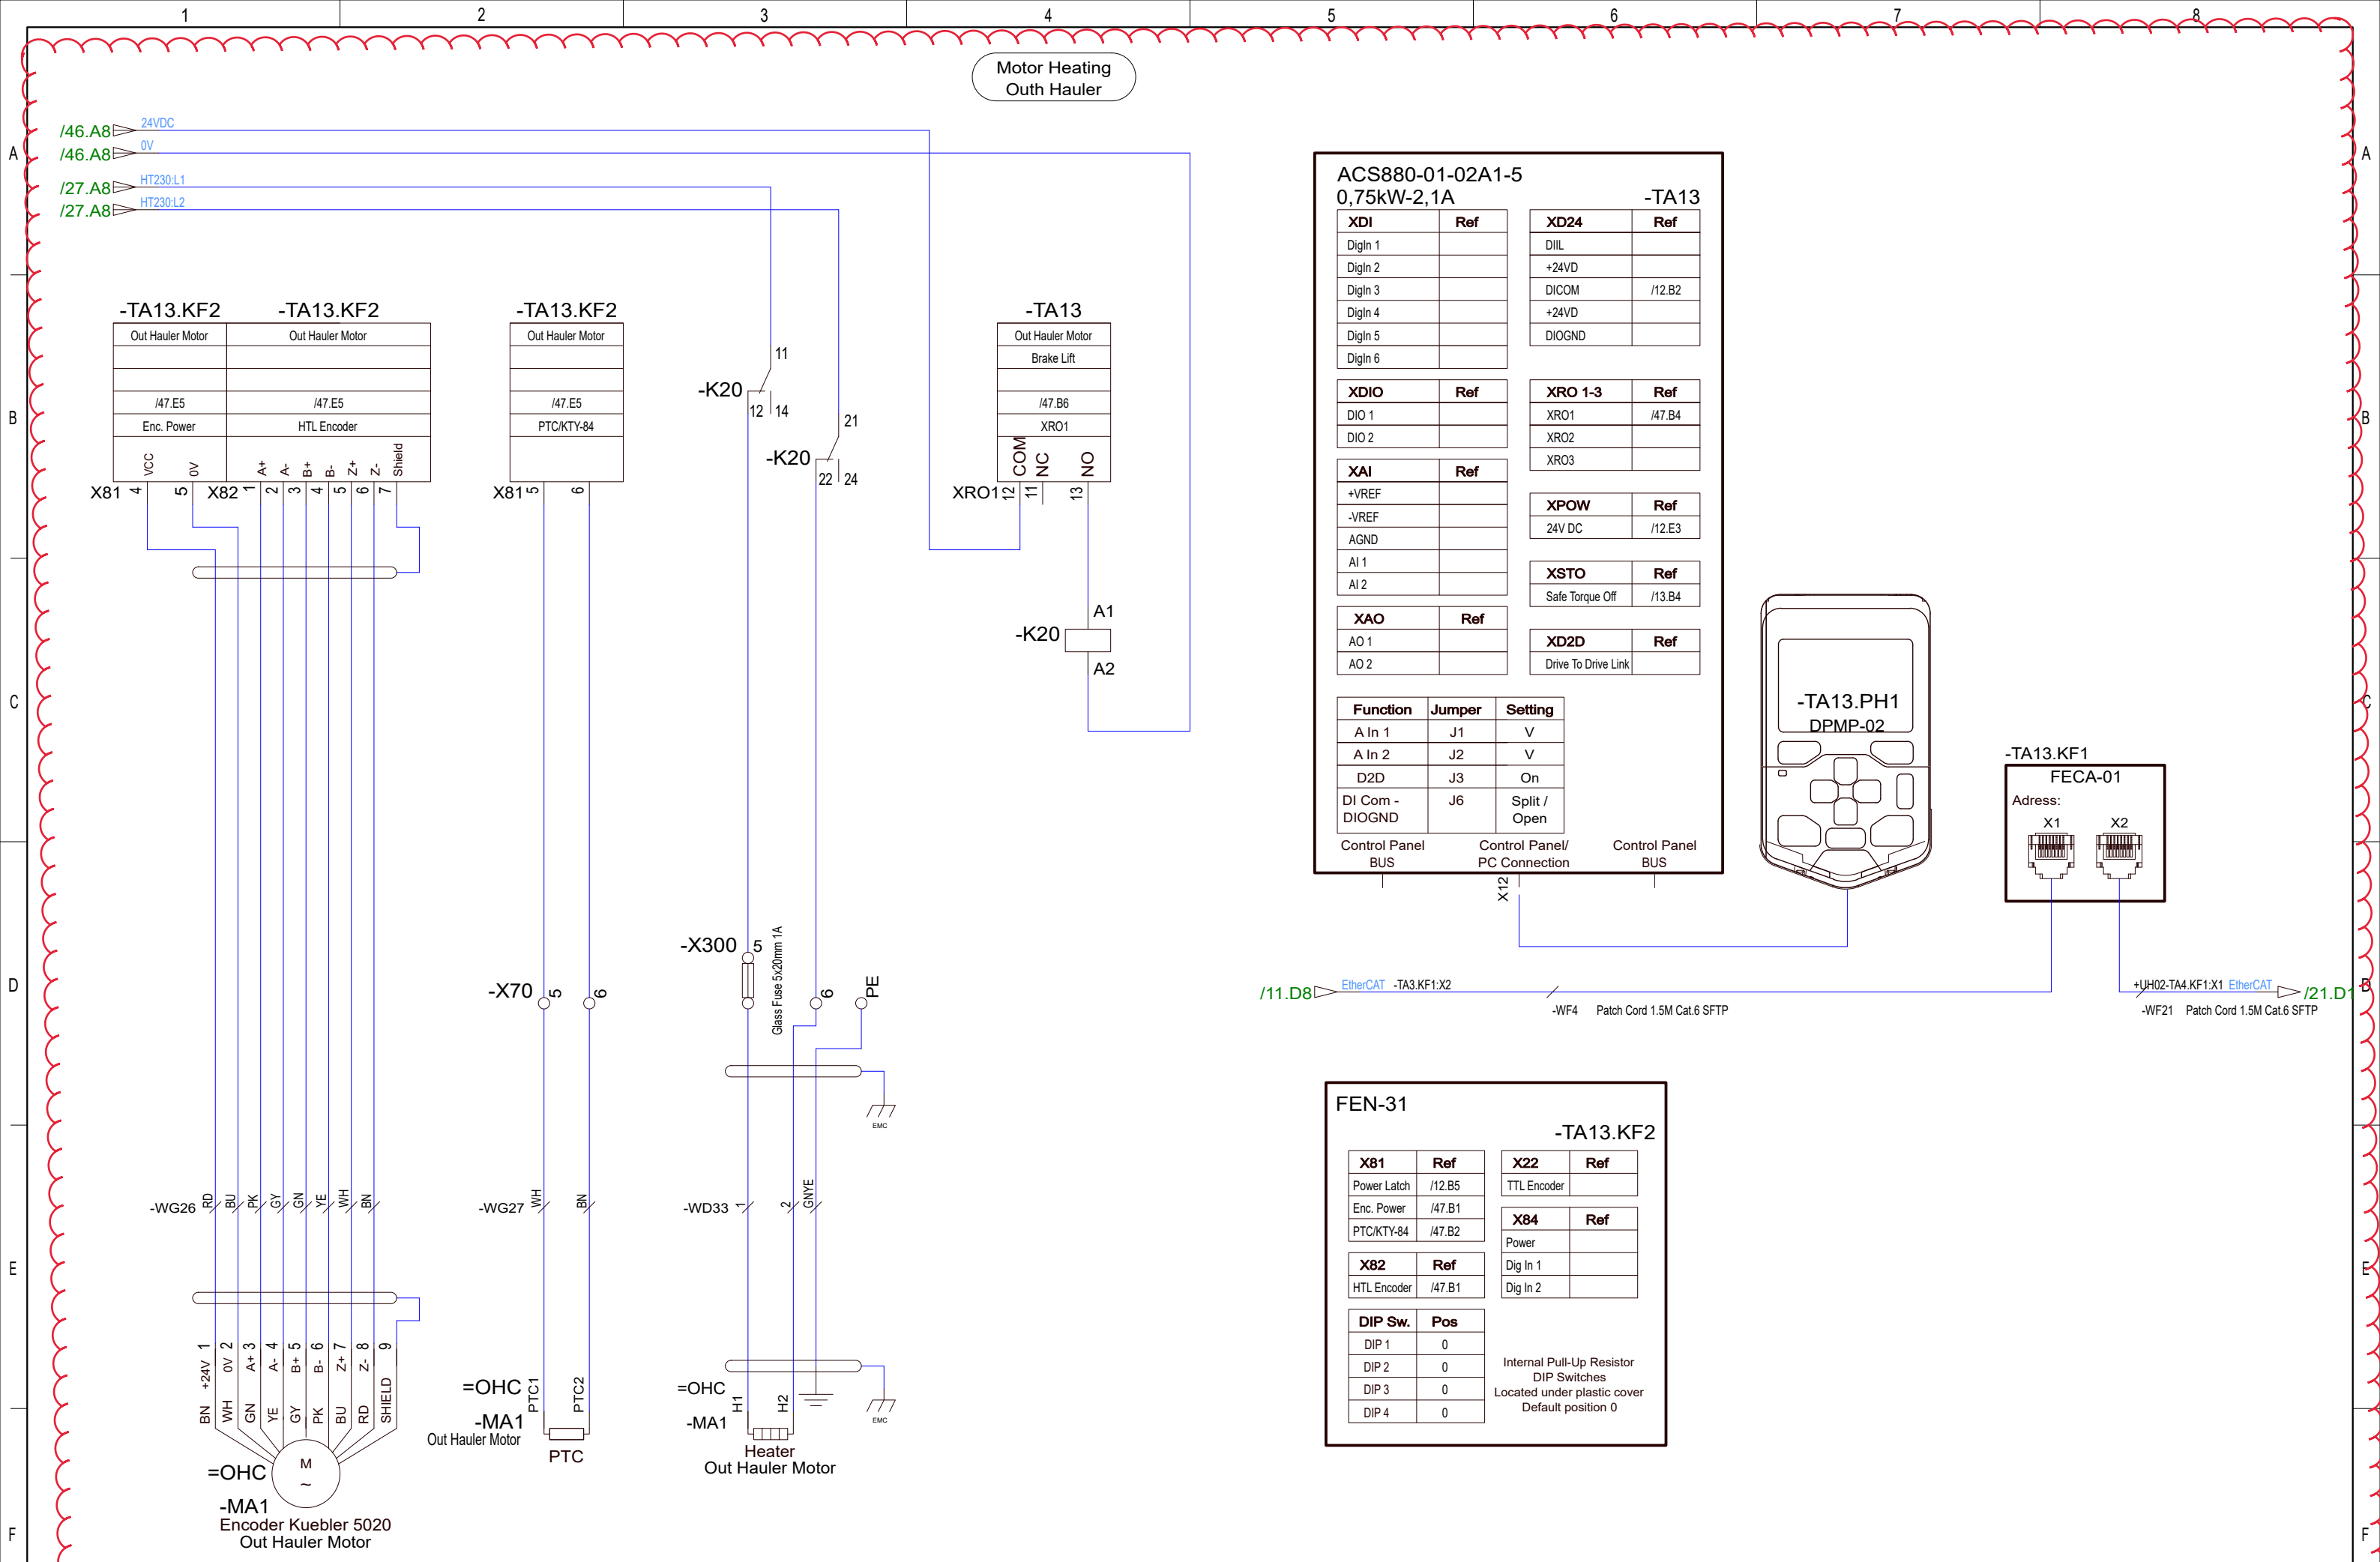

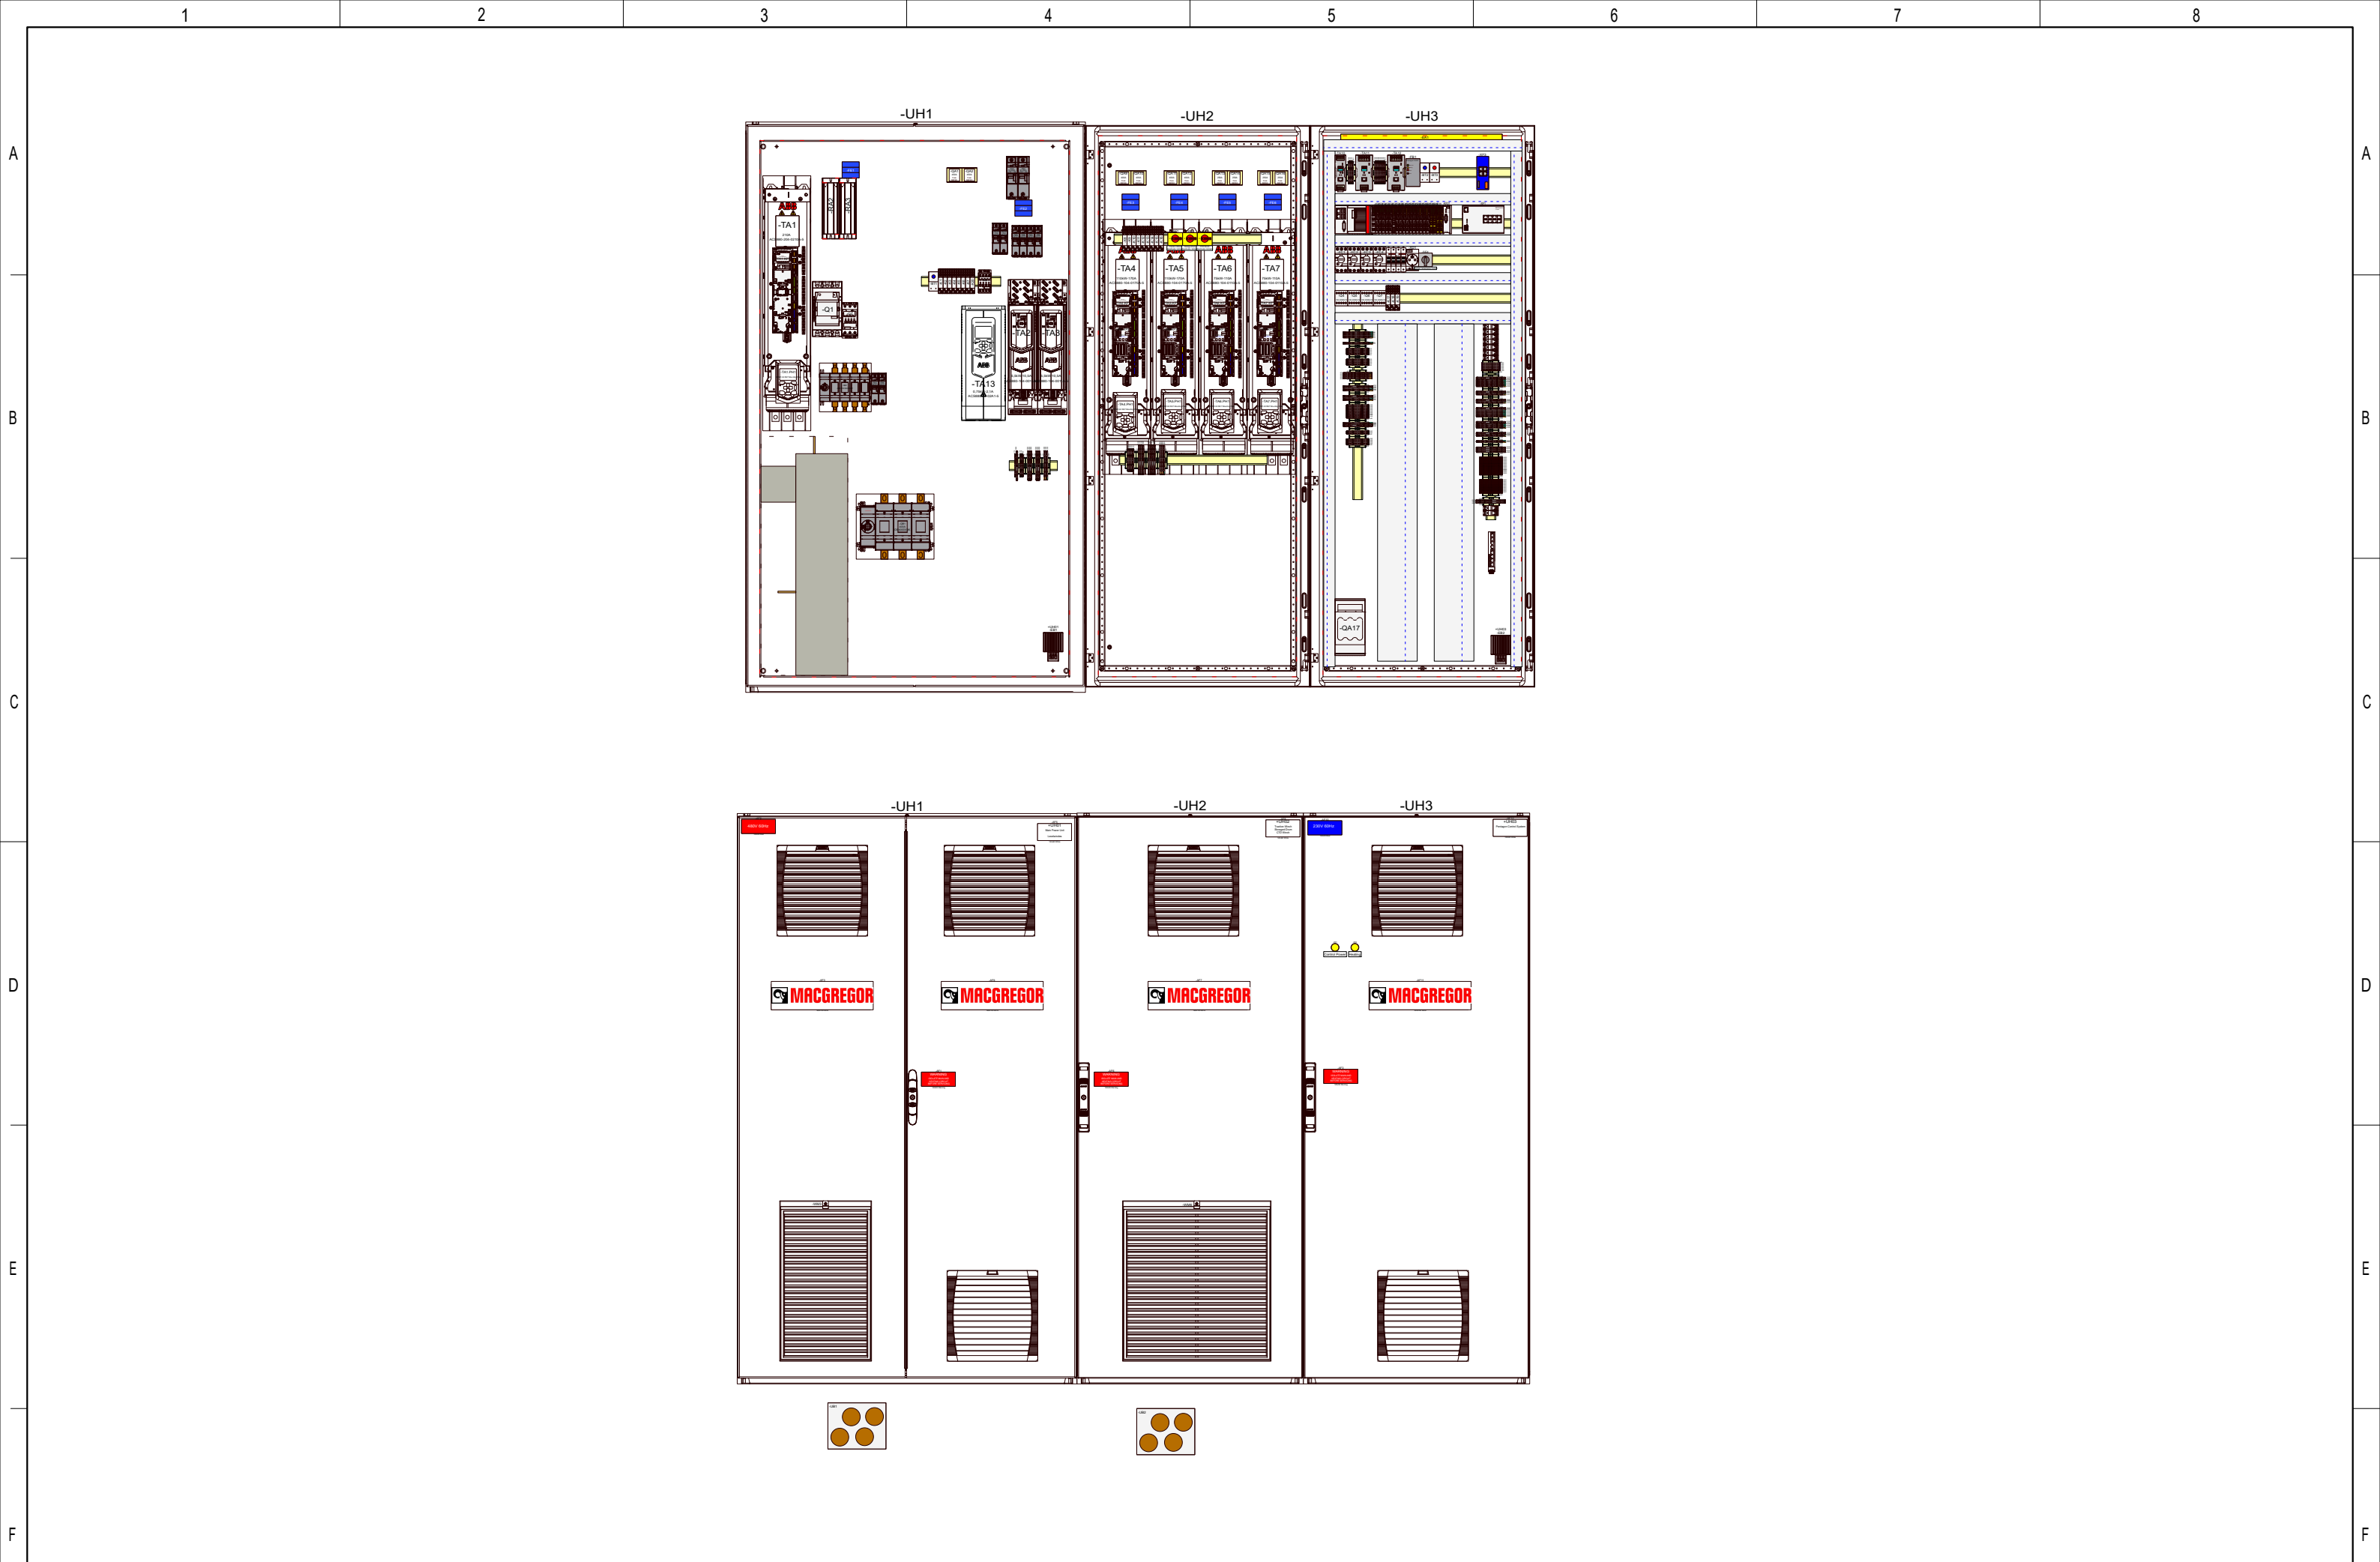

		Date	17/11-2021		CNP Freire MBarí				Main VFD Cabinet Pentagon Panel Layout		400092375		=WCS01	
Added WP03 connections		21.11.2022	ANP	User										
AS BUILT		19.08.2022	SS	Approved	RAJ								Rev.	Sheet 1
Status	Change	Date	Name	Standard	Version	Index	Repl. by					10070-01 GA		Next 2

