


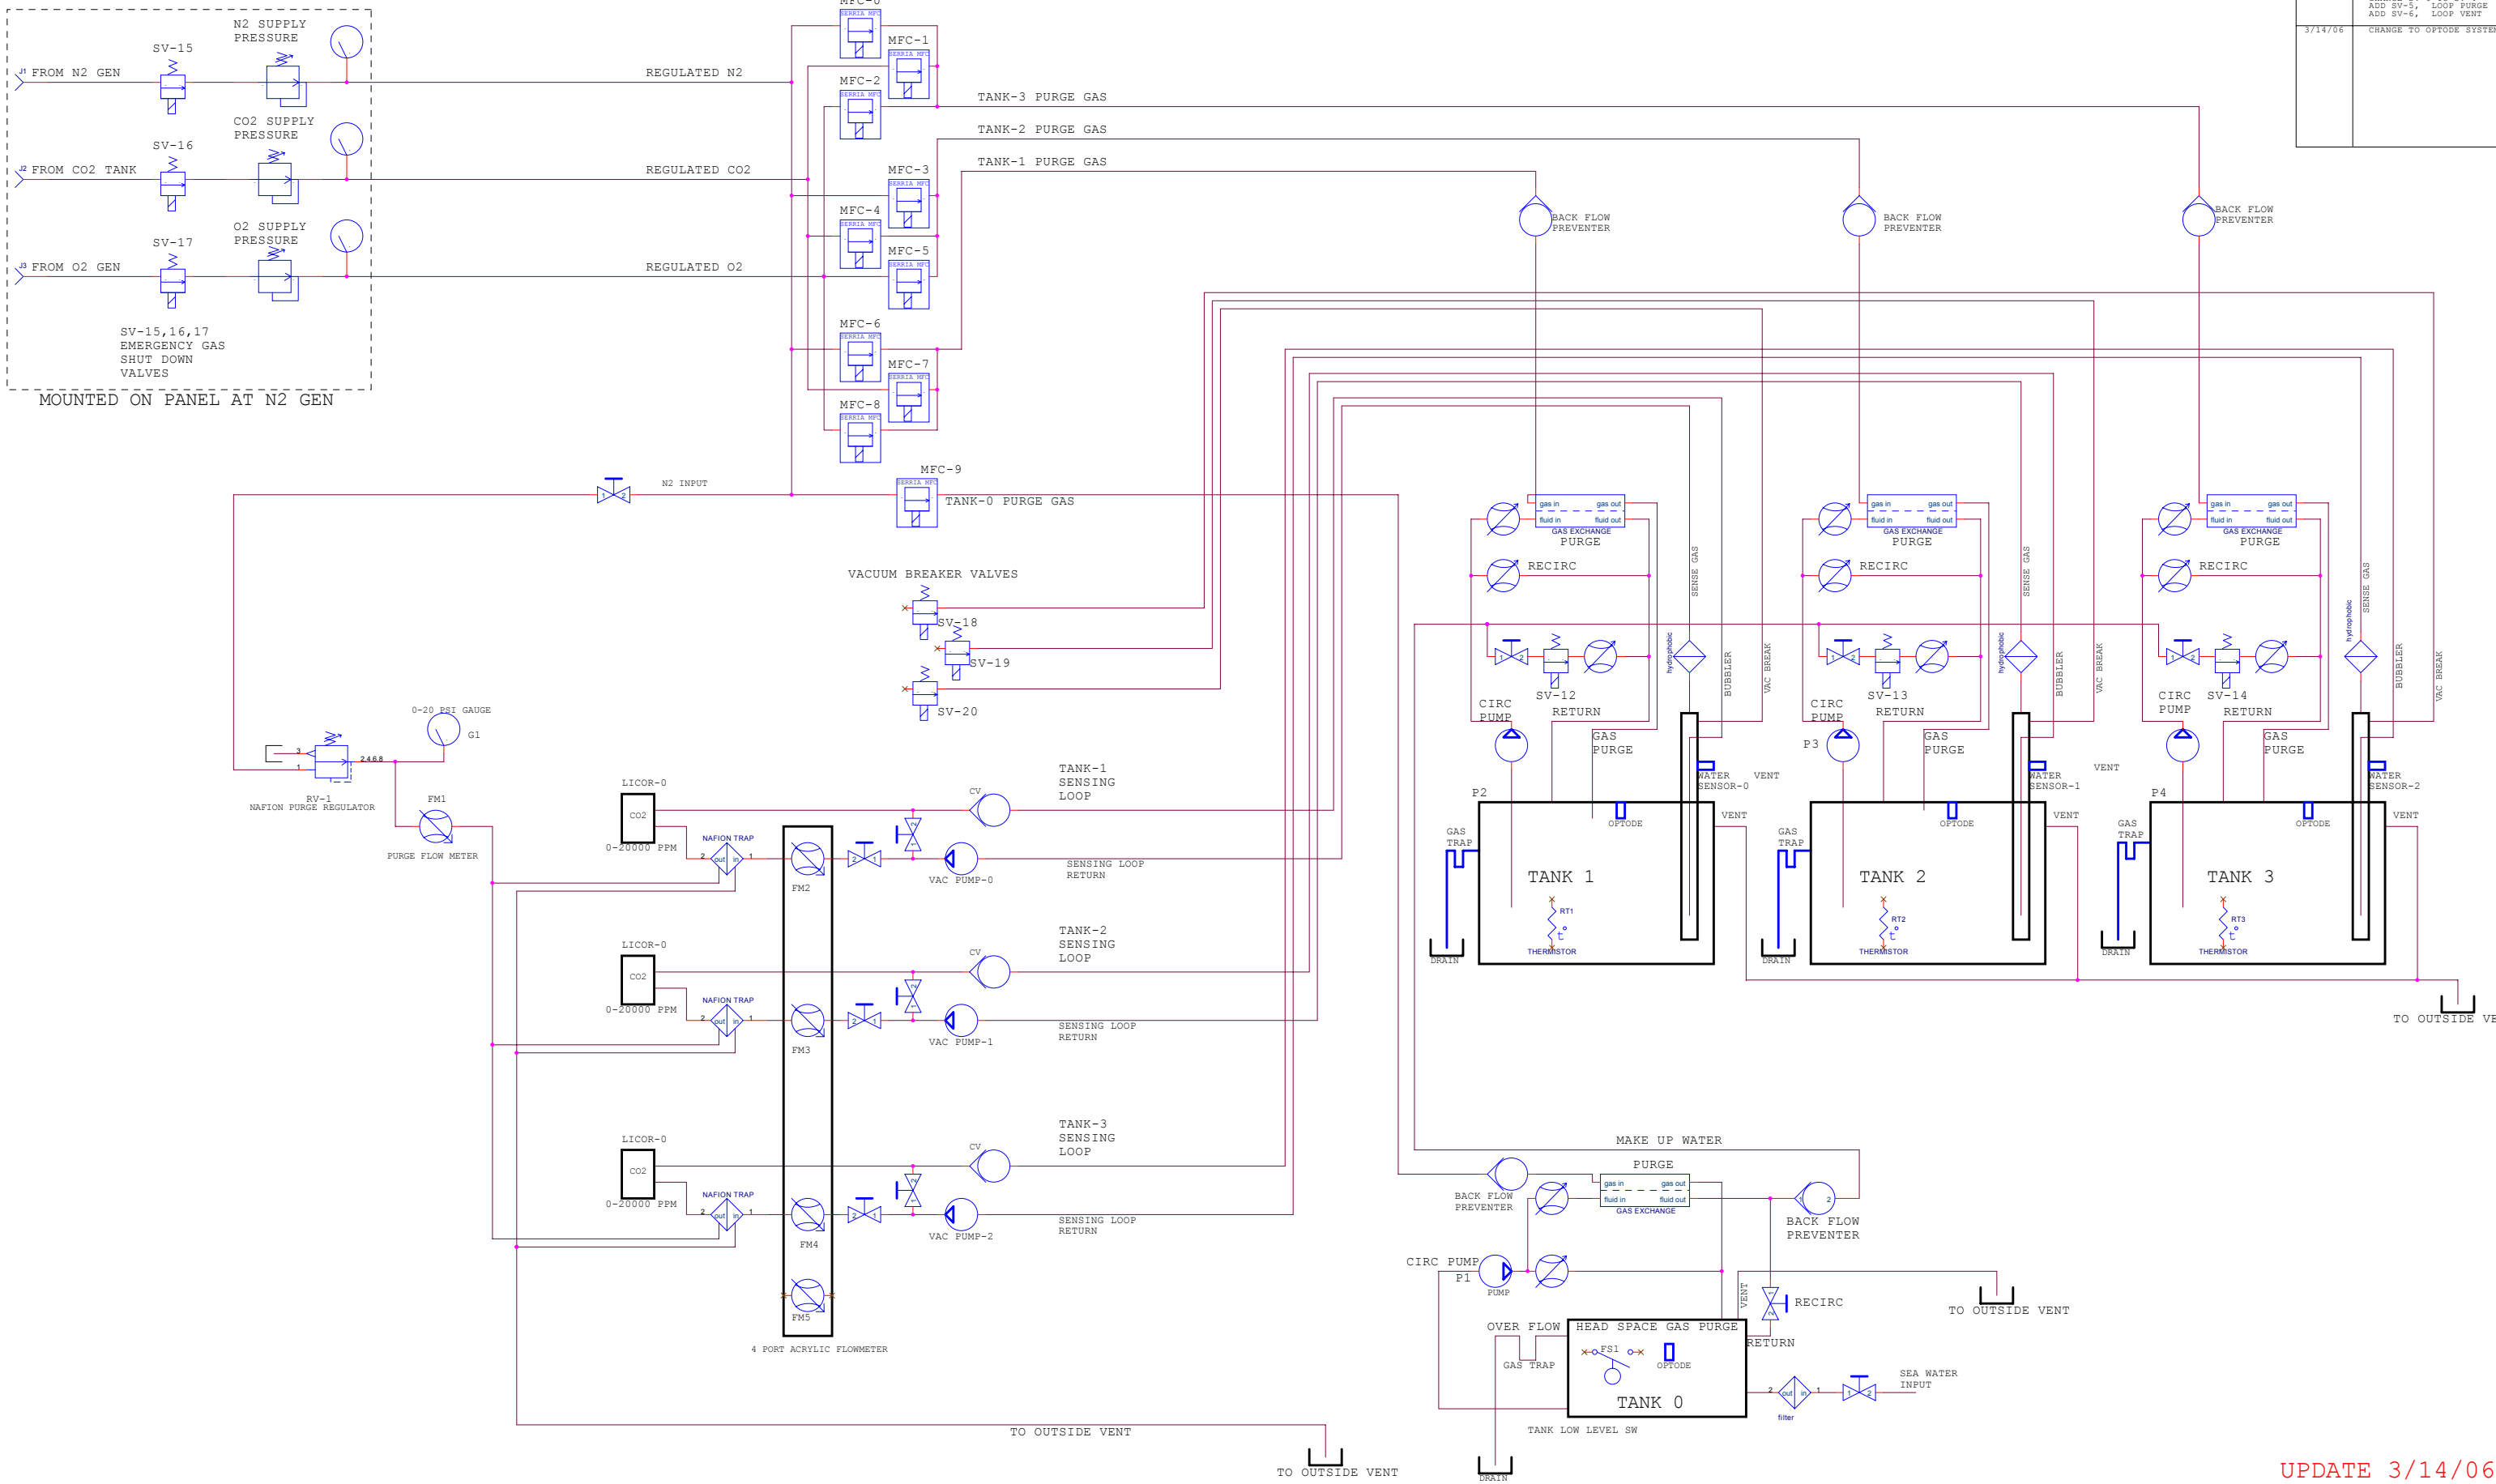

7/15/05	ADD WATER SENSOR ADD SV-18 CHANGE SV-0 TO SV-4 ADD SV-5, LOOP PURGE ADD SV-6, LOOP VENT
3/14/06	CHANGE TO OPTODE SYSTEM

UPDATE 3/14/06

File		
AQUARIA SYSTEM PLUMBING DIAGRAM		
Size	Document Number	Rev
D	<Doc>	B
Date:	Tuesday, March 14, 2006	Sheet 1 of 1