


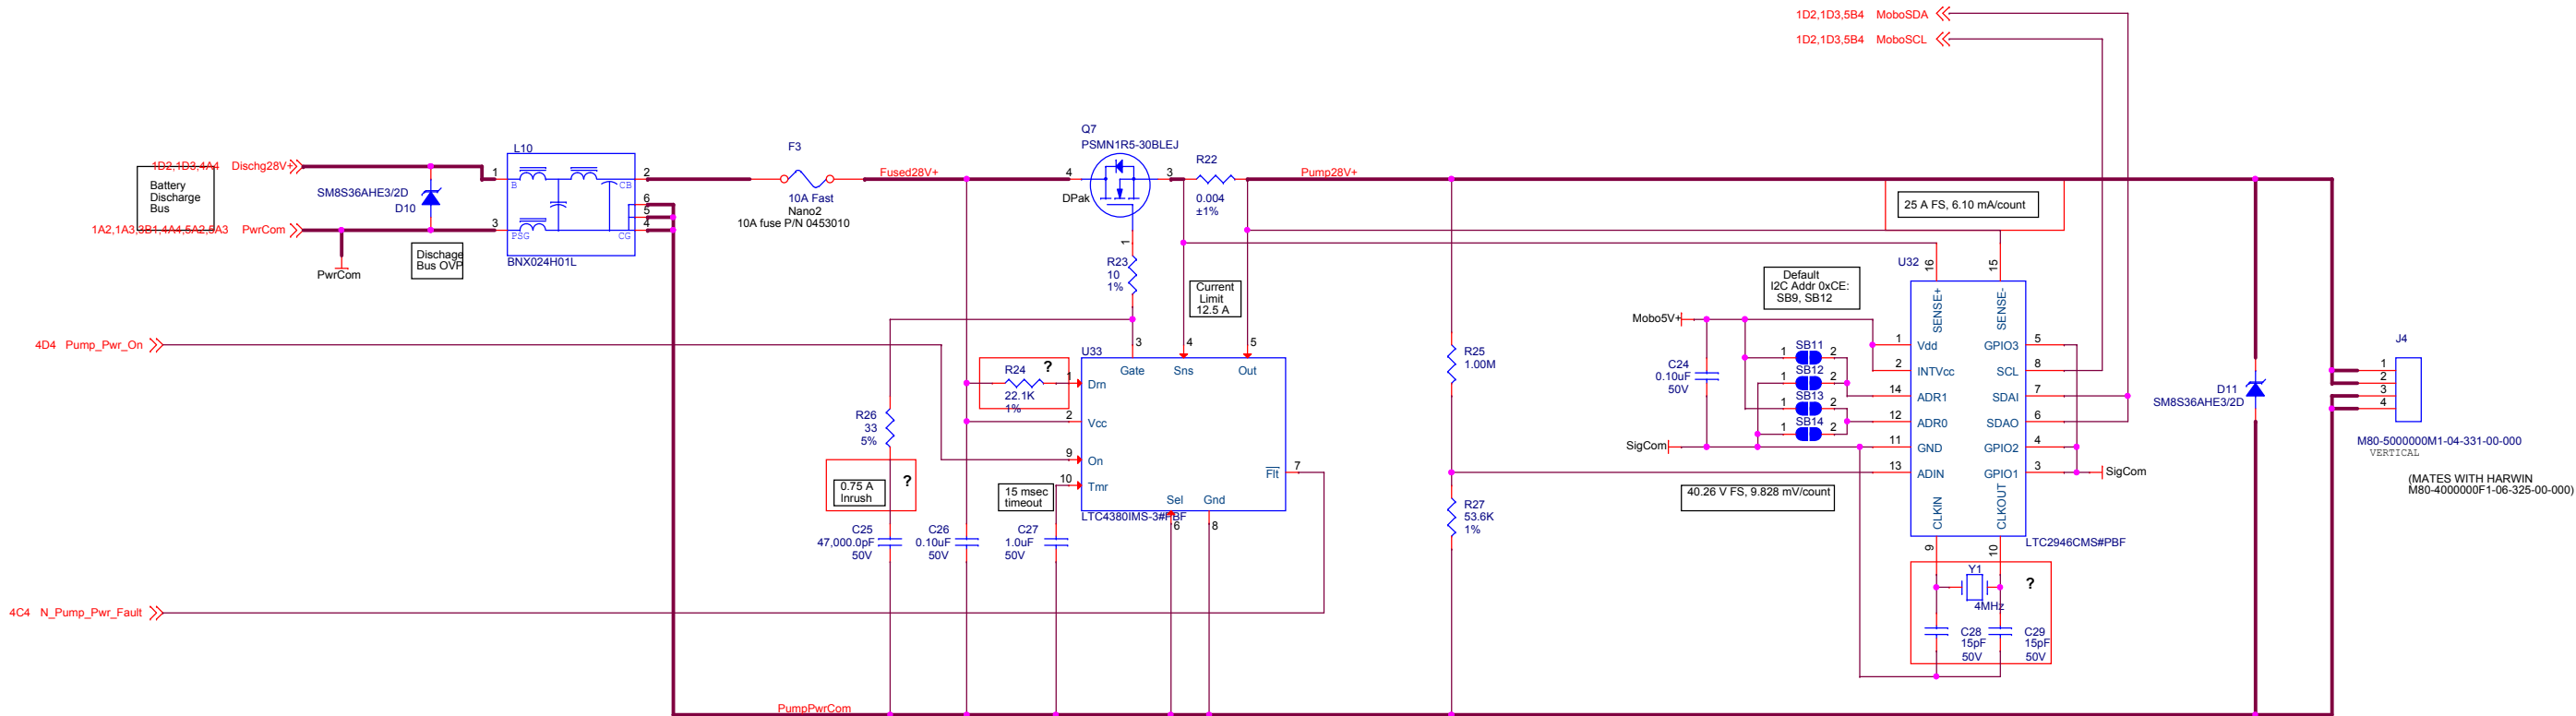

(Regen was here)