

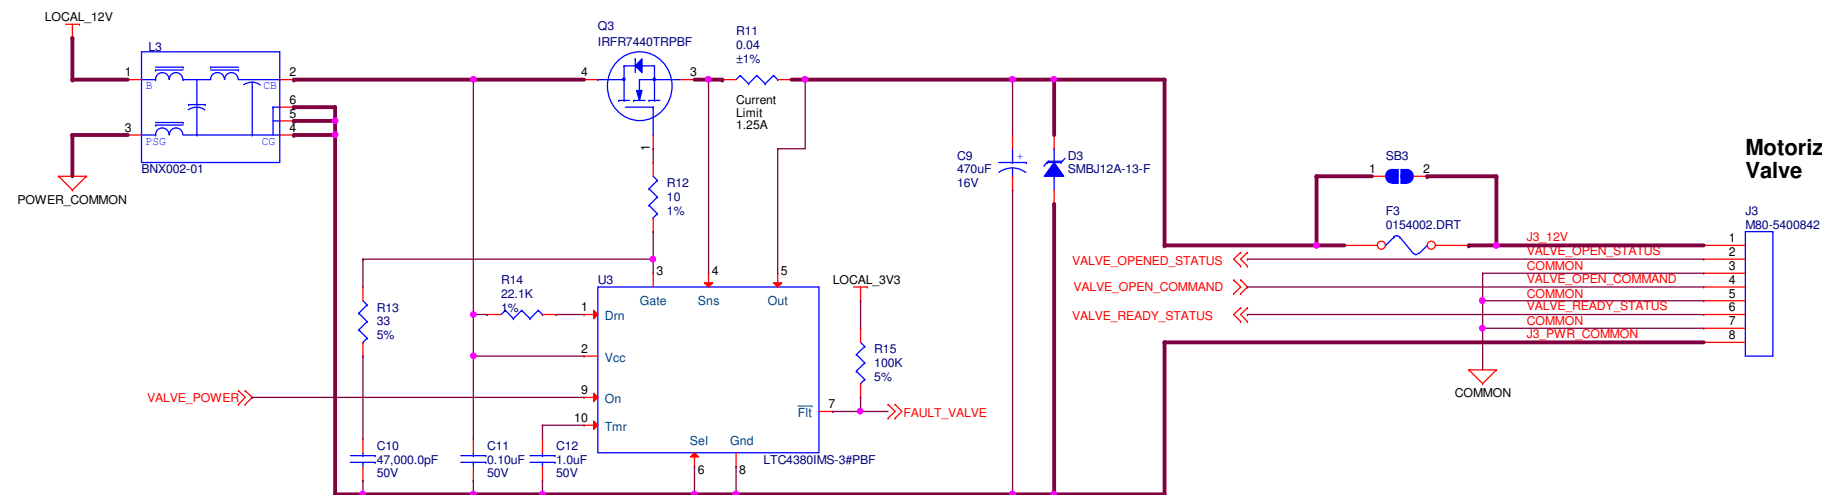


 

MONTEREY BAY AQUARIUM RESEARCH INSTITUTE 7700 SANDHOLDT ROAD MOSS LANDING, CA 95039 (831) 775-1700 www.mbari.org Copyright MBARI 2000					
Title CPF Internal Sensor Interface Board		Number			
Size C	Engineer Chad Kacy		Layout <Layout Eng.>		Filename <Filename>
	Date: Wednesday, September 11, 2019		Sheet 1		of 9

WSL Series Current Sense Resistors:
7m, 8m, 9m, 10m, 12m, 13m,
15m, 20m, 25m, 27m, 30m, 33m,
39m, 40m, 47m, 50m, 51m, 60m,
70m,

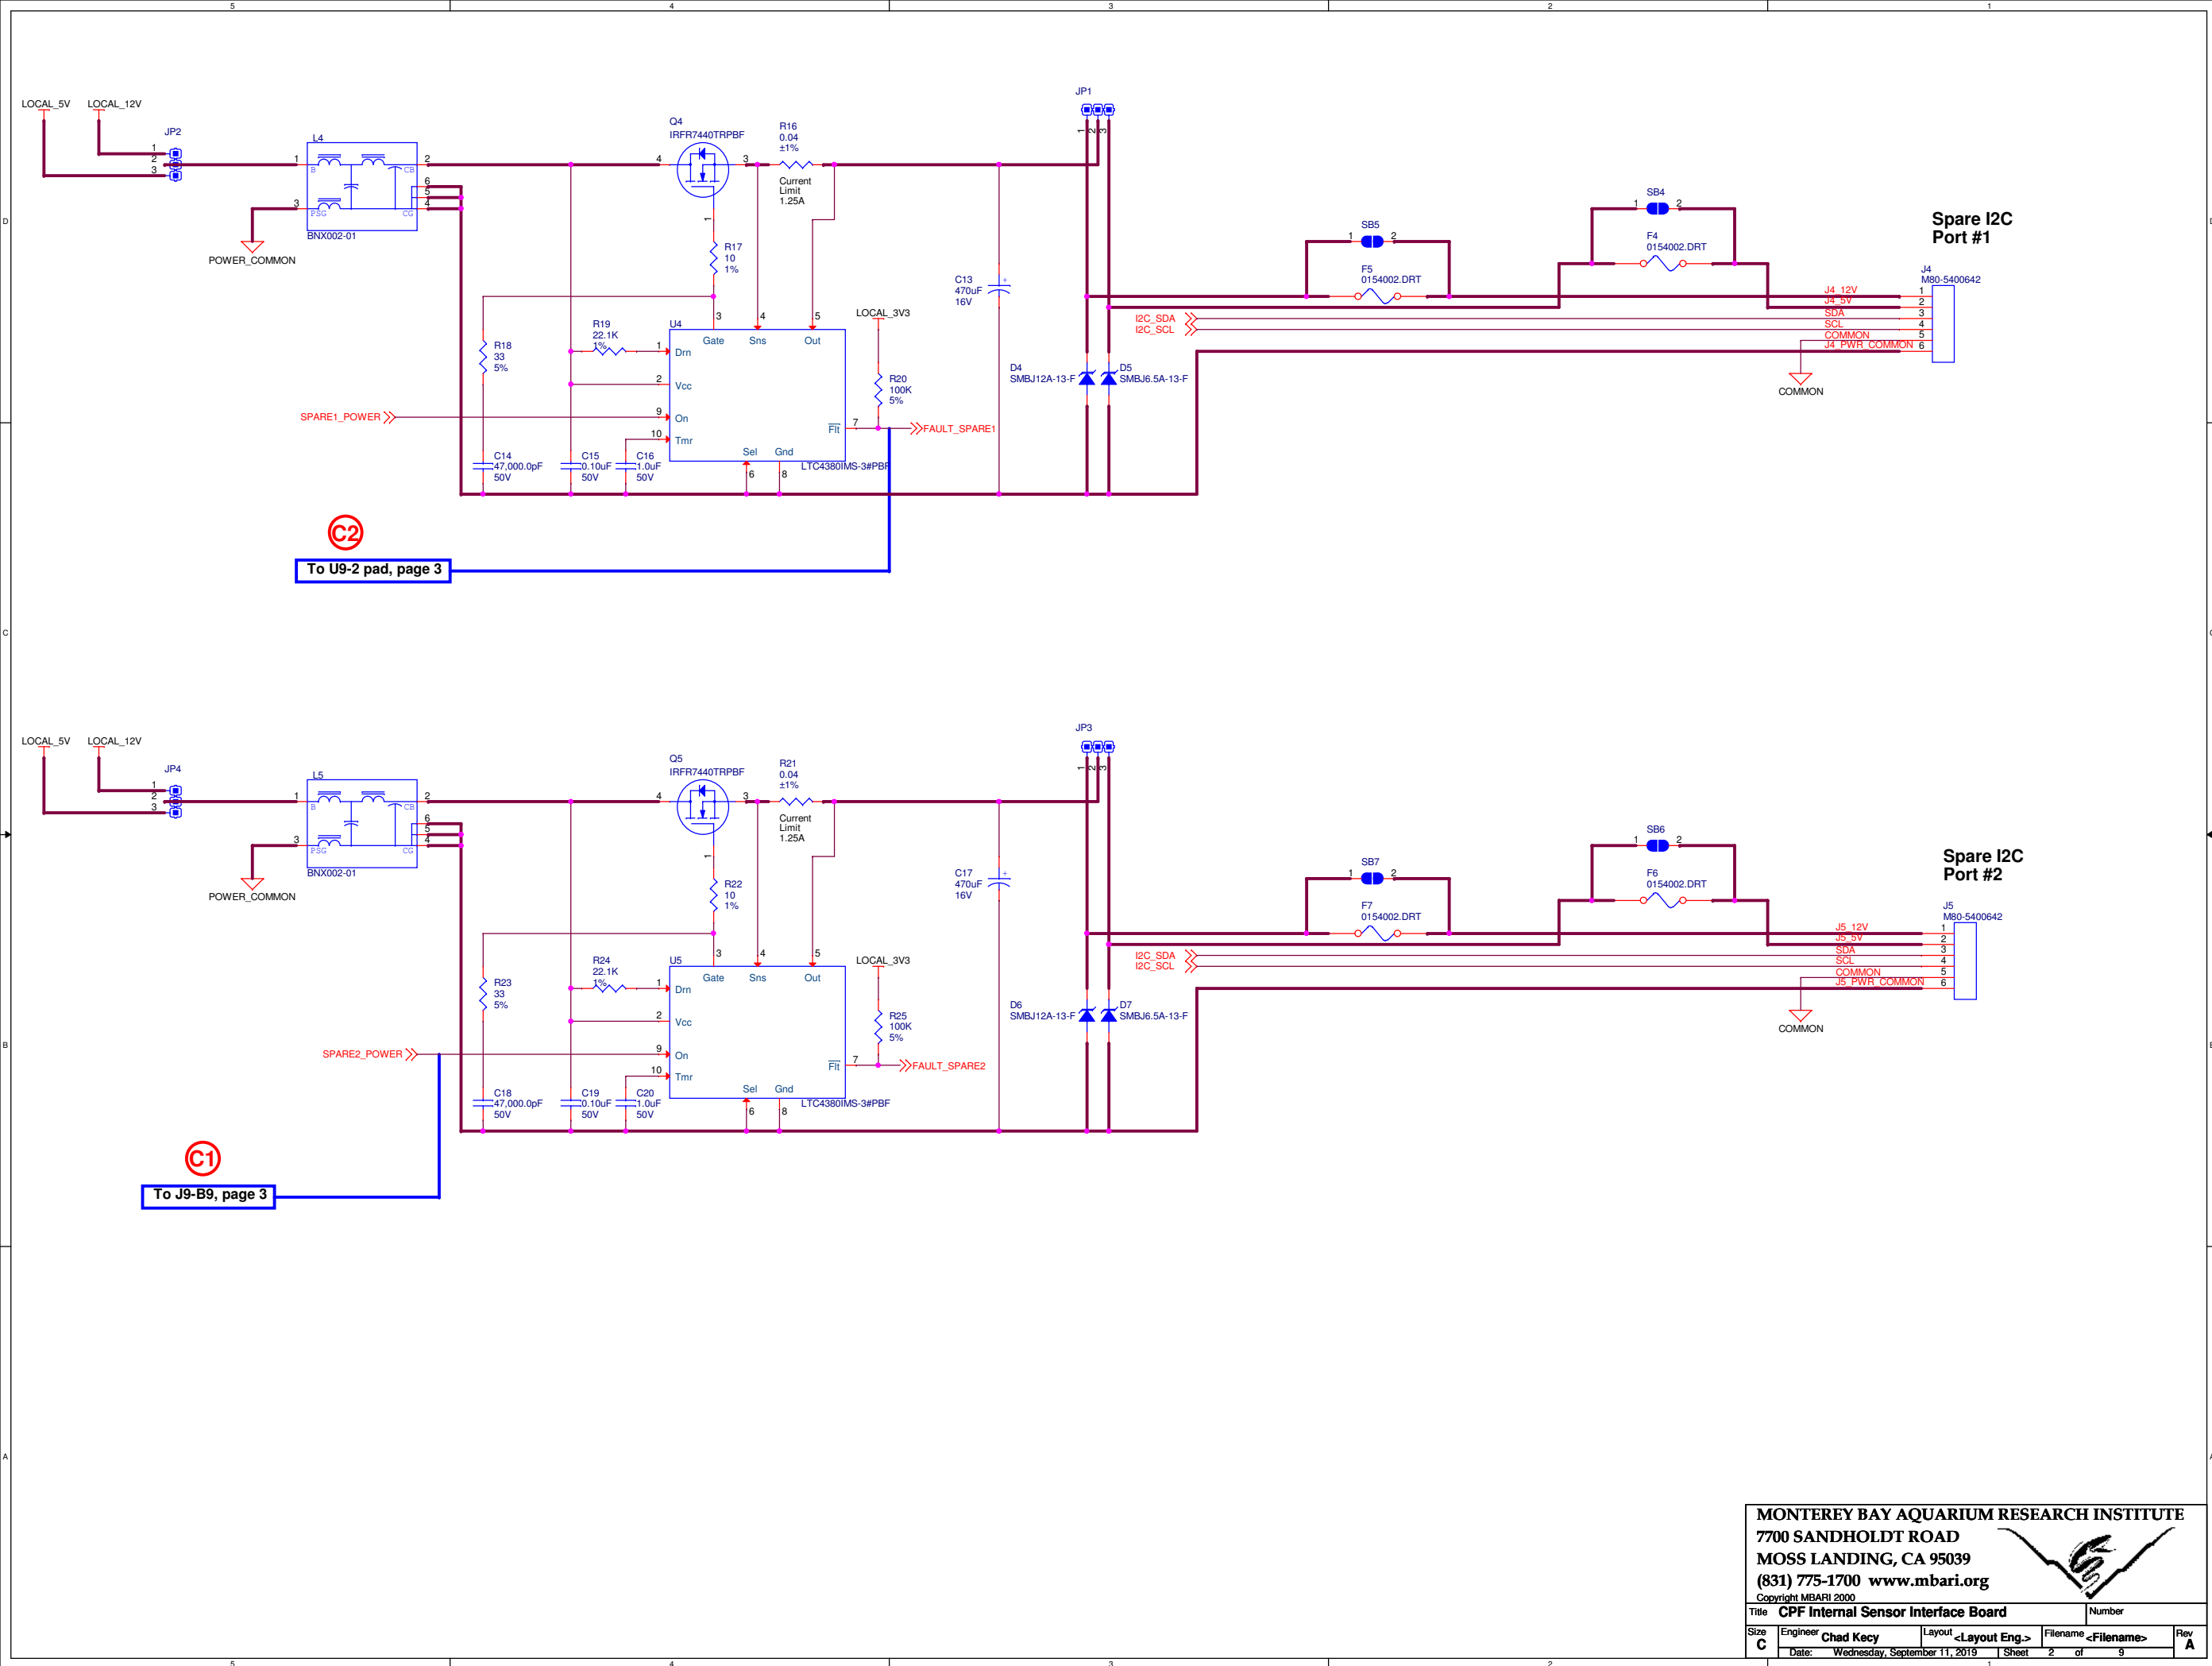

MONTEREY BAY AQUARIUM RESEARCH INSTITUTE
7700 SANDHOLDT ROAD
MOSS LANDING, CA 95039
(831) 775-1700 www.mbari.org
Copyright MBARI 2000



Title CPF Internal Sensor Interface Board				Number	
Size C	Engineer Chad Kacy	Layout <Layout Eng.>	Filename <Filename>	Rev A	
Date: Wednesday, September 11, 2019		Sheet 2 of 9			

