


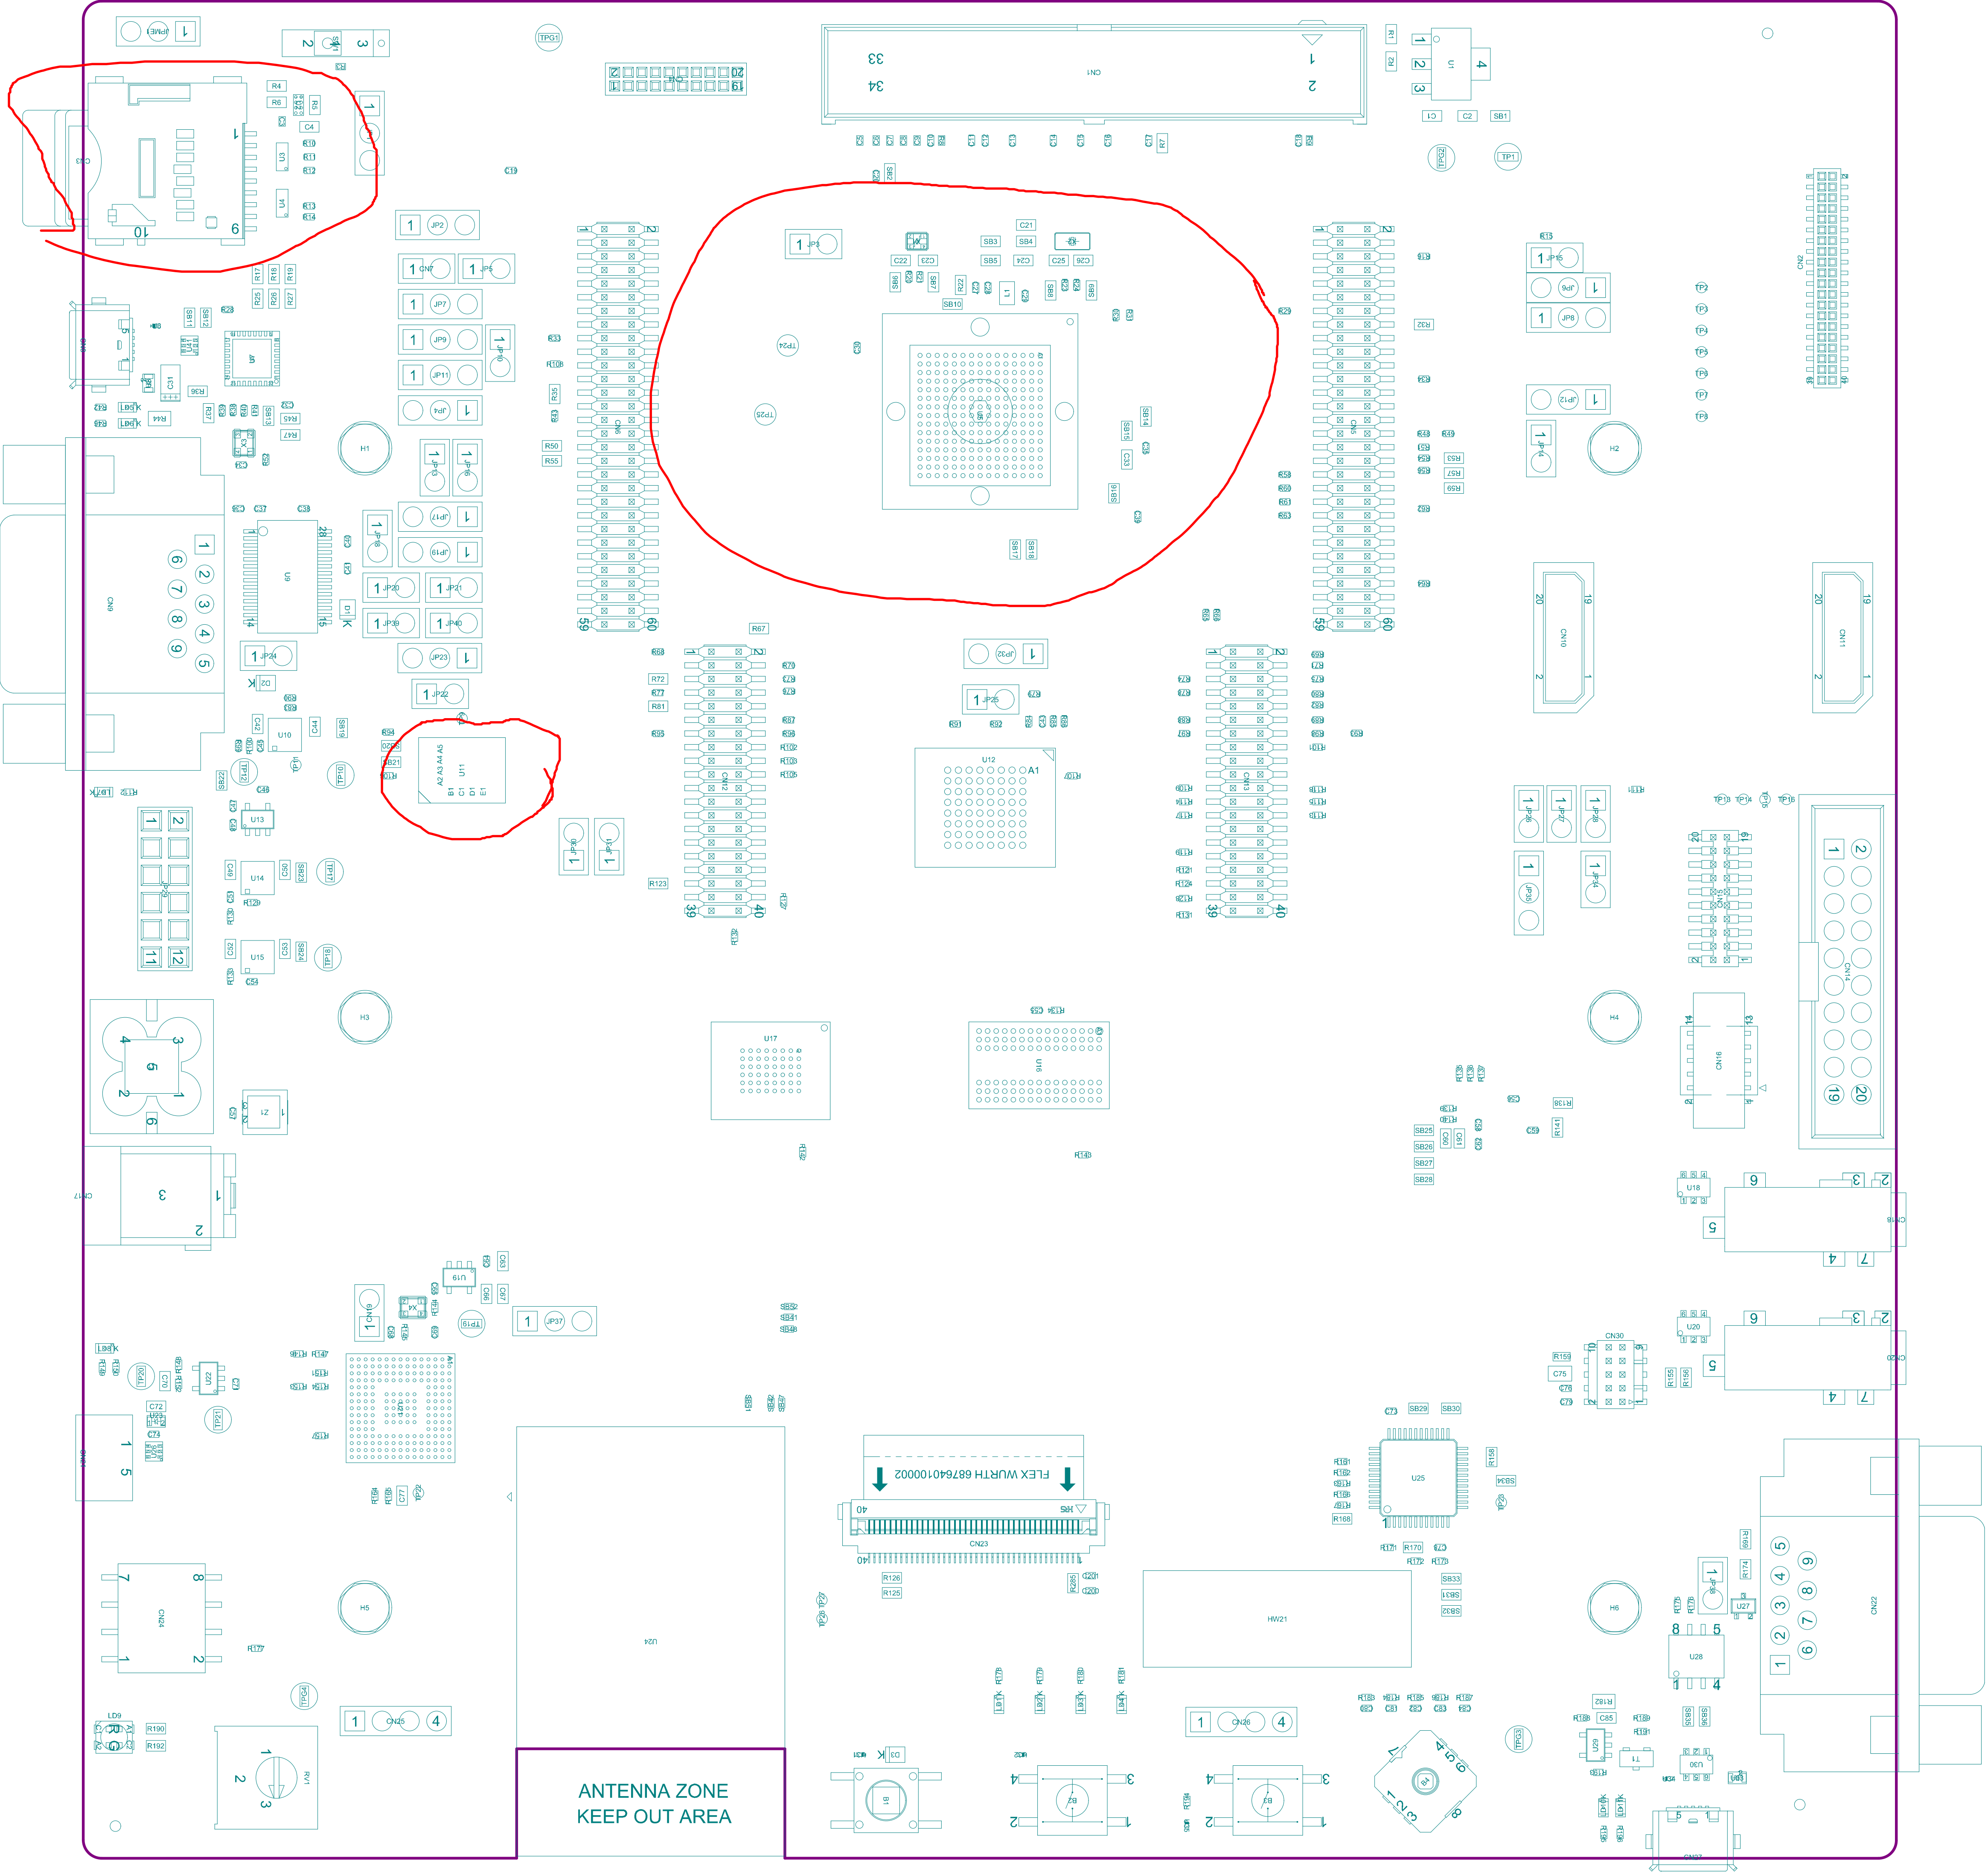

Project: STM32H7B3I-EVAL

Layer: M14-Top Assembly

Variant: [No Variations]

Date: 20-SEPT-19

Gerber: .GM14

Ref: MB1331

Rev: D





