


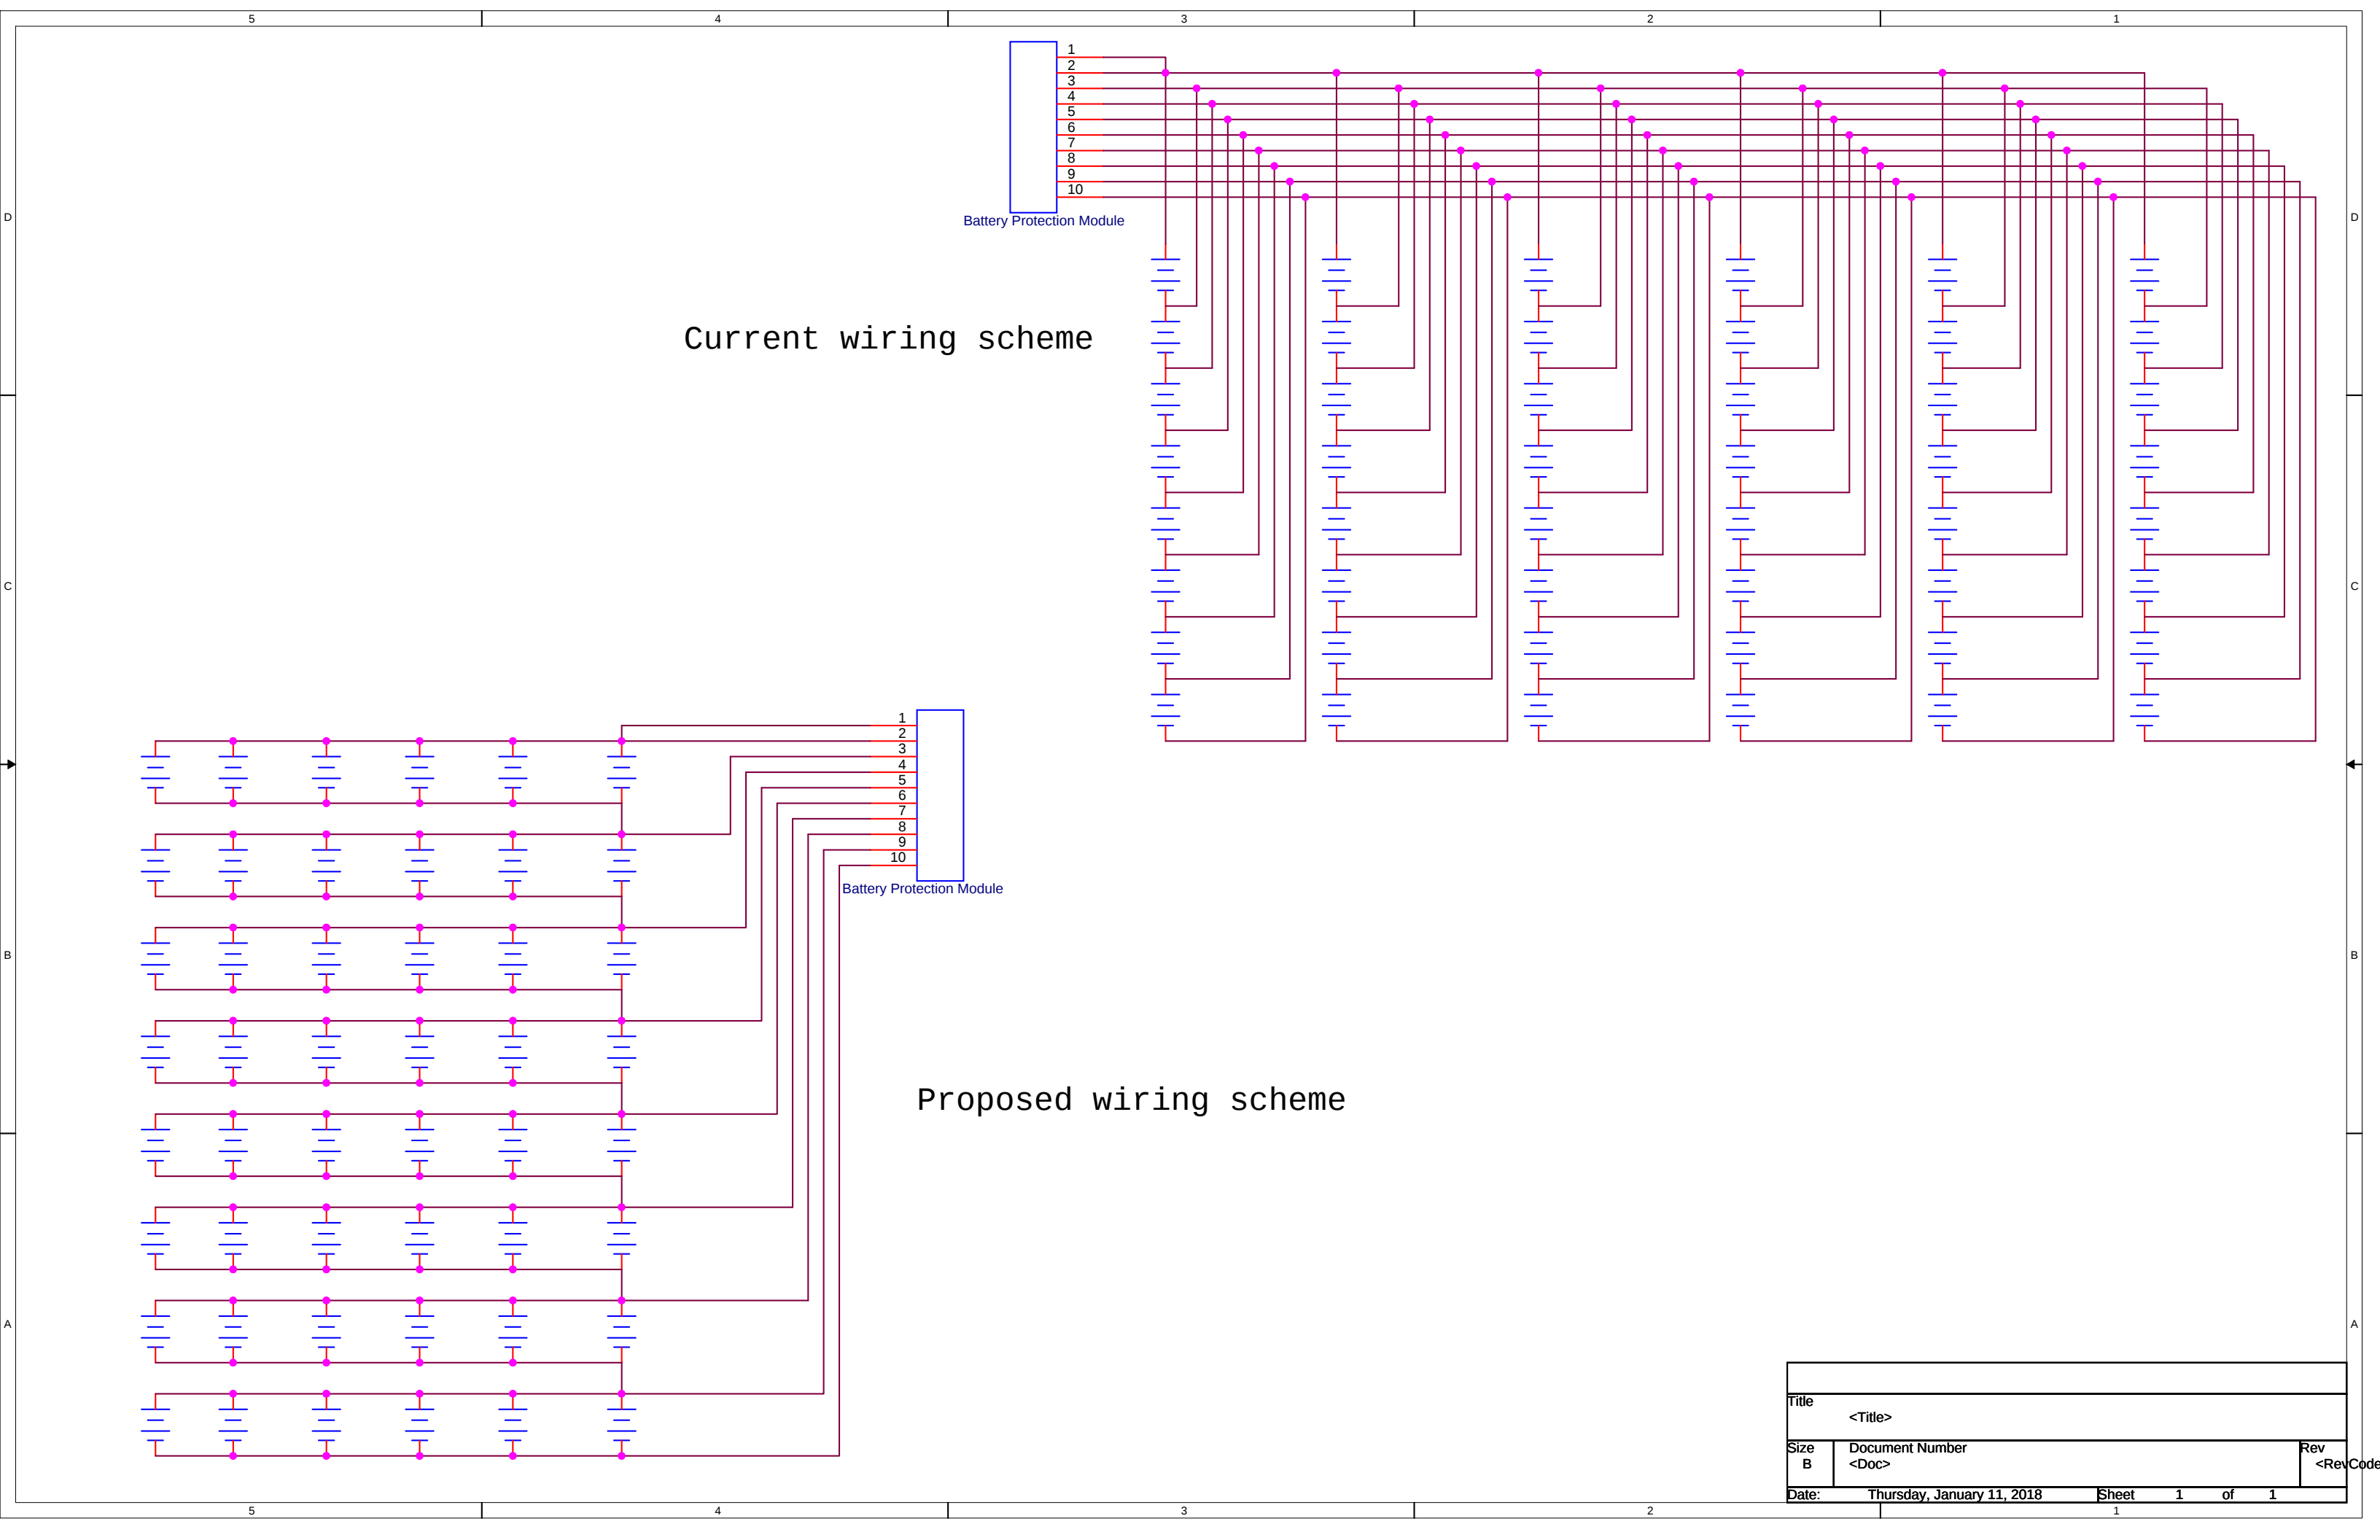

Current wiring scheme

Proposed wiring scheme

Title			<Title>		
Size	Document Number				Rev
B	<Doc>				<RevCode>
Date:	Thursday, January 11, 2018		Sheet	1	of 1