

CPF Hydraulics
Pump to MV Weldment Modification


Modification consists of:

- 1) Remove section from lower horizontal 3/8" tube
- 2) Weld in items 22, 33 and 34

Qty: 3 weldments

Gene Massion
Monterey Bay Aquarium Research Institute
831 7751922
magene@mbari.org

2016 May 19

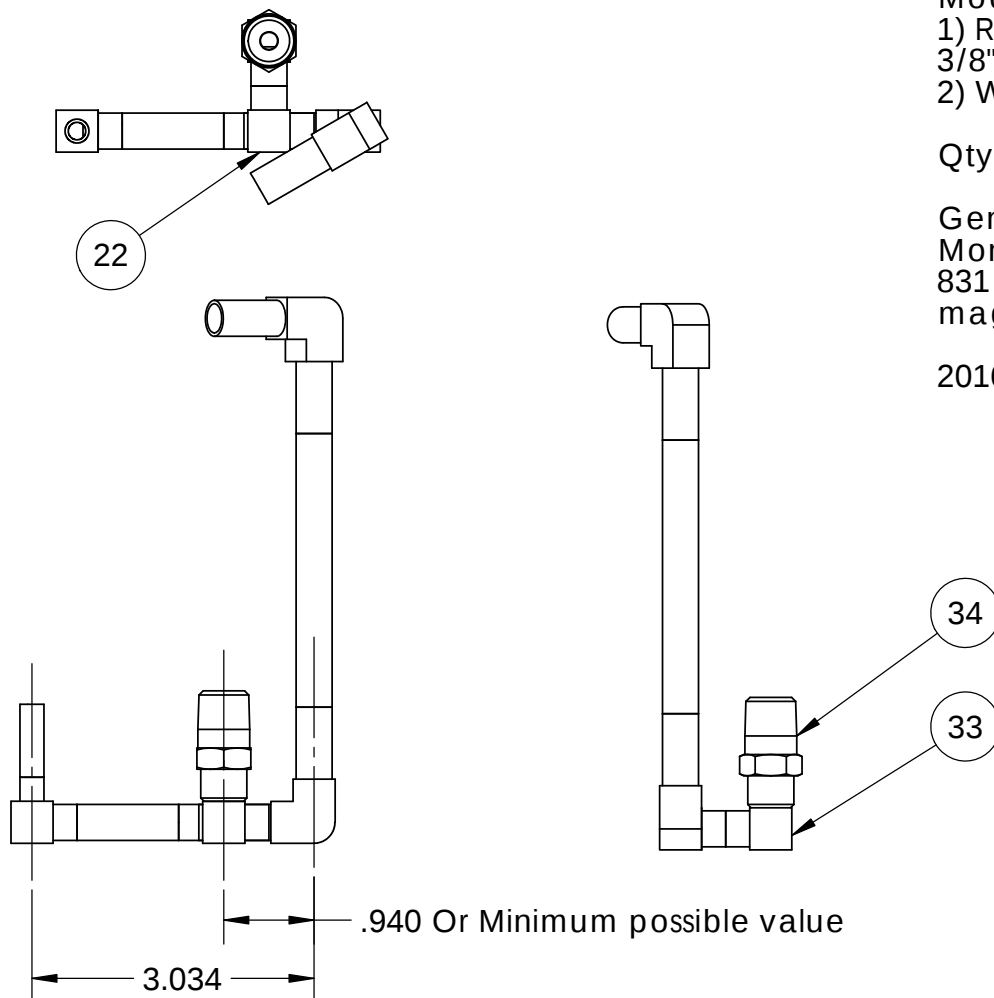

---	PART NUMBER	DESCRIPTION	backflush/QTY.
22	Union Tee_6LV-6MW-3_3_8_Swagelok Company__4F64_123D6E	Union Tee	1
33	Reducing 90° Union Elbow_6LV-6MW-9-4_3_8 x 1_4_Swagelok Company__5092_1216CC	Reducing 90° Union Elbow	1
34	Male Connector_SS-4-TSW-1-4_1_4 x 1_4_Swagelok Company__9398_216FE8	Male Connector	1