


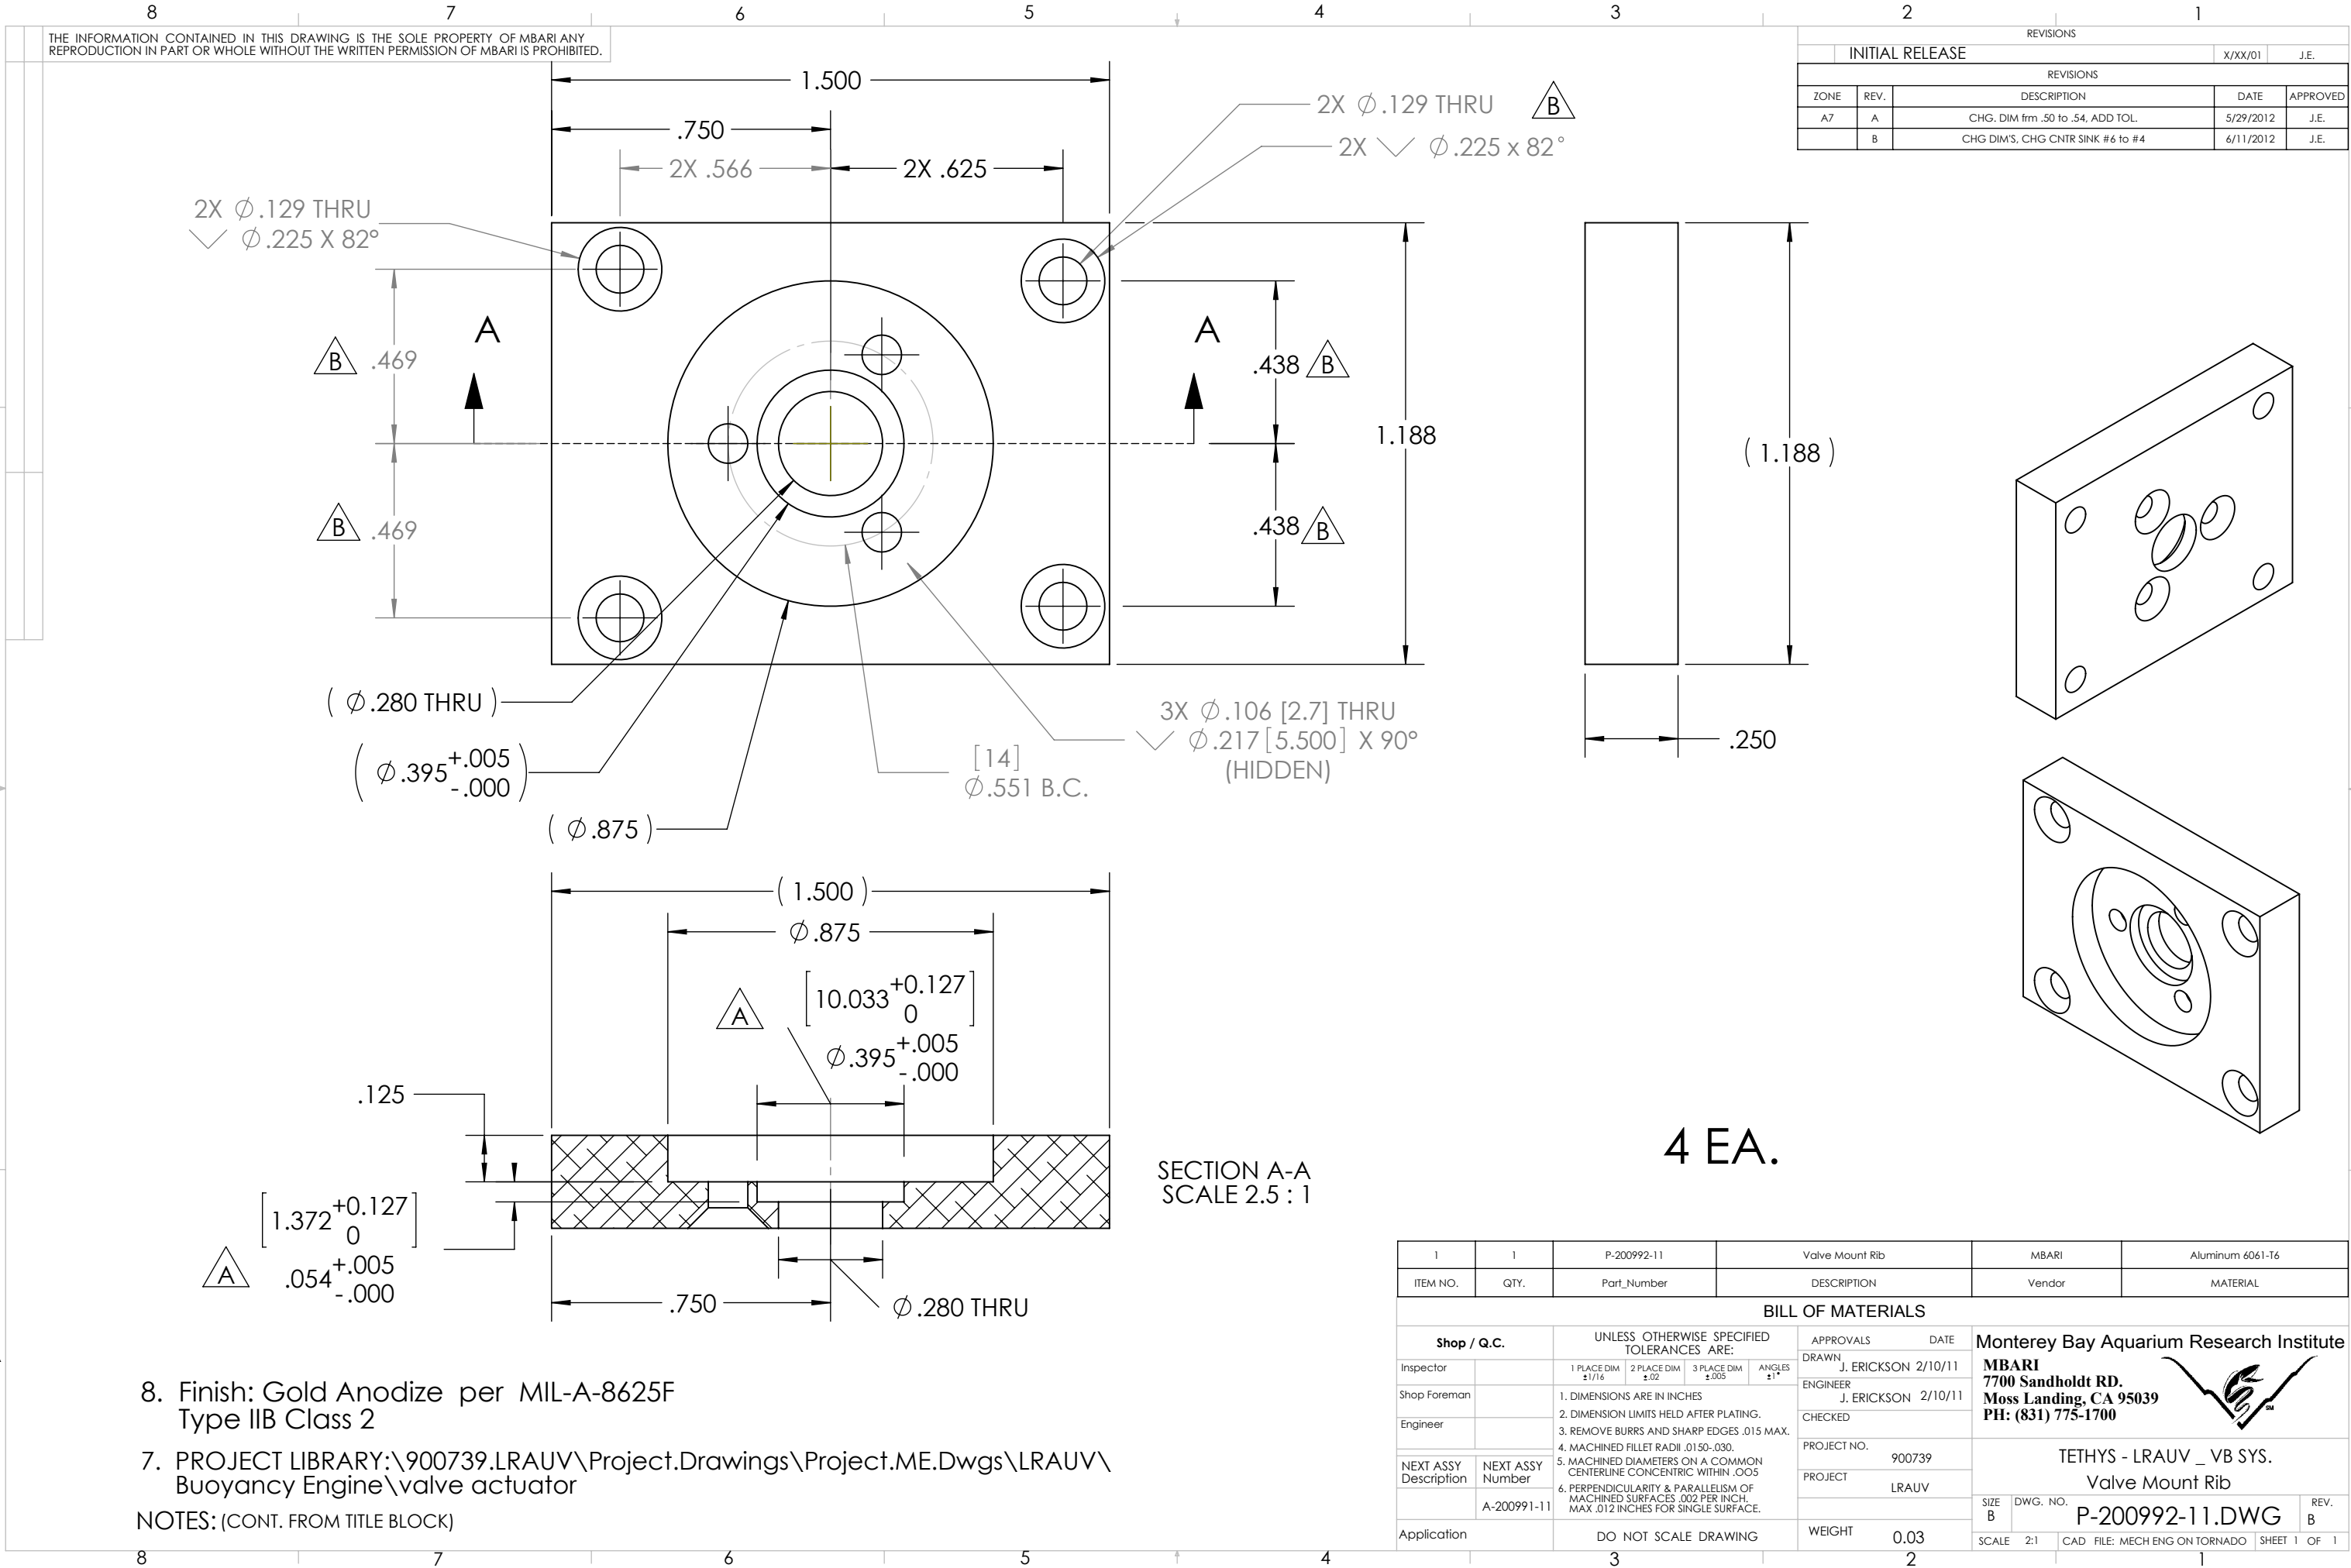

8. Finish: Gold Anodize per MIL-A-8625F
Type IIB Class 2

7. PROJECT LIBRARY:\900739.LRAUV\Project.Drawings\Project.ME.Dwgs\LRAUV\
Buoyancy Engine\valve actuator

NOTES: (CONT. FROM TITLE BLOCK)