



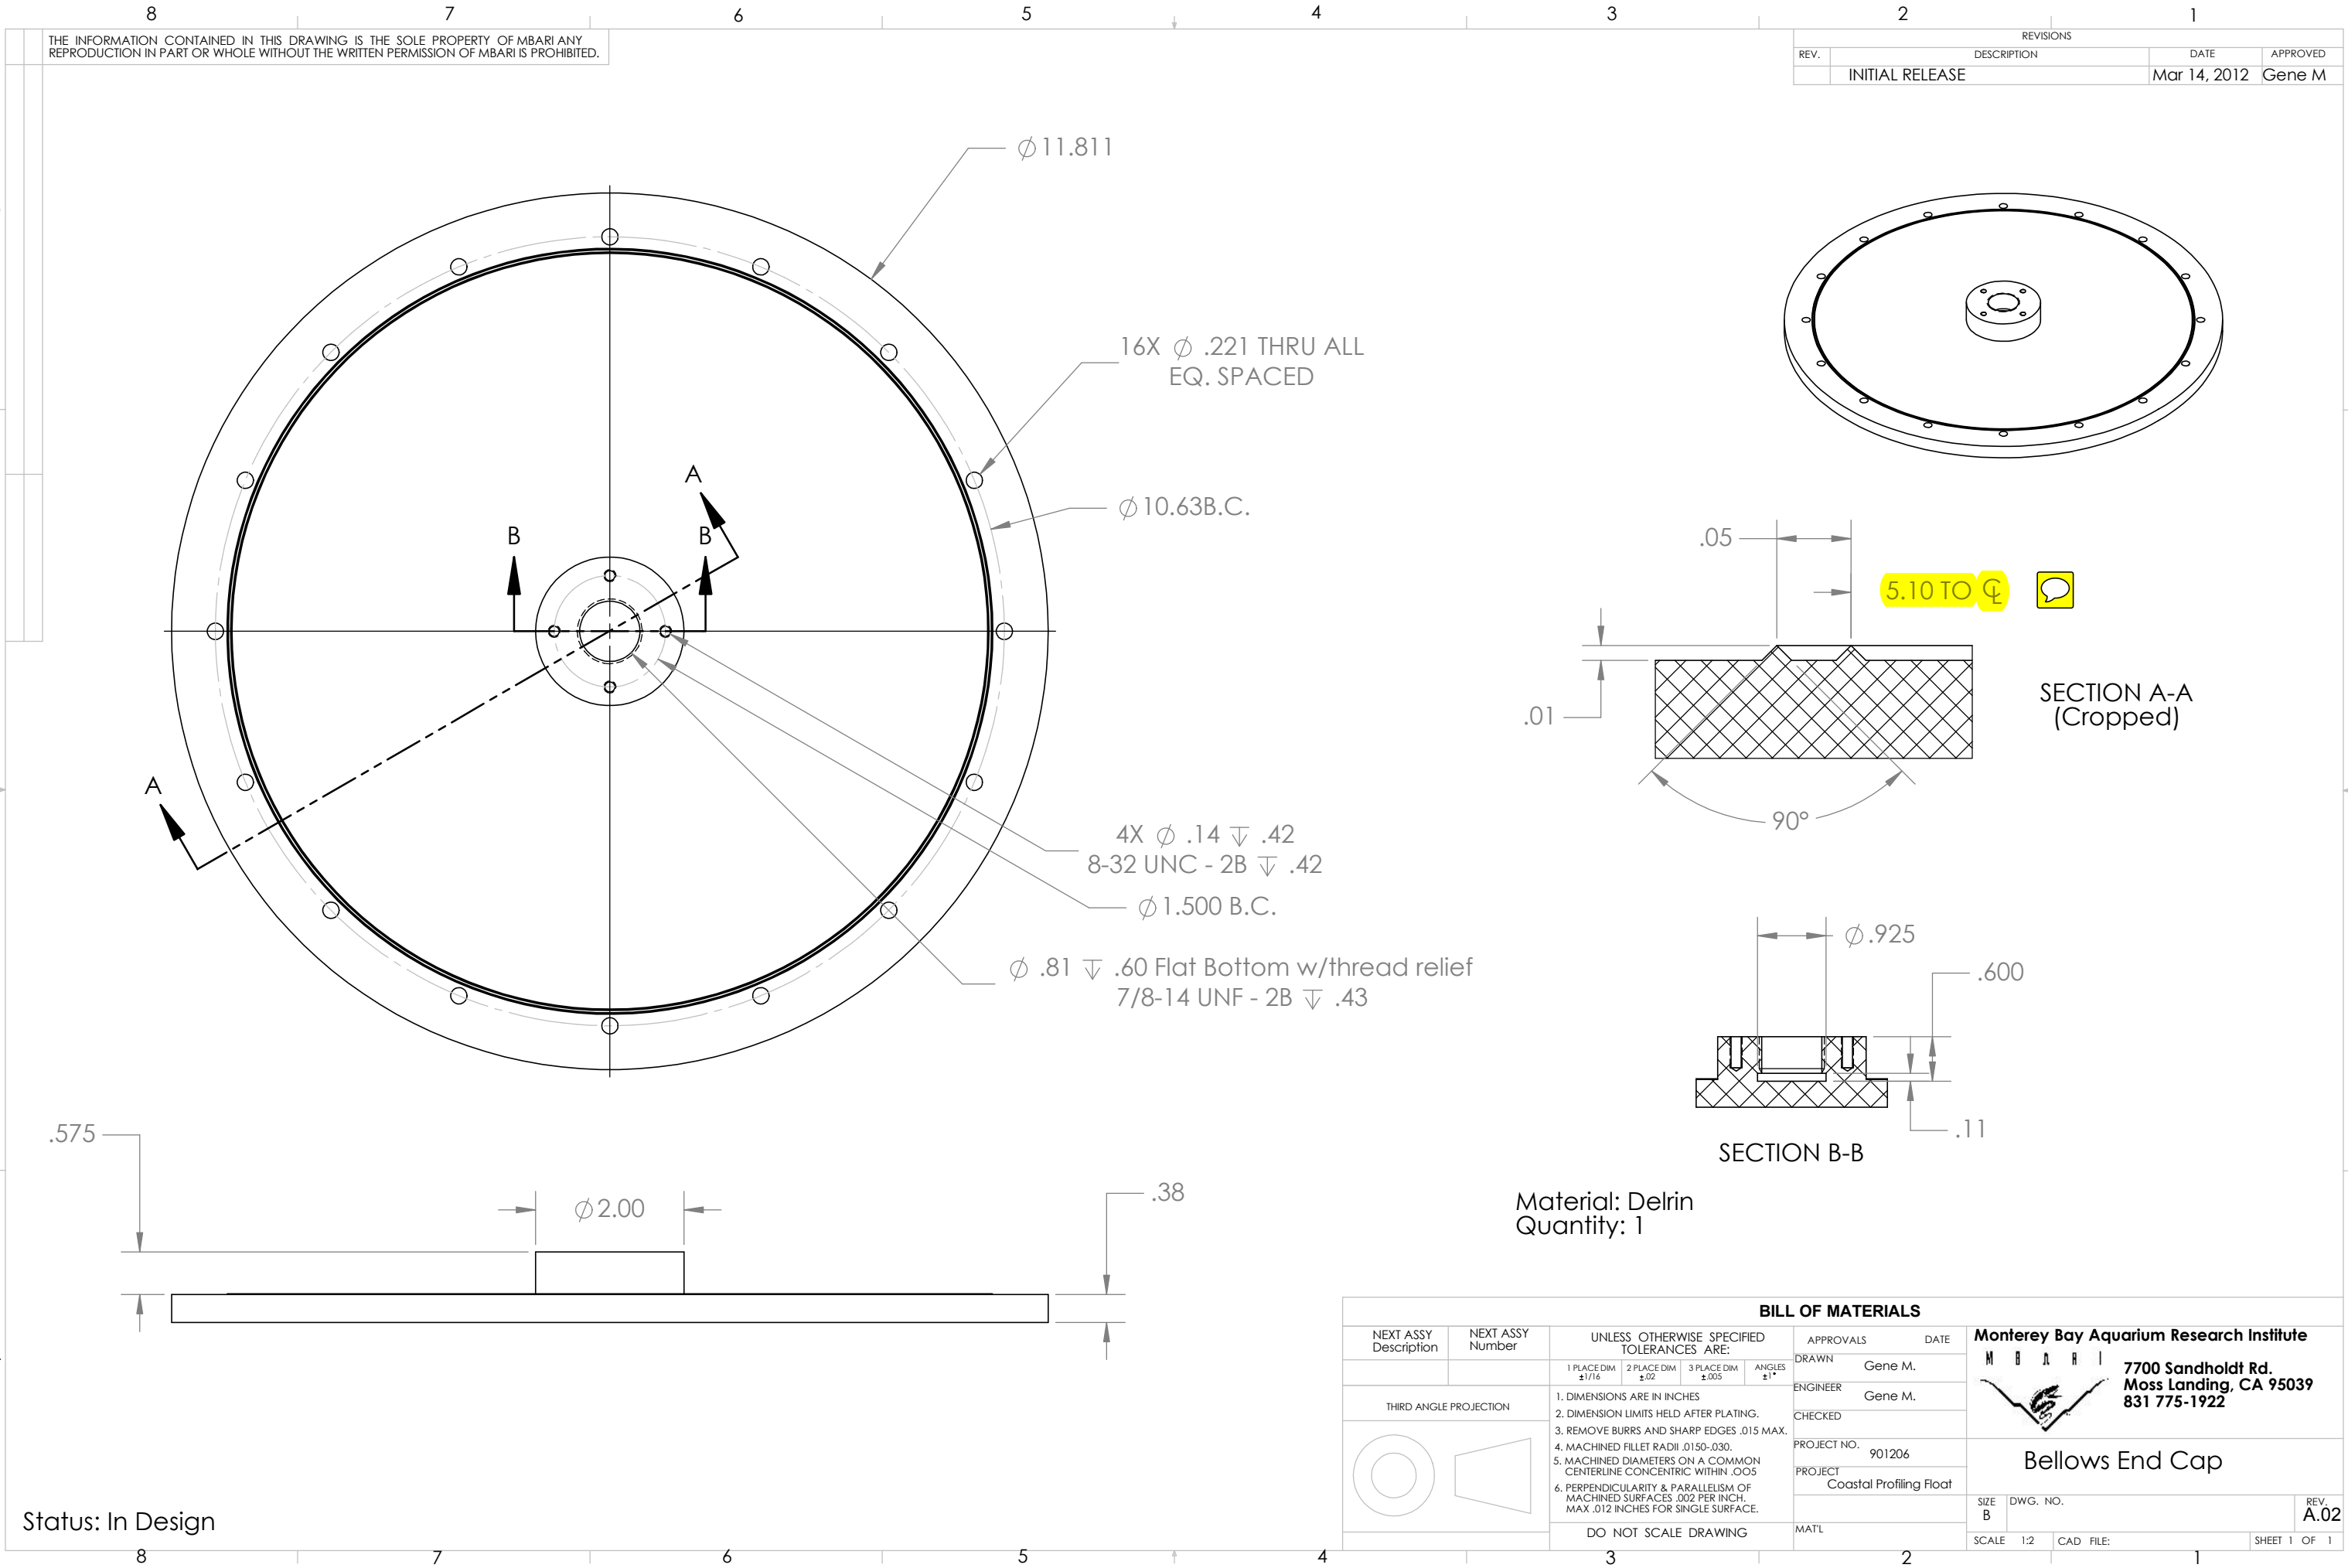

THE INFORMATION CONTAINED IN THIS DRAWING IS THE SOLE PROPERTY OF MBARI ANY REPRODUCTION IN PART OR WHOLE WITHOUT THE WRITTEN PERMISSION OF MBARI IS PROHIBITED.

REVISIONS			
REV.	DESCRIPTION	DATE	APPROVED
	INITIAL RELEASE	Mar 14, 2012	Gene M

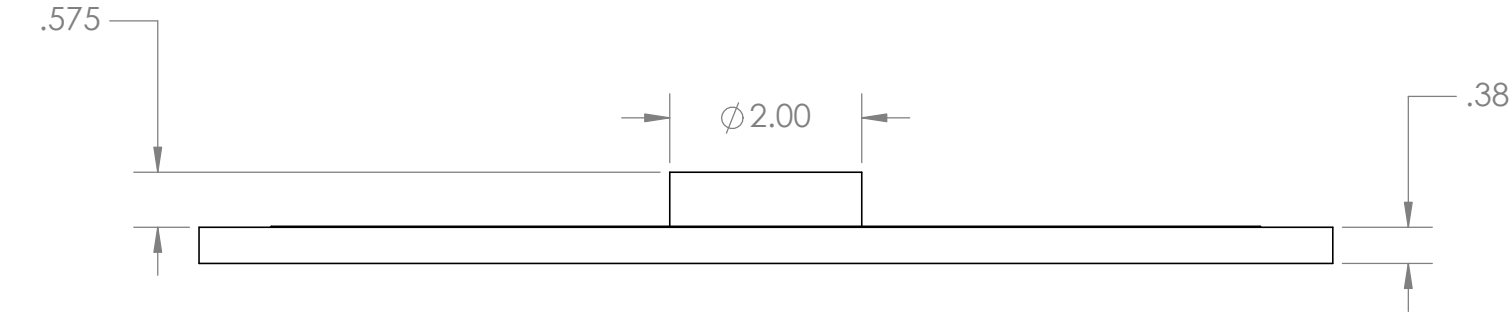

Material: Delrin
Quantity: 1

BILL OF MATERIALS			
NEXT ASSY Description	NEXT ASSY Number	UNLESS OTHERWISE SPECIFIED TOLERANCES ARE:	APPROVALS DATE
		1 PLACE DIM $\pm 1/16$	DRAWN Gene M.
		2 PLACE DIM $\pm .02$	ENGINEER Gene M.
		3 PLACE DIM $\pm .005$	CHECKED
		ANGLES $\pm 1^\circ$	PROJECT NO. 901206
THIRD ANGLE PROJECTION		1. DIMENSIONS ARE IN INCHES	PROJECT Coastal Profiling Float
		2. DIMENSION LIMITS HELD AFTER PLATING.	
		3. REMOVE BURRS AND SHARP EDGES .015 MAX.	
		4. MACHINED FILLET RADII .0150-.030.	
		5. MACHINED DIAMETERS ON A COMMON CENTERLINE CONCENTRIC WITHIN .005	
		6. PERPENDICULARITY & PARALLELISM OF MACHINED SURFACES .002 PER INCH. MAX .012 INCHES FOR SINGLE SURFACE.	
		DO NOT SCALE DRAWING	MAT'L
			SIZE B DWG. NO.
			SCALE 1:2 CAD FILE: SHEET 1 OF 1

Monterey Bay Aquarium Research Institute
7700 Sandholdt Rd.
Moss Landing, CA 95039
831 775-1922

Bellows End Cap

REV. A.02

Status: In Design