

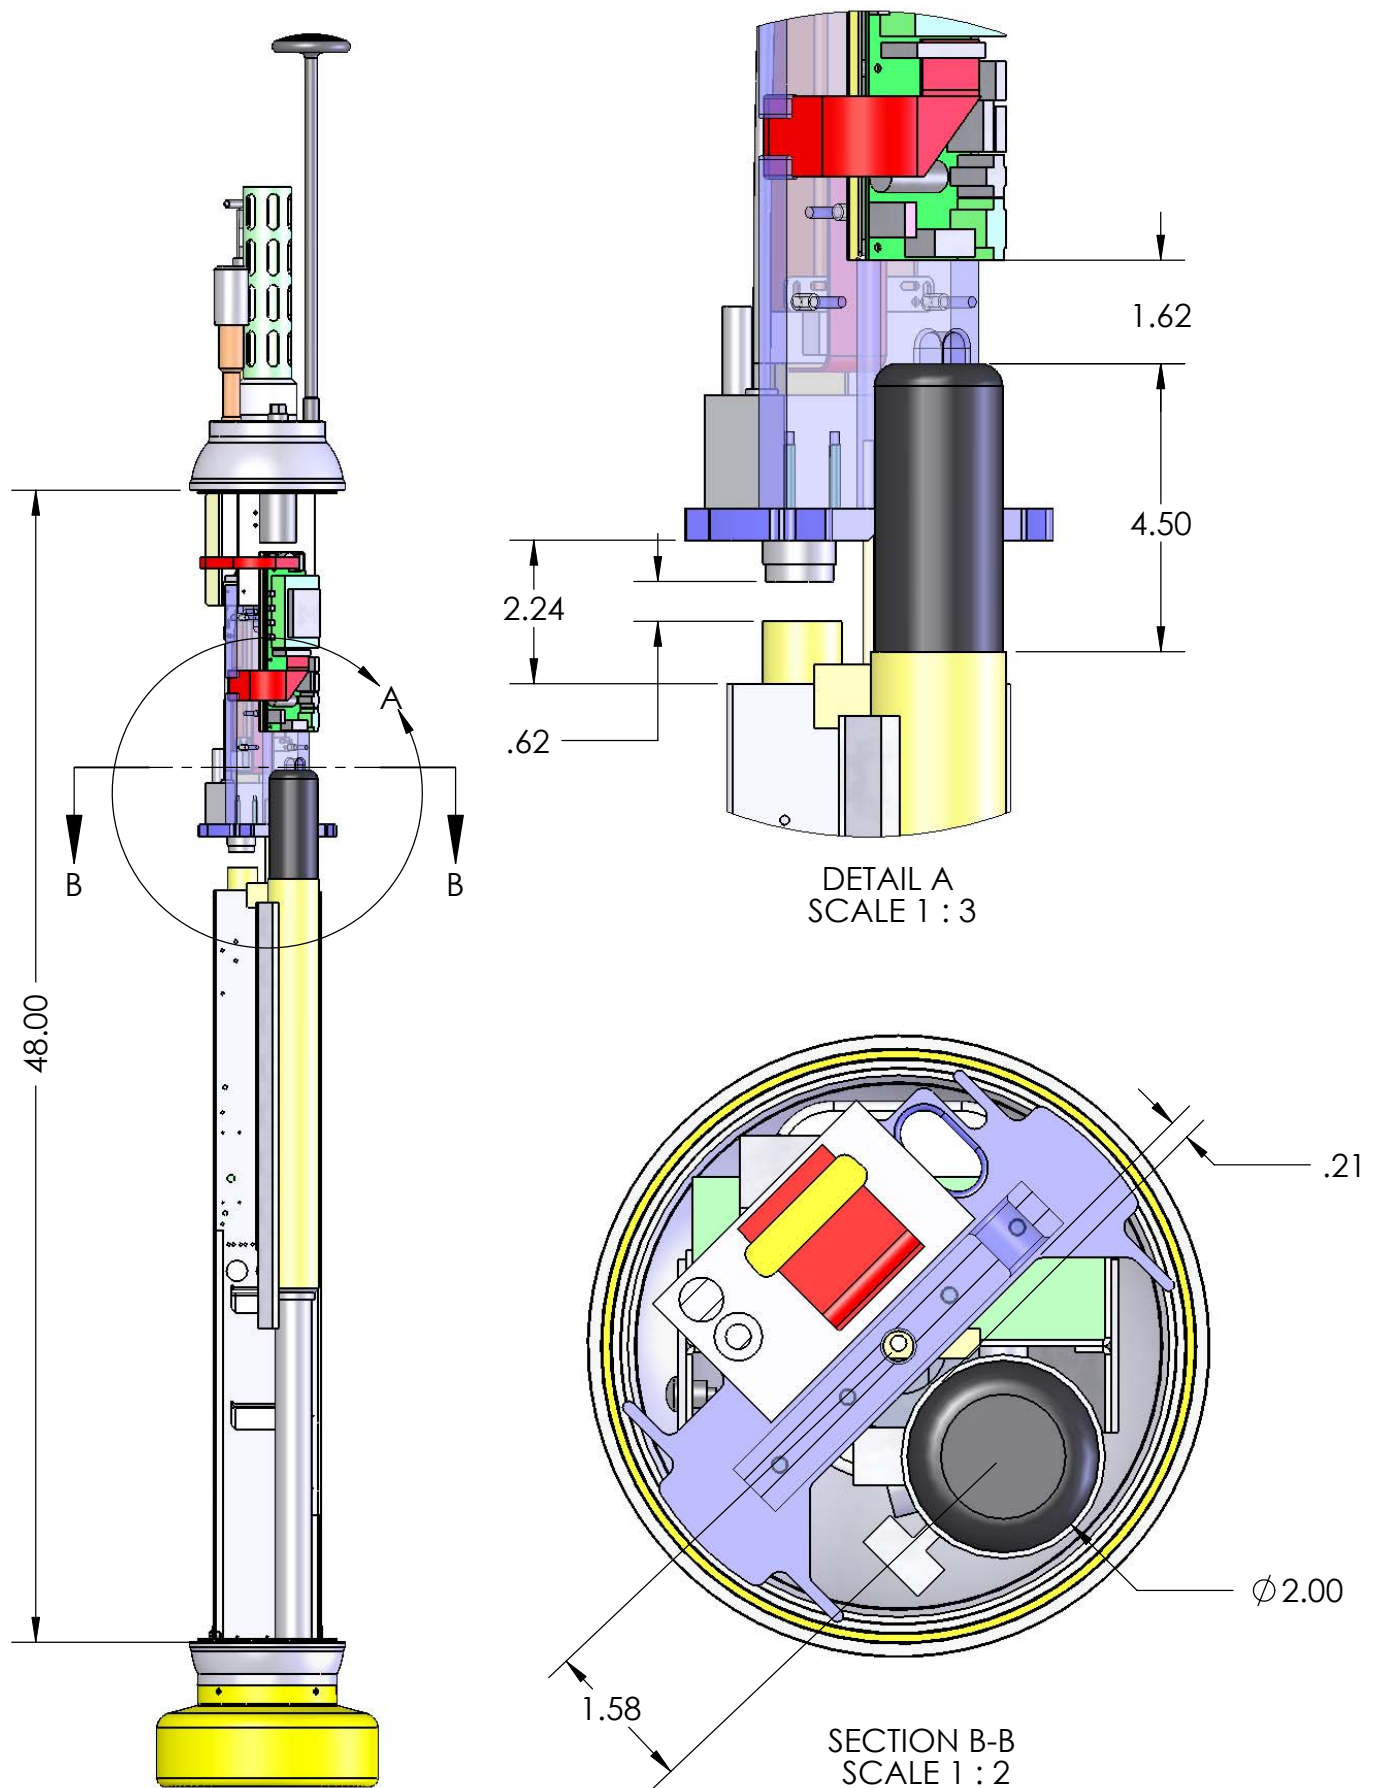


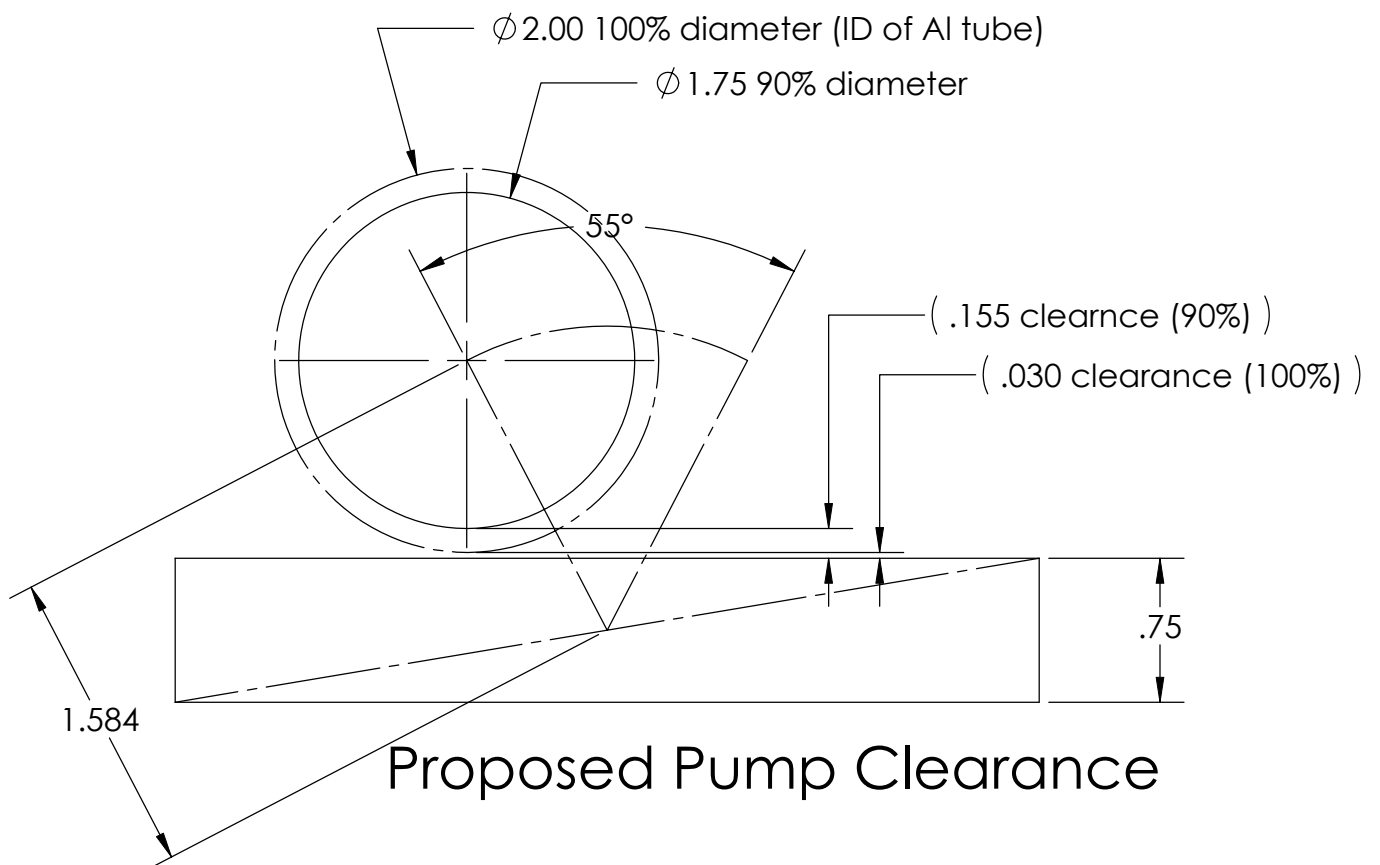

APEX+ISUS V2 fit and rotational tolerance

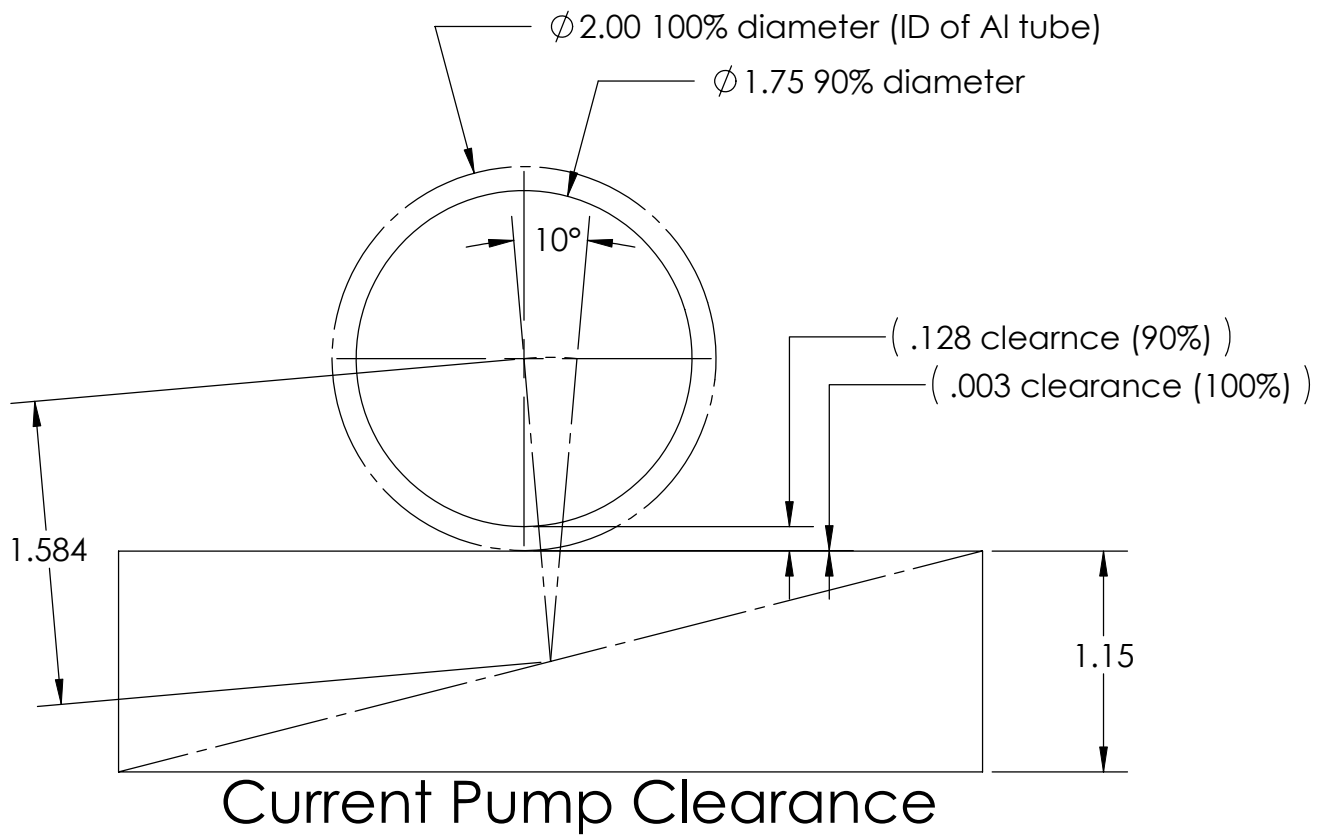

APEX+ISUS V2 fit and rotational tollerance