


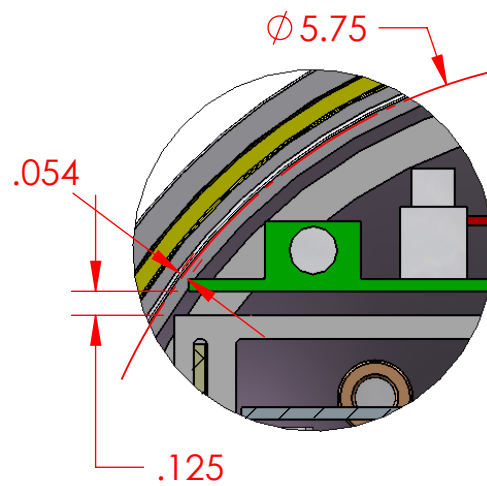
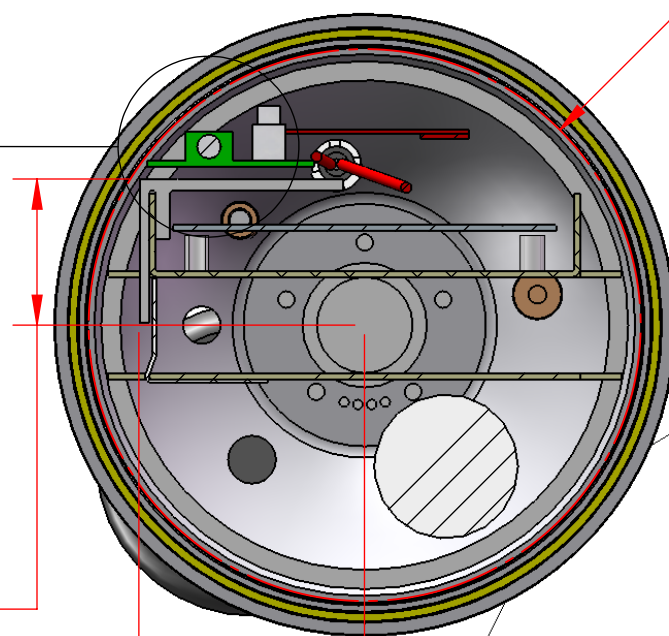





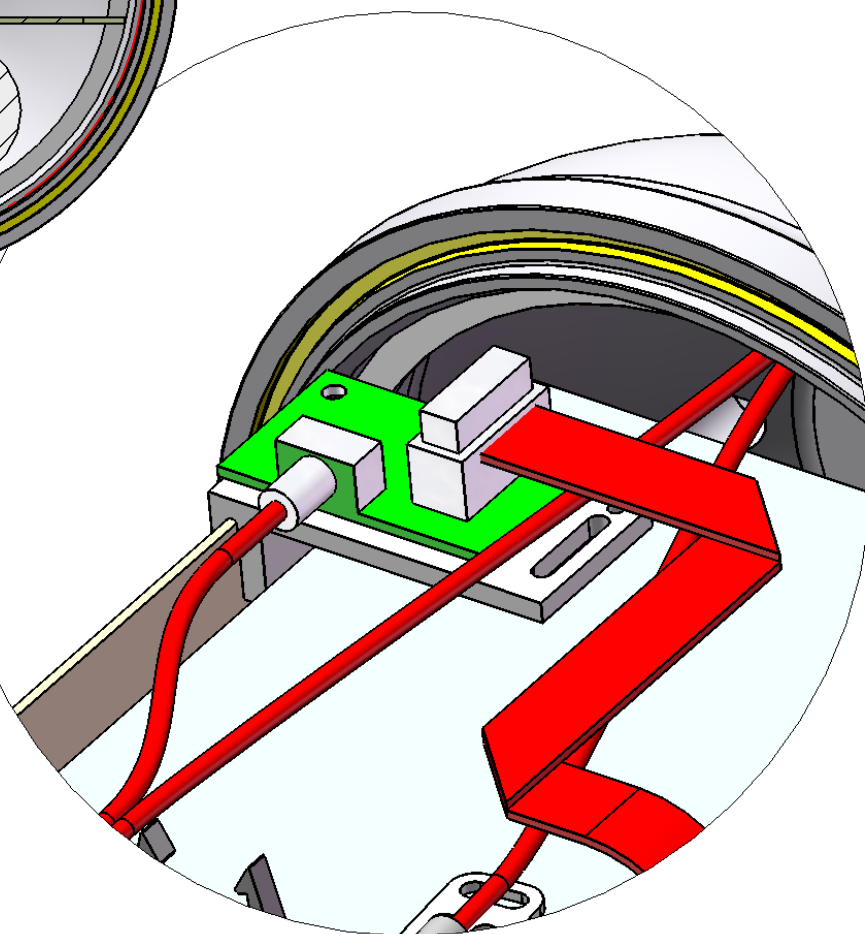


DETAIL B
SCALE 1 : 1

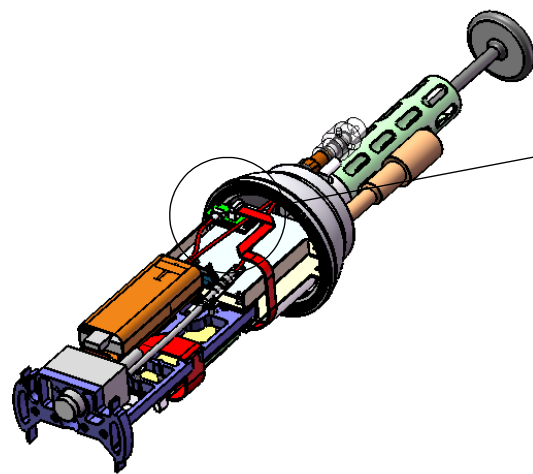

SECTION A-A
SCALE 1 : 2

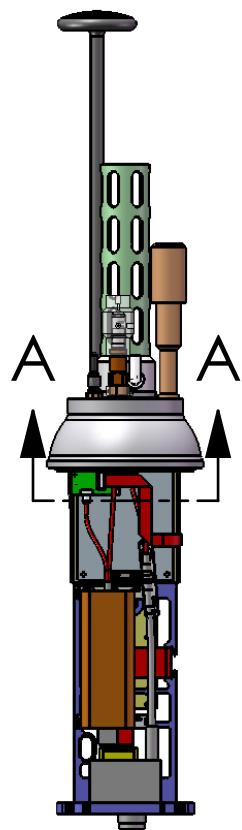

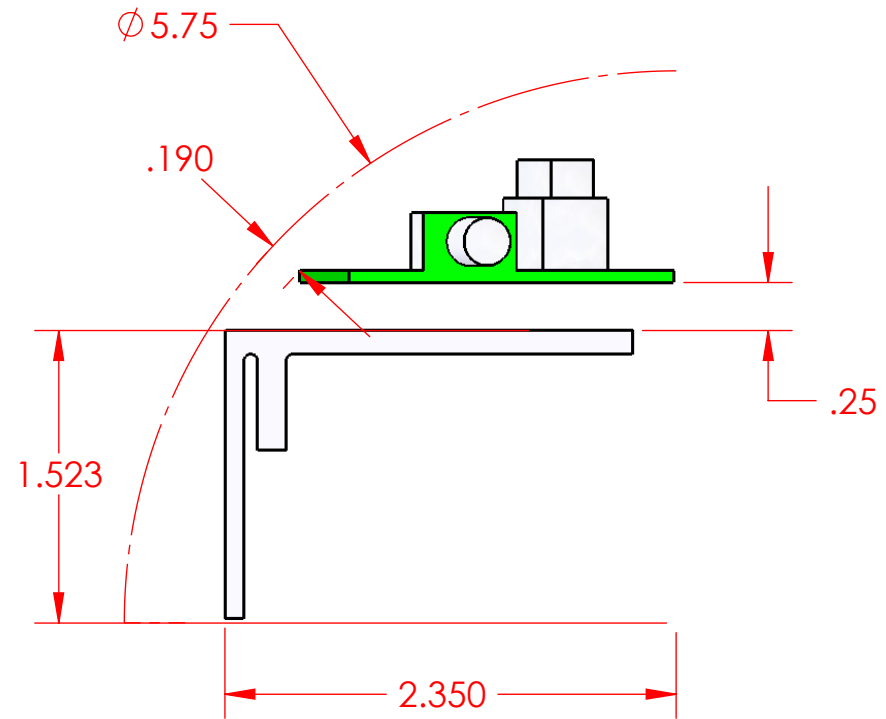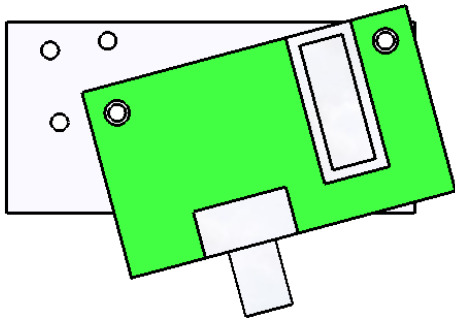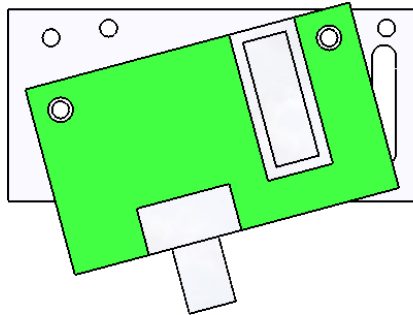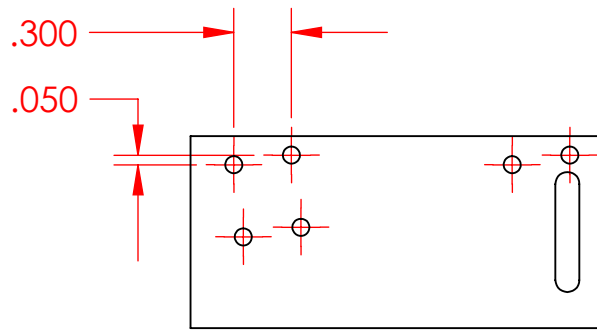

Suggestion:
 Add 3 new holes to reference support.
 Route fiber to light along right side
 of reference support.
 Allows 1/4" standoffs and increases
 board-to-housing from .054 to .190"