

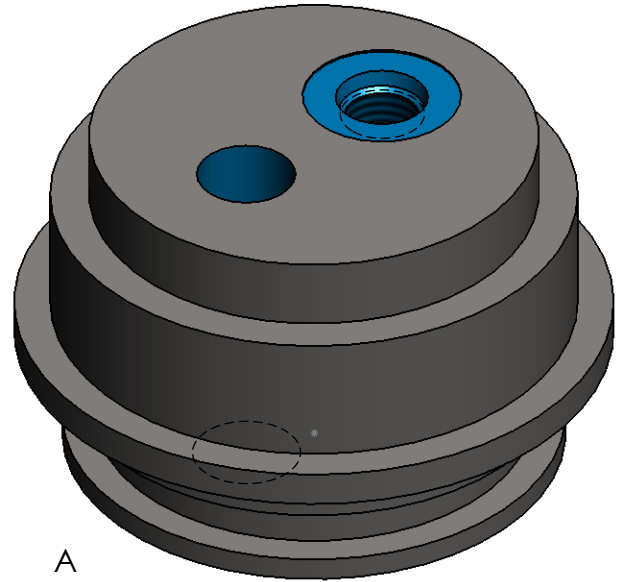


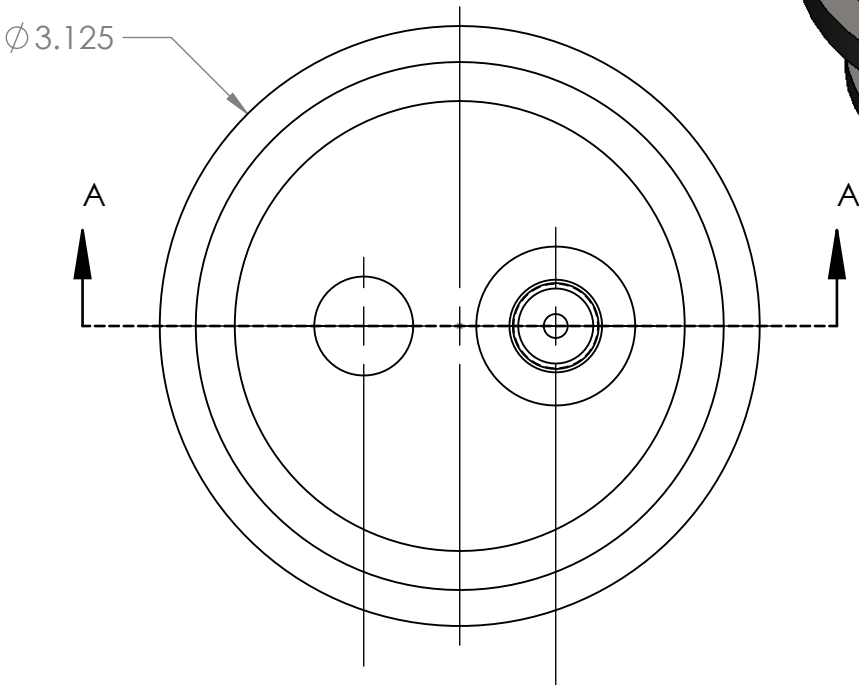

NOTE:
All exterior dimensions per
P-200647-08_EndCap.pdf

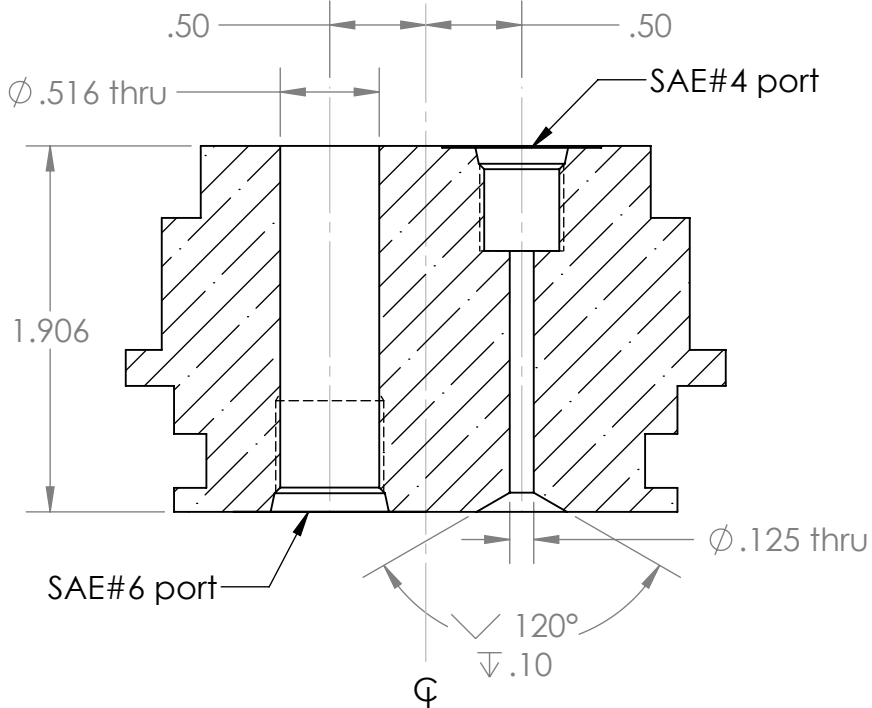

Pressure Chamber Endcap
for APEX pH testing

Modifications to drawing
P-200647-08_EndCap.pdf
Material Gr 2 Titanium

Hans Jannasch/MBARI
Versio 1.0; 11/29/12

SECTION A-A
SCALE 1 : 1