



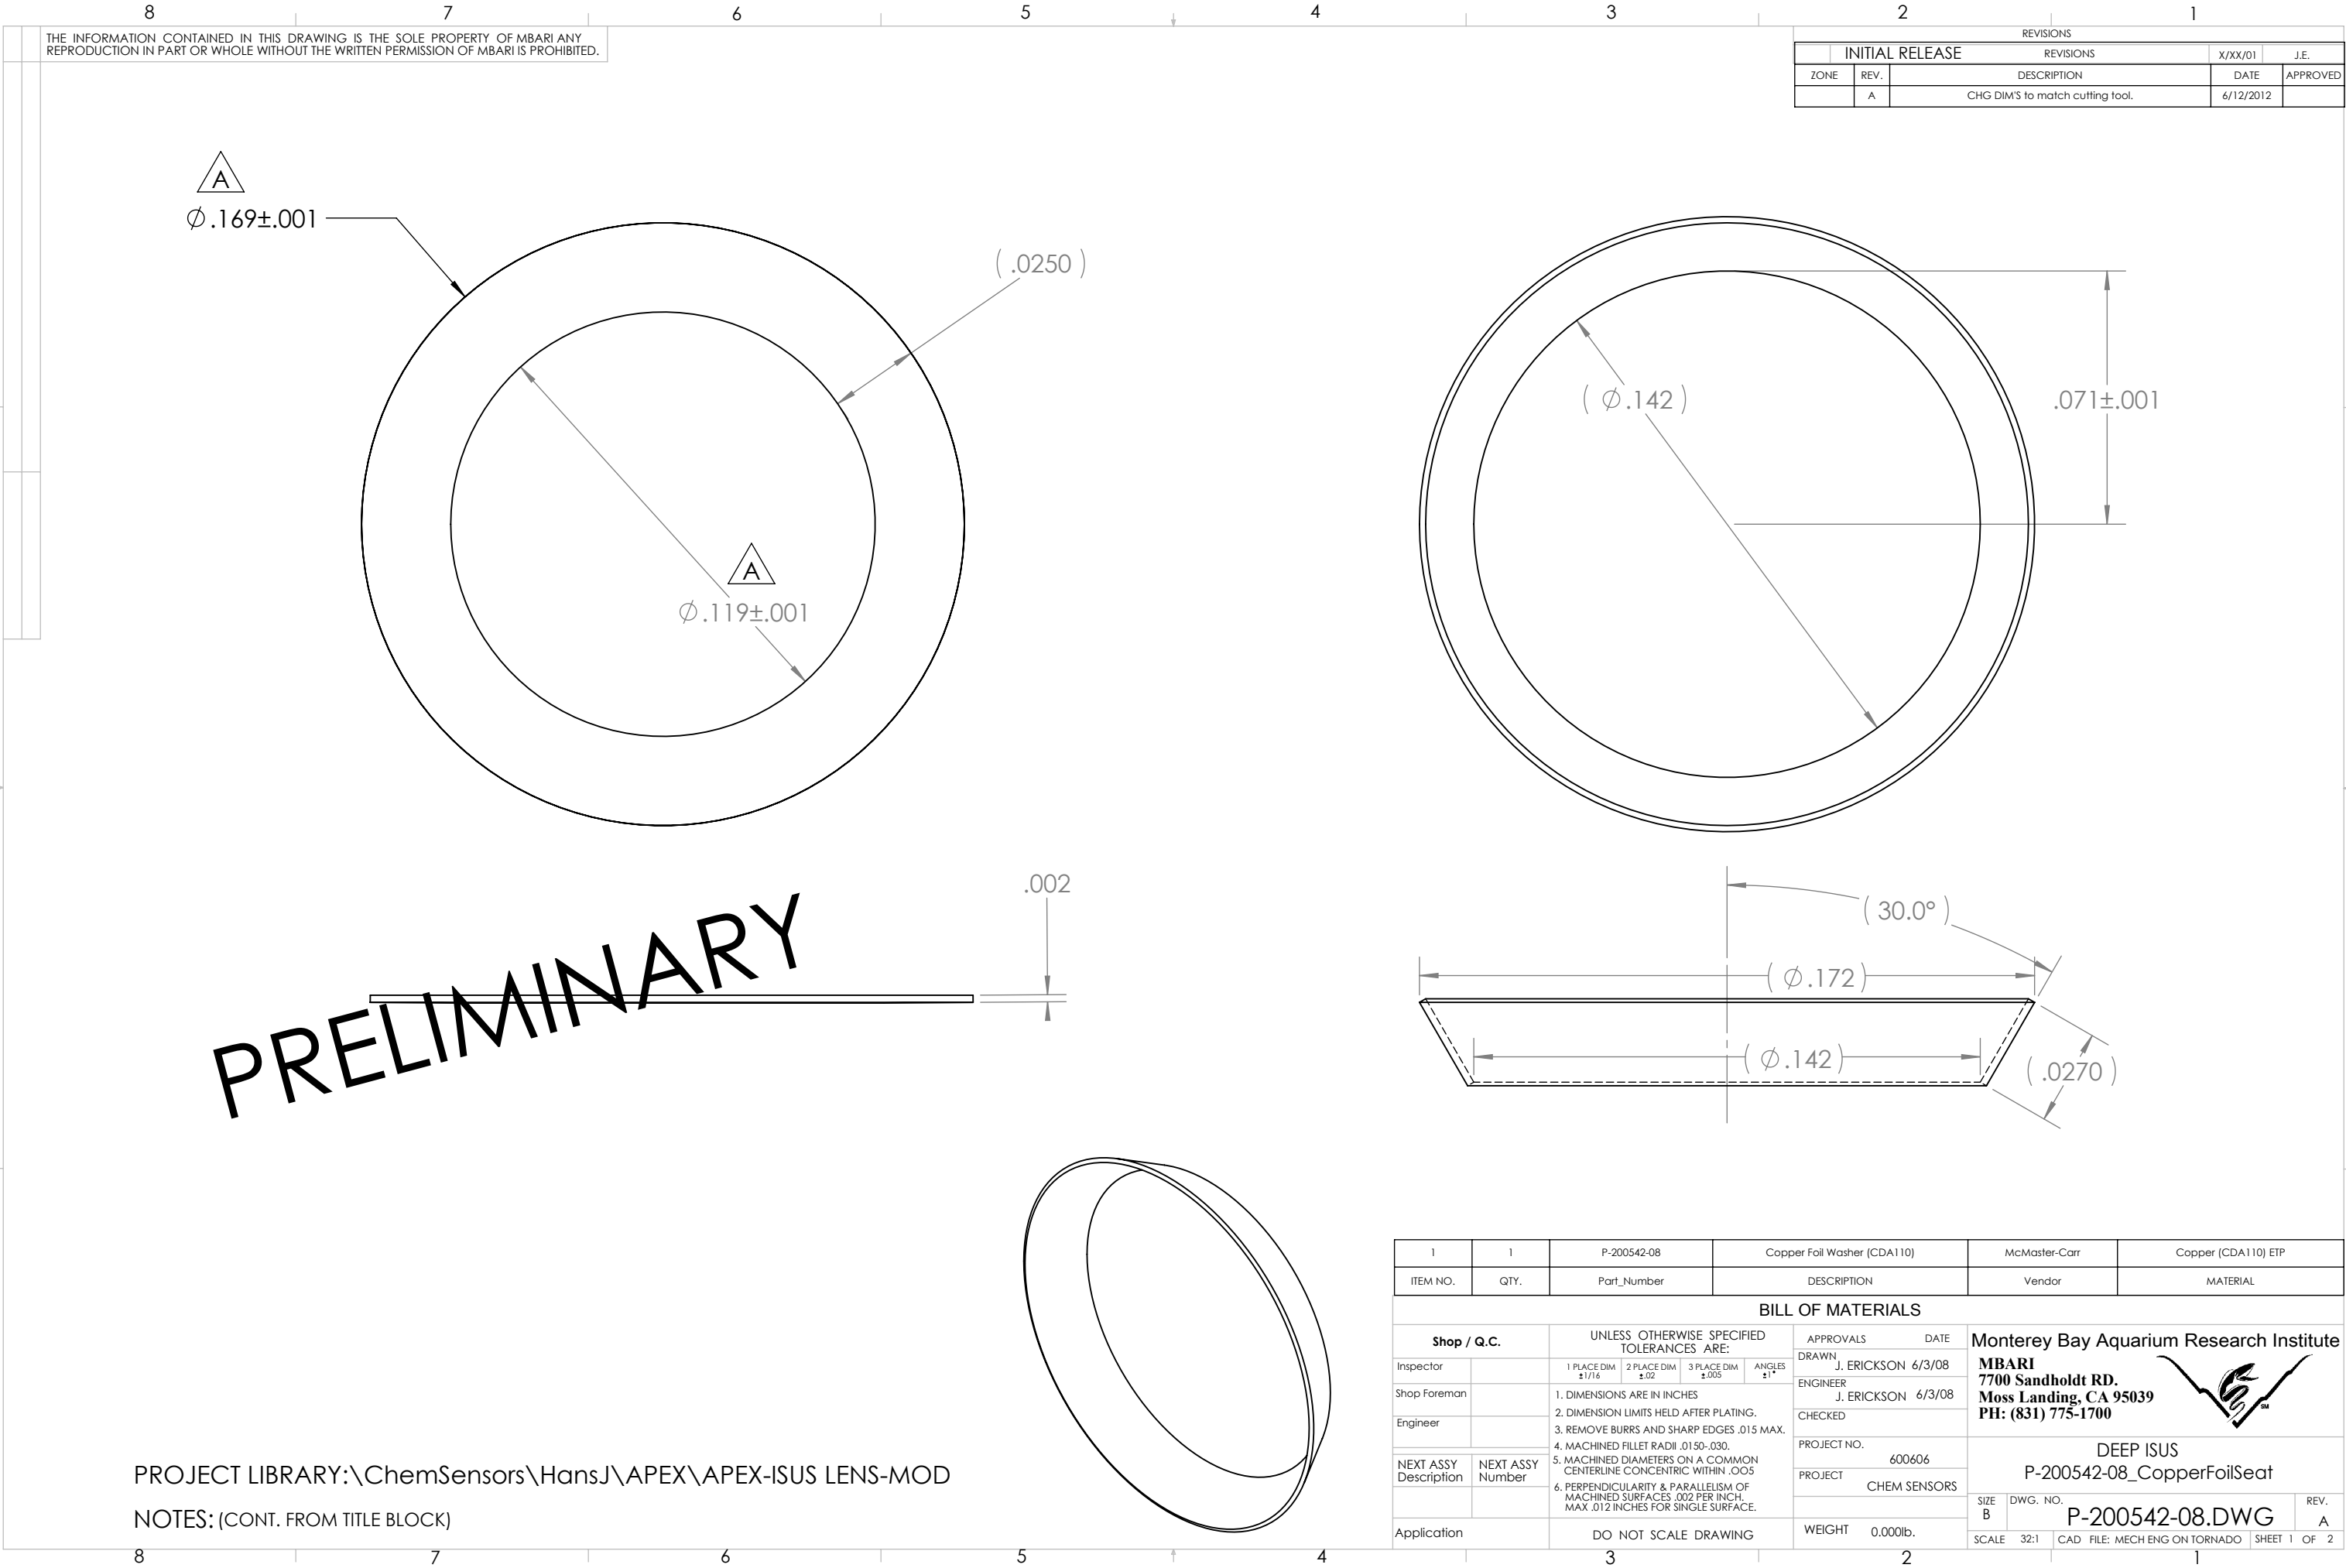

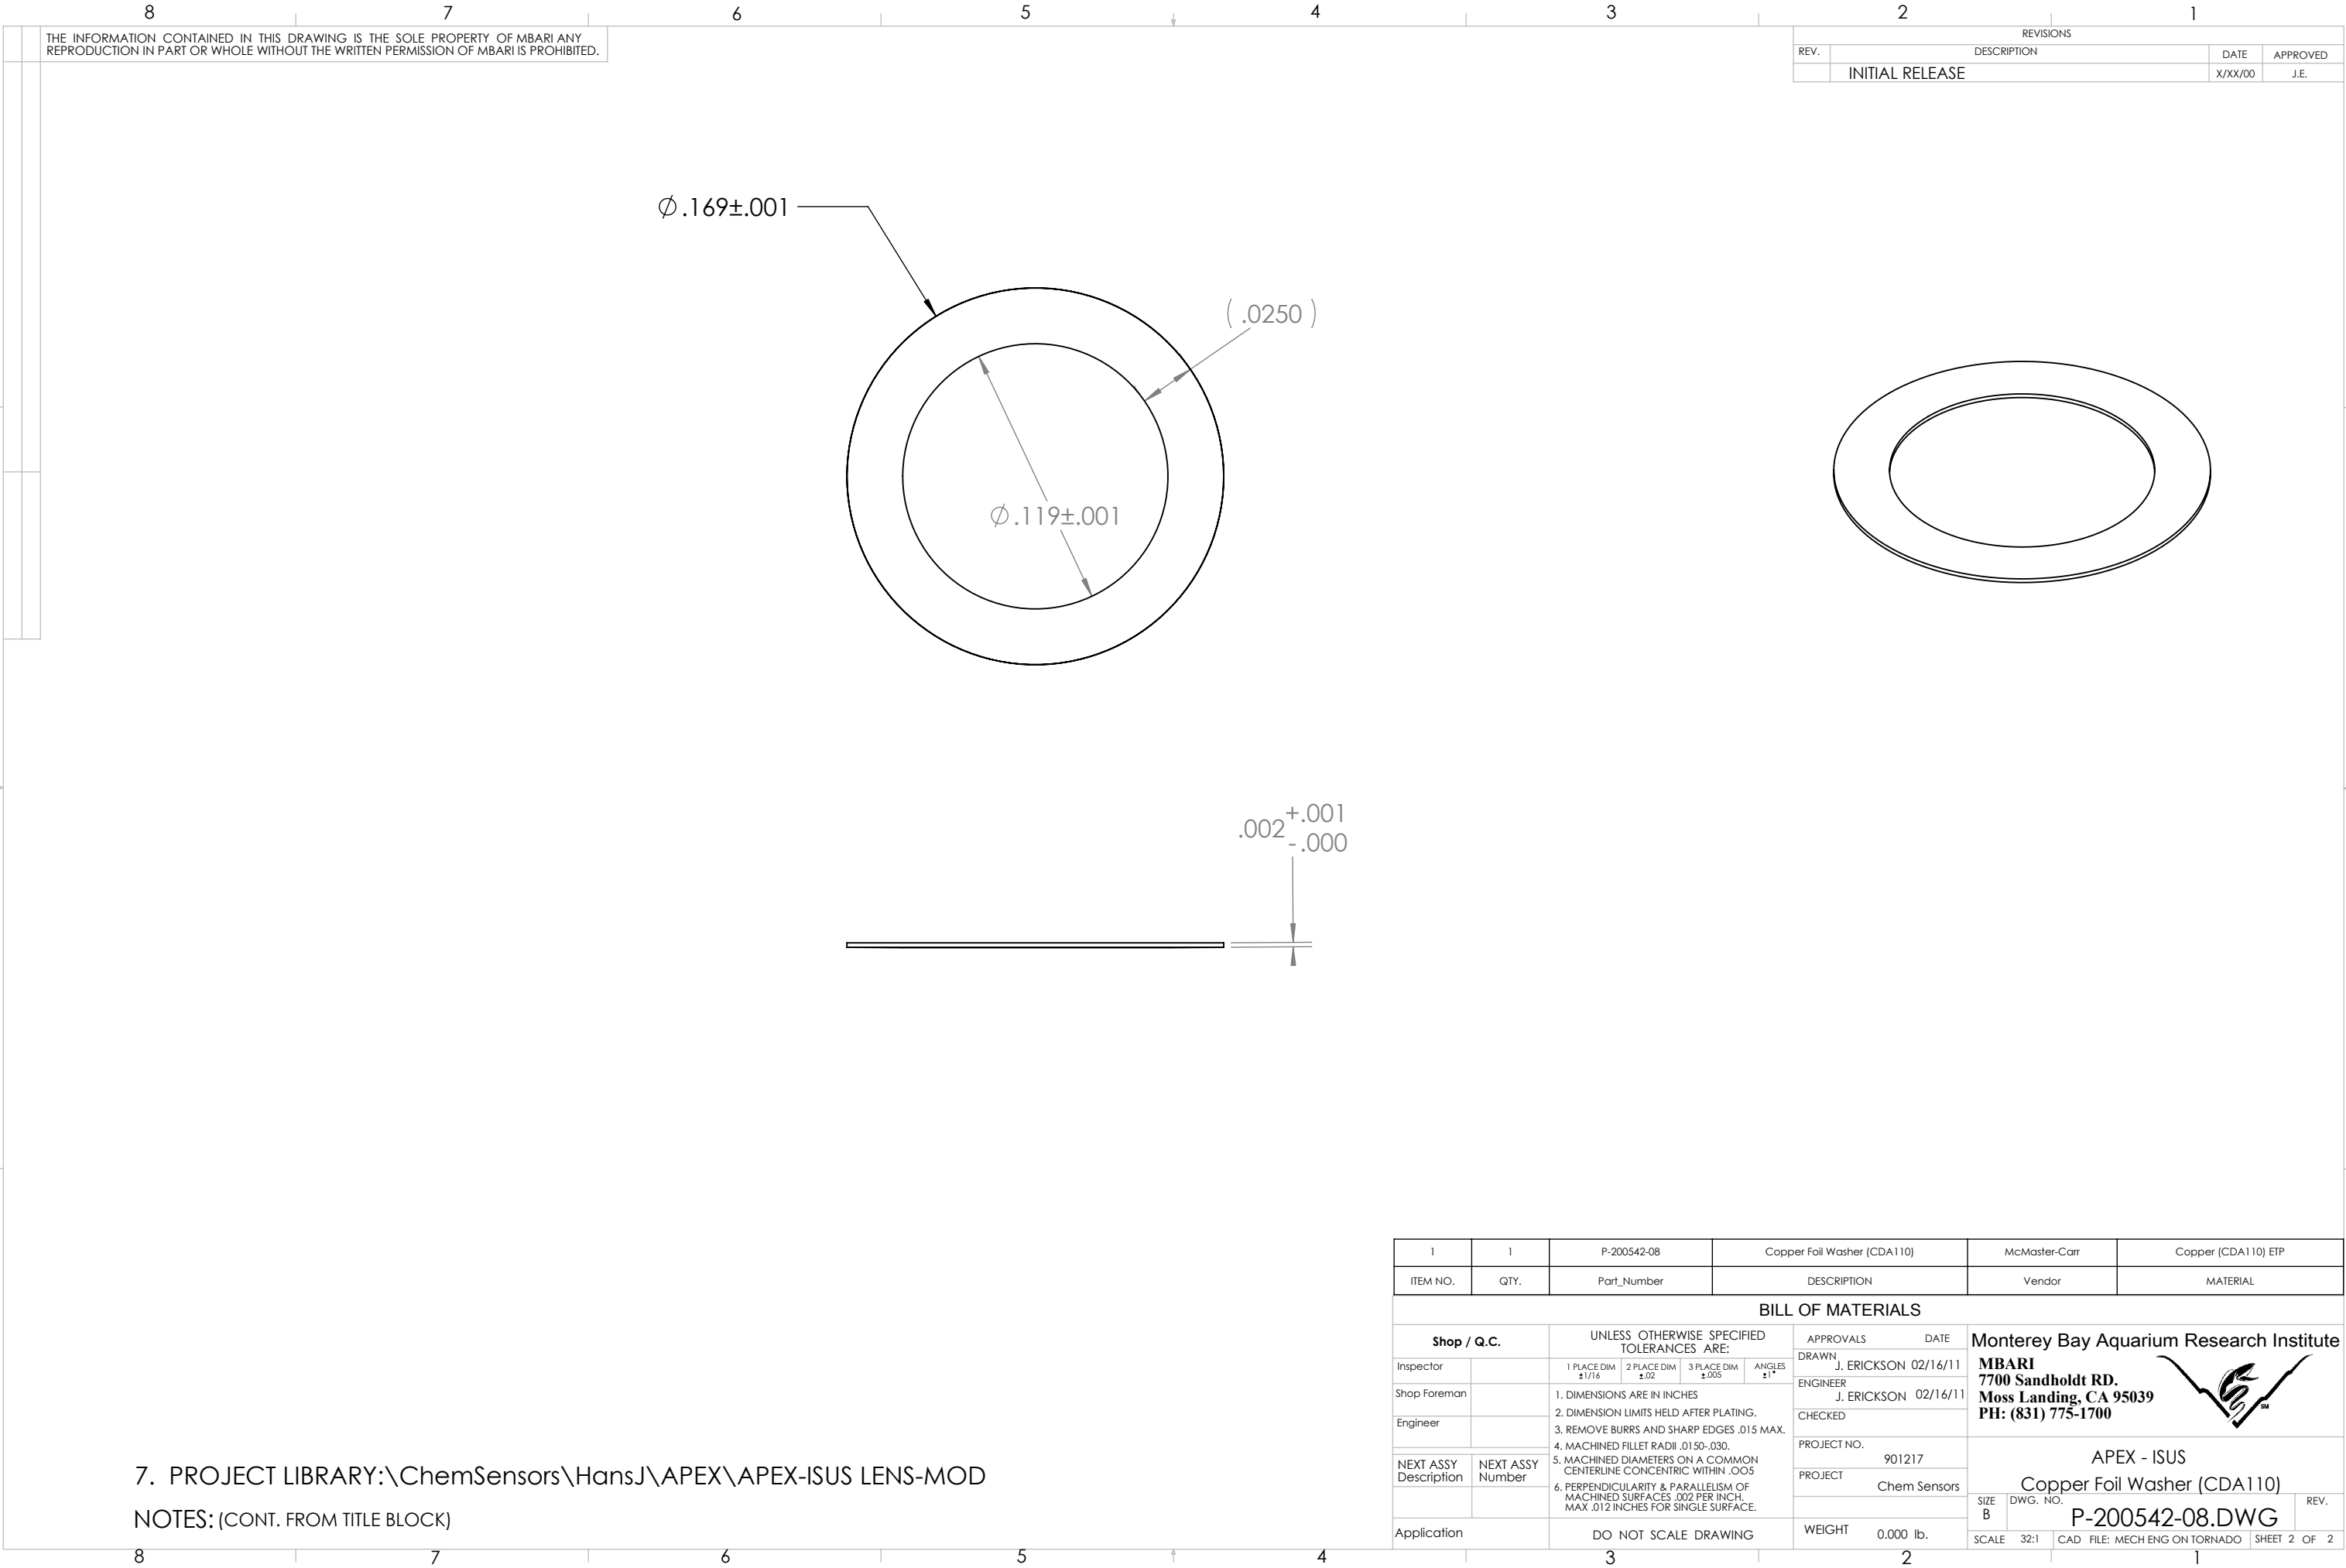

THE INFORMATION CONTAINED IN THIS DRAWING IS THE SOLE PROPERTY OF MBARI ANY REPRODUCTION IN PART OR WHOLE WITHOUT THE WRITTEN PERMISSION OF MBARI IS PROHIBITED.

REVISIONS			
REV.	DESCRIPTION	DATE	APPROVED
	INITIAL RELEASE	X/XX/00	J.E.

7. PROJECT LIBRARY:\ChemSensors\HansJ\APEX\APEX-ISUS LENS-MOD

NOTES: (CONT. FROM TITLE BLOCK)

1	1	P-200542-08	Copper Foil Washer (CDA110)	McMaster-Carr	Copper (CDA110) ETP
ITEM NO.	QTY.	Part_Number	DESCRIPTION	Vendor	MATERIAL
BILL OF MATERIALS					
Shop / Q.C.		UNLESS OTHERWISE SPECIFIED TOLERANCES ARE:		APPROVALS DATE	
Inspector		1 PLACE DIM $\pm 1/16$	2 PLACE DIM $\pm .02$	3 PLACE DIM $\pm .005$	ANGLES $\pm 1^\circ$
Shop Foreman		1. DIMENSIONS ARE IN INCHES		DRAWN J. ERICKSON 02/16/11	
Engineer		2. DIMENSION LIMITS HELD AFTER PLATING.		ENGINEER J. ERICKSON 02/16/11	
		3. REMOVE BURRS AND SHARP EDGES .015 MAX.		CHECKED	
		4. MACHINED FILLET RADII .0150-.030.		PROJECT NO. 901217	
NEXT ASSY Description	NEXT ASSY Number	5. MACHINED DIAMETERS ON A COMMON CENTERLINE CONCENTRIC WITHIN .005		PROJECT Chem Sensors	
		6. PERPENDICULARITY & PARALLELISM OF MACHINED SURFACES .002 PER INCH. MAX .012 INCHES FOR SINGLE SURFACE.		WEIGHT 0.000 lb.	
Application		DO NOT SCALE DRAWING		SIZE B	
				SCALE 32:1	CAD FILE: MECH ENG ON TORNADO

Monterey Bay Aquarium Research Institute

MBARI

7700 Sandholdt RD.

Moss Landing, CA 95039

PH: (831) 775-1700

APEX - ISUS

Copper Foil Washer (CDA110)

P-200542-08.DWG

SHEET 2 OF 2

REV.