
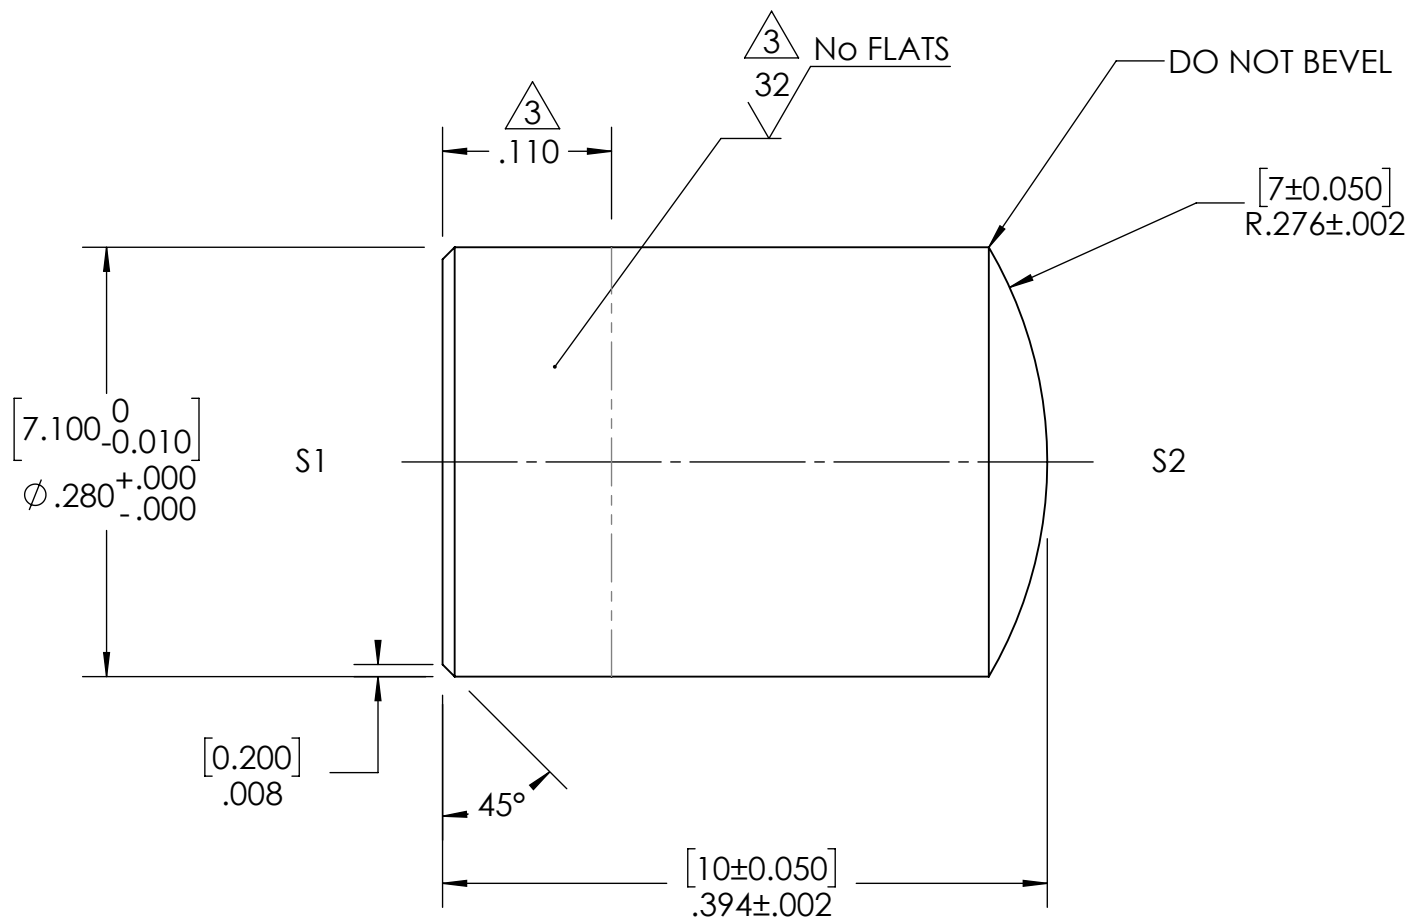



THE INFORMATION CONTAINED IN THIS DRAWING IS THE SOLE PROPERTY OF MBARI ANY REPRODUCTION IN PART OR WHOLE WITHOUT THE WRITTEN PERMISSION OF MBARI IS PROHIBITED.

REVISIONS					
ZONE	INITIAL	RELEASE	DESCRIPTION	X/DATE	APPROVED
B2	3		ADDED SURFACE FINISH & DIM'S	9/21/2020	J.E.

SURFACE DATA TABLE								
SURFACE	RADIUS	TOL.	CCV	CVX	POWER	IRR	SCR/DIG	CA
S1	PLANO	1/2 fr P-V					60-40	5.0
S2	7.00	+/- .050		X		1 fr	60-40	5.0

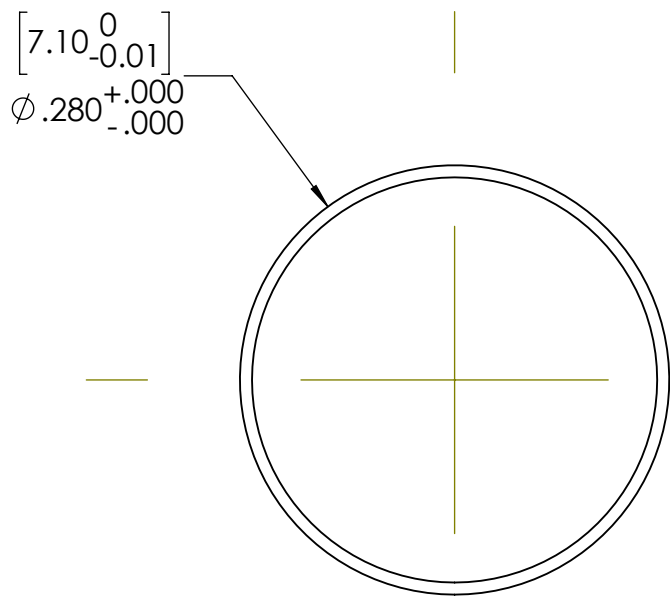

1. Element per MIL-PRF-13830.
2. S1, S2 polished - other surfaces fine ground.
3. Bevel S1 only at 45° X 0.2 ± 0.1 deep (leg).
4. Flatness and irregularity are fringes @ 633nm
5. Centering < 6 minutes deviation.

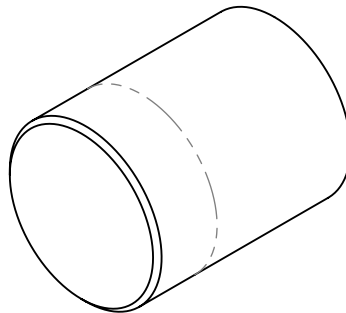

7. PROJECT LIBRARY:\ChemSensors\JonE\Equitech_LR4_Lens_Retainer

NOTES: (CONT. FROM TITLE BLOCK)

1	1	L4b-UV Rev.3	EquiTech Lens Rev.3	PFG Optics	Corning 7980 Standard UV Grade 2-F
ITEM NO.	QTY.	Part_Number	DESCRIPTION	Vendor	MATERIAL

BILL OF MATERIALS						
Shop / Q.C.		UNLESS OTHERWISE SPECIFIED TOLERANCES ARE:			APPROVALS DATE	
Inspector		1 PLACE DIM ±1/16	2 PLACE DIM ±.02	3 PLACE DIM ±.005	ANGLES ±1°	DRAWN J. ERICKSON
Shop Foreman		1. DIMENSIONS ARE IN INCHES 2. DIMENSION LIMITS HELD AFTER PLATING. 3. REMOVE BURRS AND SHARP EDGES .015 MAX. 4. MACHINED FILLET RADI .0150-.030. 5. MACHINED DIAMETERS ON A COMMON CENTERLINE CONCENTRIC WITHIN .005 6. PERPENDICULARITY & PARALLELISM OF MACHINED SURFACES .002 PER INCH. MAX .012 INCHES FOR SINGLE SURFACE.				ENGINEER J. ERICKSON
Engineer						CHECKED
						PROJECT NO. 901217
NEXT ASSY Description	NEXT ASSY Number					PROJECT CHEM S.
	A-201672-14					
Application		DO NOT SCALE DRAWING			WEIGHT 0.002	
Monterey Bay Aquarium Research Institute MBARI 7700 Sandholdt RD. Moss Landing, CA 95039 PH: (831) 775-1700  EQUITECH - ISUS PROBE EquiTech Lens Rev.3 Fused Silica 7.1mm PL/CX1 SIZE B DWG. NO. L4b-UV Rev.3.DWG 3 REV. SCALE 8:1 CAD FILE: MECH ENG ON TORNADO SHEET 1 OF 1						