


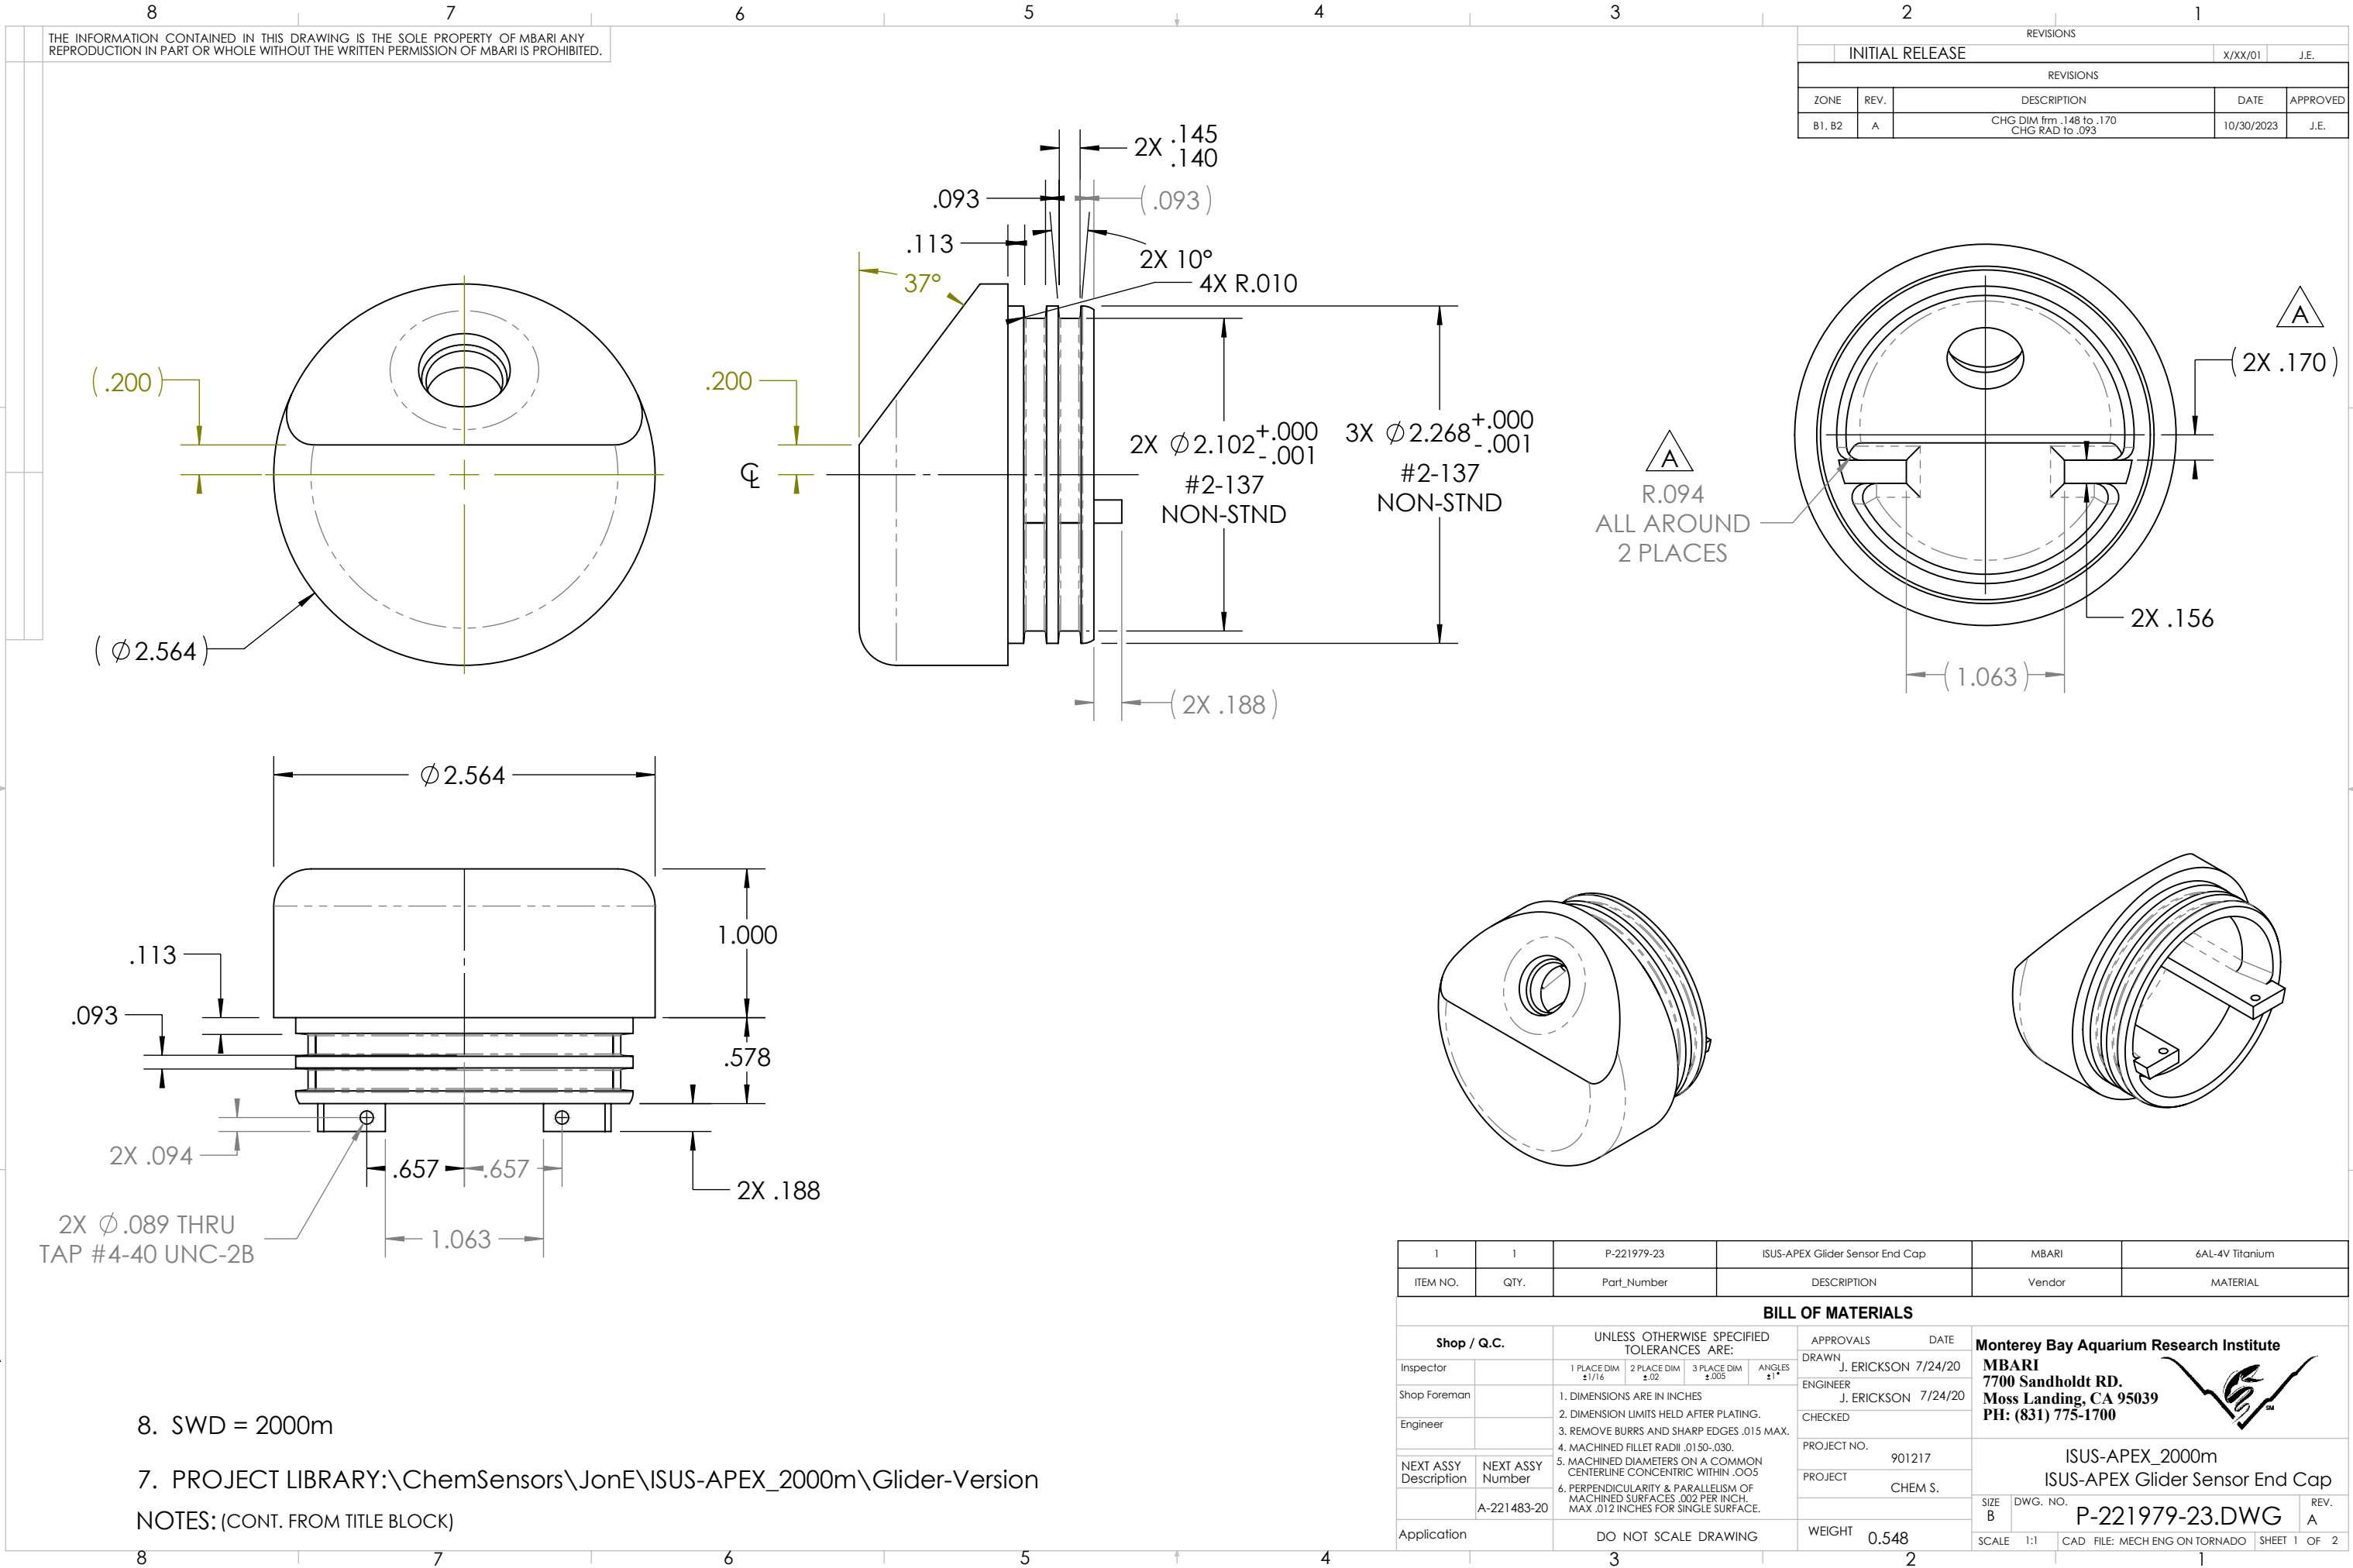

THE INFORMATION CONTAINED IN THIS DRAWING IS THE SOLE PROPERTY OF MBARI. ANY REPRODUCTION IN PART OR WHOLE WITHOUT THE WRITTEN PERMISSION OF MBARI IS PROHIBITED.

REVISIONS				
INITIAL RELEASE			X/XX/01	J.E.
REVISIONS				
ZONE	REV.	DESCRIPTION	DATE	APPROVED
B1, B2	A	CHG DIM frm .148 to .170 CHG RAD to .093	10/30/2023	J.E.

1	1	P-221979-23	ISUS-APEX Glider Sensor End Cap	MBARI	6AL-4V Titanium
ITEM NO.	QTY.	Part_Number	DESCRIPTION	Vendor	MATERIAL
BILL OF MATERIALS					
Shop / Q.C.		UNLESS OTHERWISE SPECIFIED TOLERANCES ARE:		APPROVALS DATE	
Inspector		1 PLACE DIM $\pm 1/16$	2 PLACE DIM $\pm .02$	3 PLACE DIM $\pm .005$	ANGLES $\pm 1^\circ$
Shop Foreman		1. DIMENSIONS ARE IN INCHES		DRAWN J. ERICKSON 7/24/20	
Engineer		2. DIMENSION LIMITS HELD AFTER PLATING.		ENGINEER J. ERICKSON 7/24/20	
		3. REMOVE BURRS AND SHARP EDGES .015 MAX.		CHECKED	
		4. MACHINED FILLET RADII .0150-.030.		PROJECT NO. 901217	
NEXT ASSY Description		5. MACHINED DIAMETERS ON A COMMON CENTERLINE CONCENTRIC WITHIN .005		PROJECT CHEM S.	
		6. PERPENDICULARITY & PARALLELISM OF MACHINED SURFACES .002 PER INCH, MAX .012 INCHES FOR SINGLE SURFACE.		WEIGHT 0.548	
Application		DO NOT SCALE DRAWING		SIZE B DWG. NO. P-221979-23.DWG	
				SCALE 1:1 CAD FILE: MECH ENG ON TORNADO SHEET 1 OF 2	

Monterey Bay Aquarium Research Institute
MBARI
7700 Sandholdt RD.
Moss Landing, CA 95039
PH: (831) 775-1700



ISUS-APEX_2000m
ISUS-APEX Glider Sensor End Cap
P-221979-23.DWG
A


THE INFORMATION CONTAINED IN THIS DRAWING IS THE SOLE PROPERTY OF MBARI ANY REPRODUCTION IN PART OR WHOLE WITHOUT THE WRITTEN PERMISSION OF MBARI IS PROHIBITED.

REVISIONS			
REV.	DESCRIPTION	DATE	APPROVED
	INITIAL RELEASE	X/XX/00	J.E.



SAE #6
Ø.516 THRU
9/16-18 UNF-2B

S.F. Ø 1.000


32 C

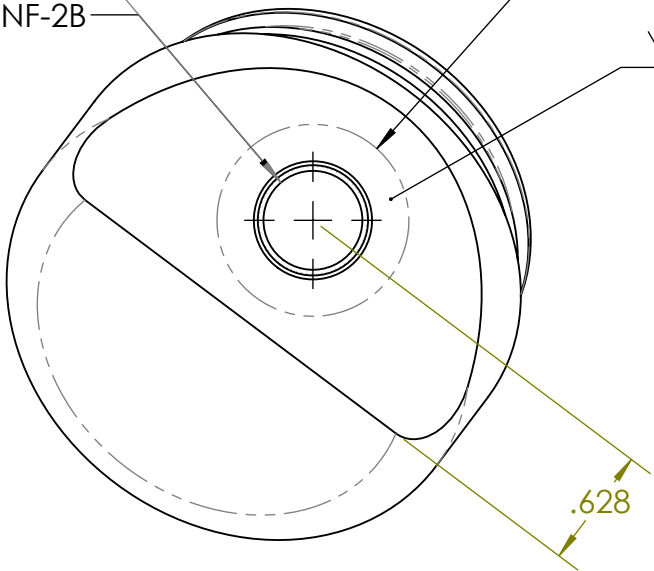

VIEW B

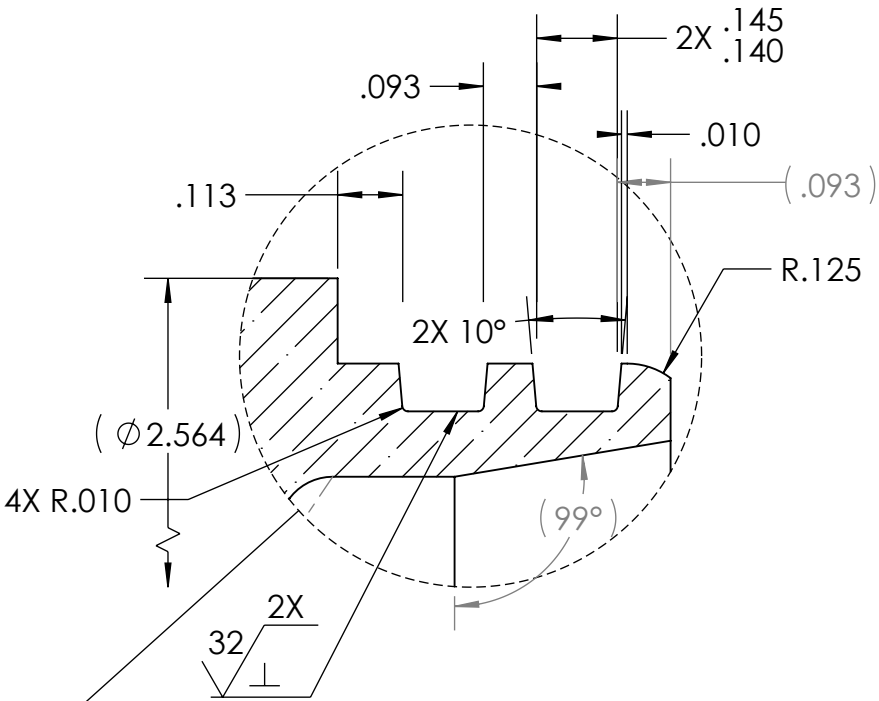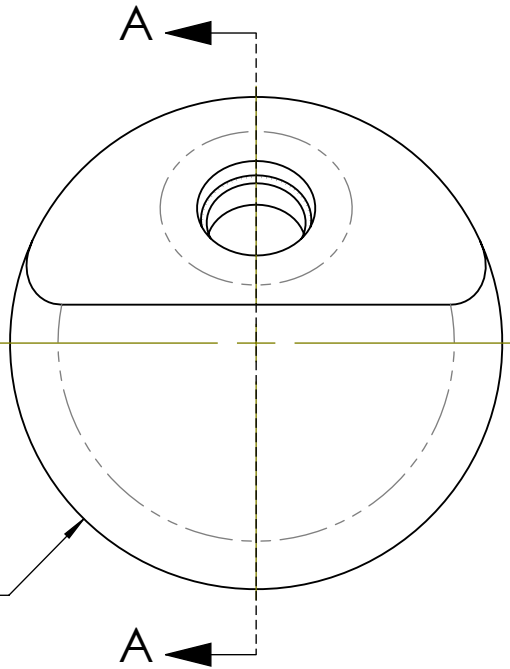

DETAIL C
SCALE 3 : 1

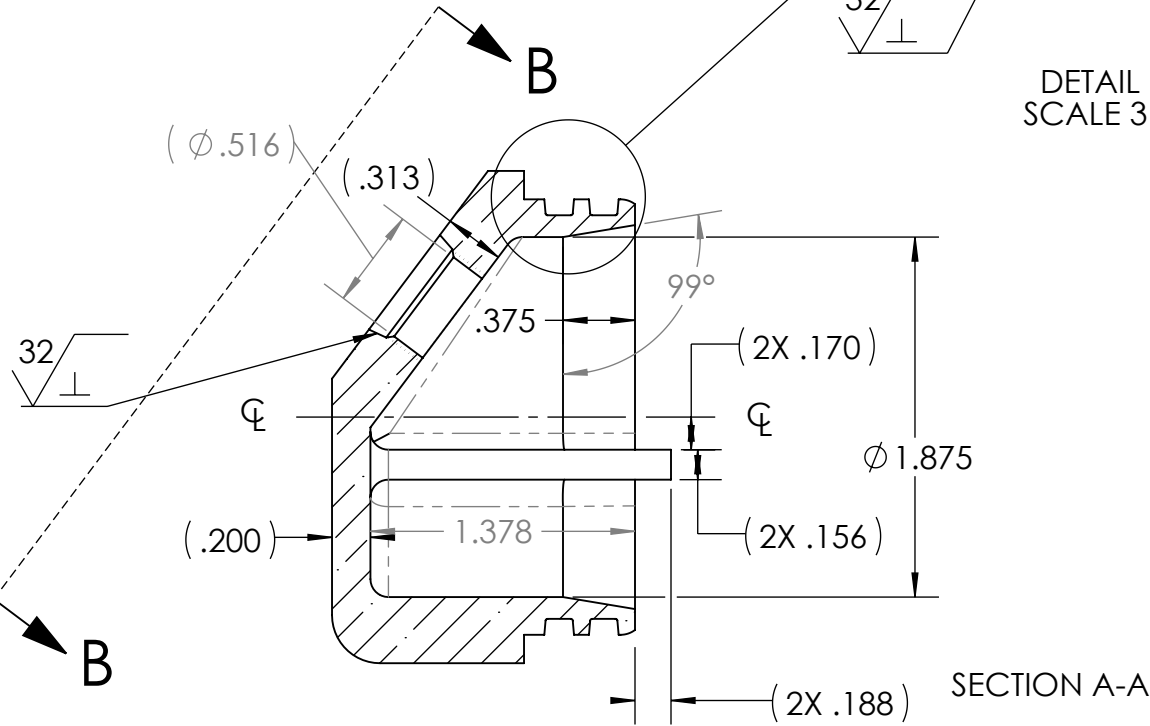

SECTION A-A

NOTES: (CONT. FROM TITLE BLOCK)

BILL OF MATERIALS									
Shop / Q.C.		UNLESS OTHERWISE SPECIFIED TOLERANCES ARE:				APPROVALS		DATE	
Inspector		1 PLACE DIM ±1/16	2 PLACE DIM ±.02	3 PLACE DIM ±.005	ANGLES ±1°	DRAWN	J. ERICKSON	7/24/20	Monterey Bay Aquarium Research Institute MBARI 7700 Sandholdt RD. Moss Landing, CA 95039 PH: (831) 775-1700 
Shop Foreman		1. DIMENSIONS ARE IN INCHES 2. DIMENSION LIMITS HELD AFTER PLATING. 3. REMOVE BURRS AND SHARP EDGES .015 MAX. 4. MACHINED FILLET RADII .0150-.030. 5. MACHINED DIAMETERS ON A COMMON CENTERLINE CONCENTRIC WITHIN .005 6. PERPENDICULARITY & PARALLELISM OF MACHINED SURFACES .002 PER INCH, MAX .012 INCHES FOR SINGLE SURFACE.				ENGINEER	J. ERICKSON	7/24/20	
Engineer						CHECKED			
NEXT ASSY Description	NEXT ASSY Number					PROJECT NO.	901217		
						PROJECT	CHEM S		
Application		DO NOT SCALE DRAWING				WEIGHT	0.548 lb.		ISUS - APEX 2000m ISUS-APEX Glider Sensor End Cap SIZE B DWG. NO. P-221979-23.DWG REV.
		SCALE 1:1		CAD FILE: MECH ENG ON TORNADO		SHEET 2 OF 2			