



These were backwards; Pin 8 is power

P2 Pin	Function	Color	Gauge
1	CD (in)	Red	20
2	Tx (Data out)	Orange	20
3	Rx (Data in)	White	20
4	CTS (in)	Black	20
5	Sig Gnd	Violet	16
6	DTR (out)		20
7	PWR GND	Yellow	16
8	PWR	Blue	16

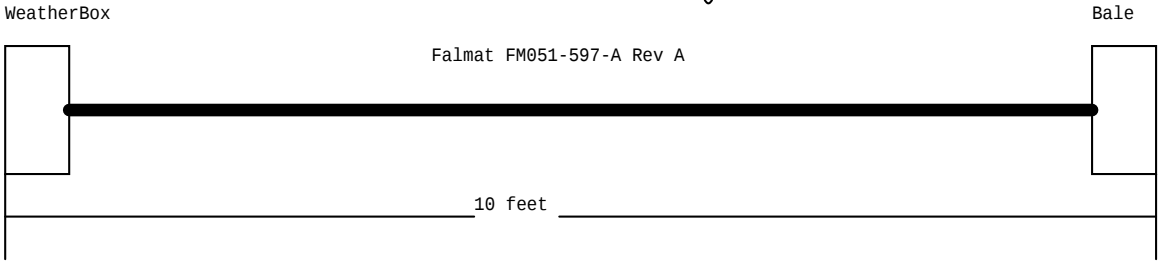

Due to wire color change drawing has been updated
From 0.0.1 to 0.0.2

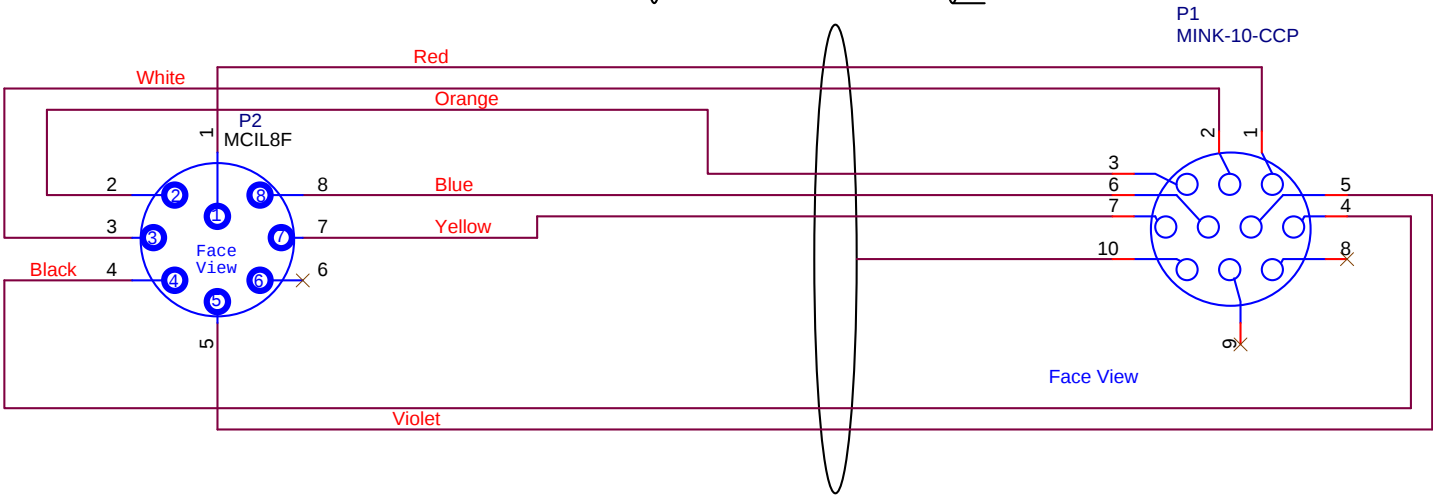