



These were backwards; Pin 8 is power

P1 Pin	Function	Color	Gauge
1	CD (in)	Blue	20
2	Tx (Data out)	White	20
3	Rx (Data in)	Brown	20
4	CTS (in)	Gray	20
5	Sig Gnd	Green	16
6	DTR (out)	Green	20
7	PWR GND	Red	16
8	PWR	Black	16

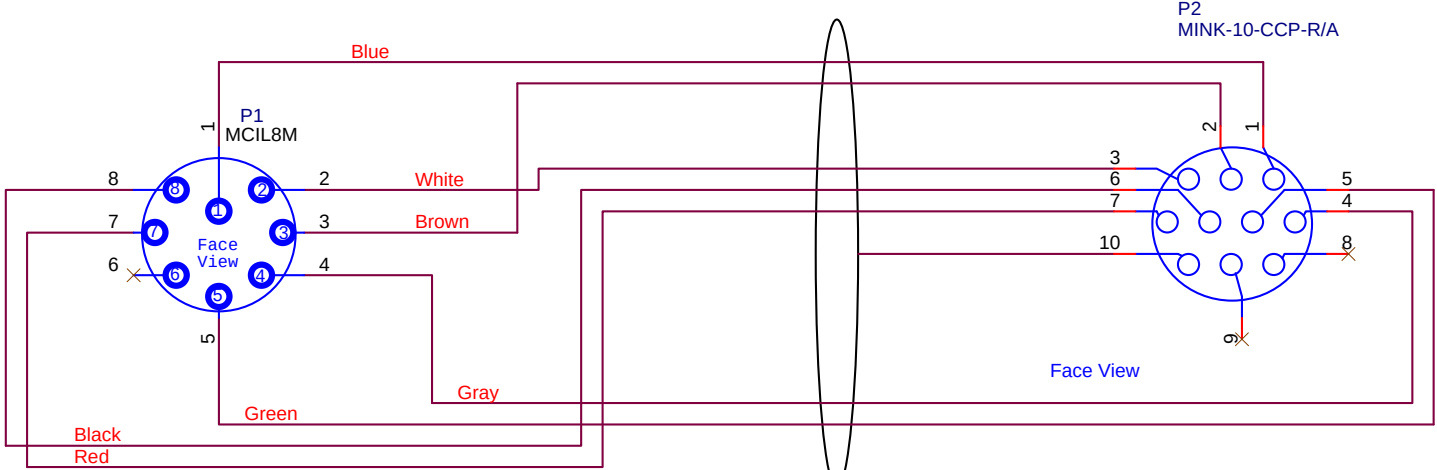

Falmat FM051-597-A Rev A

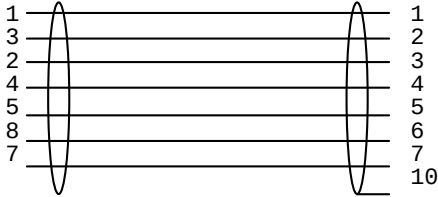