


Description	Pin	Direction
DCD	1	In
RX	2	In
TX	3	Out
DTR	4	Out
GND	5	Gnd
DSR	6	In
RTS	7	Out
CTS	8	In
RI	9	In

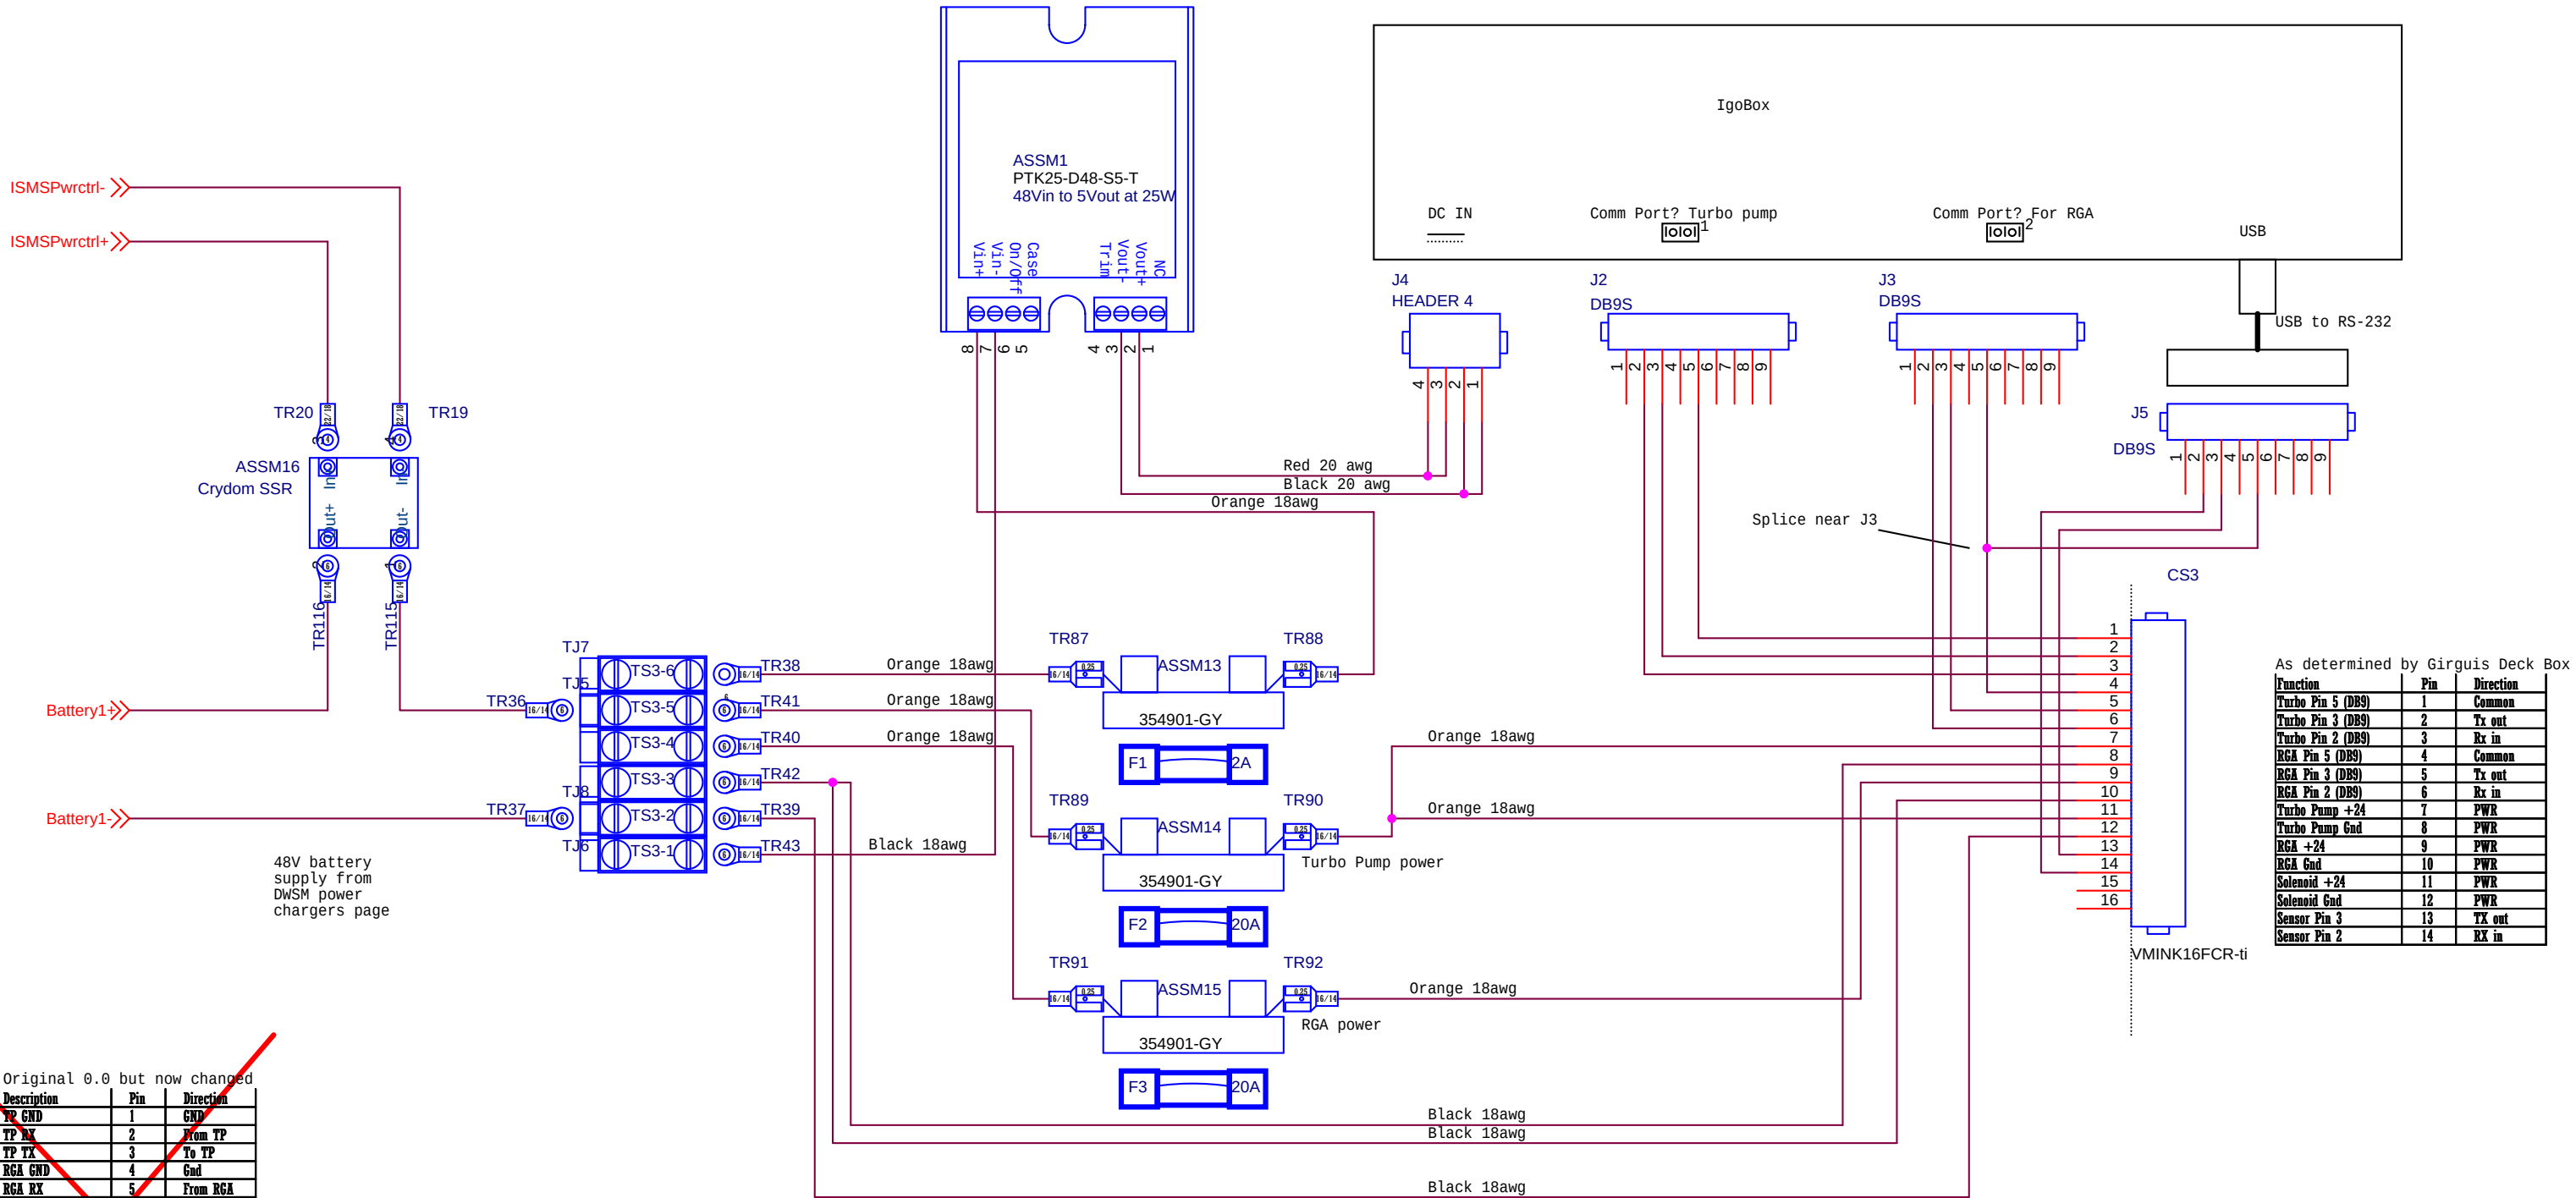

As determined by Girguis Deck Box

Function	Pin	Direction
Turbo Pin 5 (DB9)	1	Common
Turbo Pin 3 (DB9)	2	Tx out
Turbo Pin 2 (DB9)	3	Rx in
RGA Pin 5 (DB9)	4	Common
RGA Pin 3 (DB9)	5	Tx out
RGA Pin 2 (DB9)	6	Rx in
Turbo Pump +24	7	PWR
Turbo Pump Gnd	8	PWR
RGA +24	9	PWR
RGA Gnd	10	PWR
Solenoid +24	11	PWR
Solenoid Gnd	12	PWR
Sensor Pin 3	13	TX out
Sensor Pin 2	14	RX in

Original 0.0 but now changed

Description	Pin	Direction
TP GND	1	GND
TP RX	2	From TP
TP TX	3	To TP
RGA GND	4	Gnd
RGA RX	5	From RGA
RGA TX	6	To RGA
RGA DTR	7	To RGA
RGA DSR	8	From RGA
RGA RTS	9	To RGA
RGA CTS	10	From RGA
TP 24V	11	To TP
TP 24V com	12	To TP
TP 24V com	13	Gnd
TP 24V com	14	Gnd
RGA 24V	15	To RGA
RGA 24V com	16	GND



Monterey Bay Aquarium Research Institute
7700 Sandhold Road, Moss Landing, CA 95039

Engineer SJensen		Size B	Document Number <Doc>	Part Number <Part Number>	Project File dwsml4km.opj	Project ESP
Designer <Designer>		Date:	Thursday, November 08, 2012	Sheet	1 of 2	Rev 2.0.1