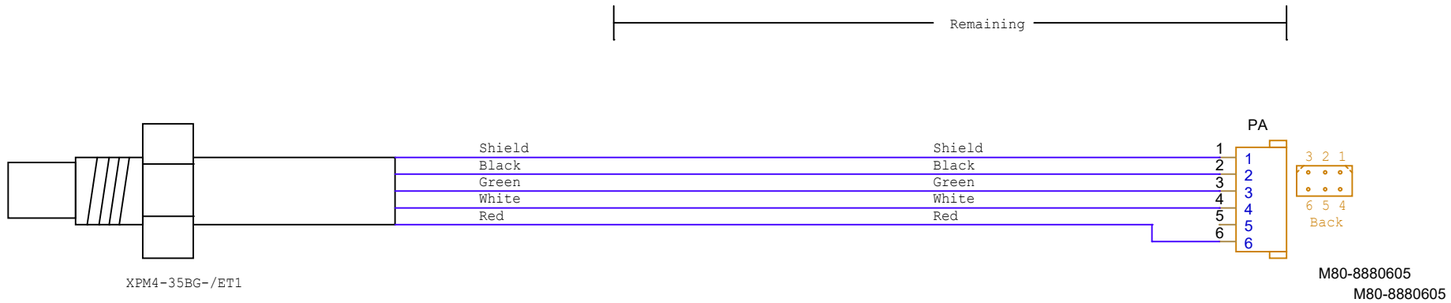


Revision 0.1.0: All instruments use Pressure SensorAmp rev3. this version makes 3.0V for excitation available on pin 6. Move Red wire from 5 to 6.

MONTEREY BAY AQUARIUM RESEARCH INSTITUTE
7700 SANDHOLDT ROAD
MOSS LANDING, CA 95039
(831) 775-1700 www.mbari.org
Copyright MBARI 2000

Title: ESP 3G Ambient Pressure Sensor Wiring Harness				Number: <Doc>	
Size: B	Engineer: SJensen	Path: <Path>	Filename: 3gwireharness.odt		Rev: 0.1.0
	Date: Monday, November 09, 2026		Sheet 1 of 1		