



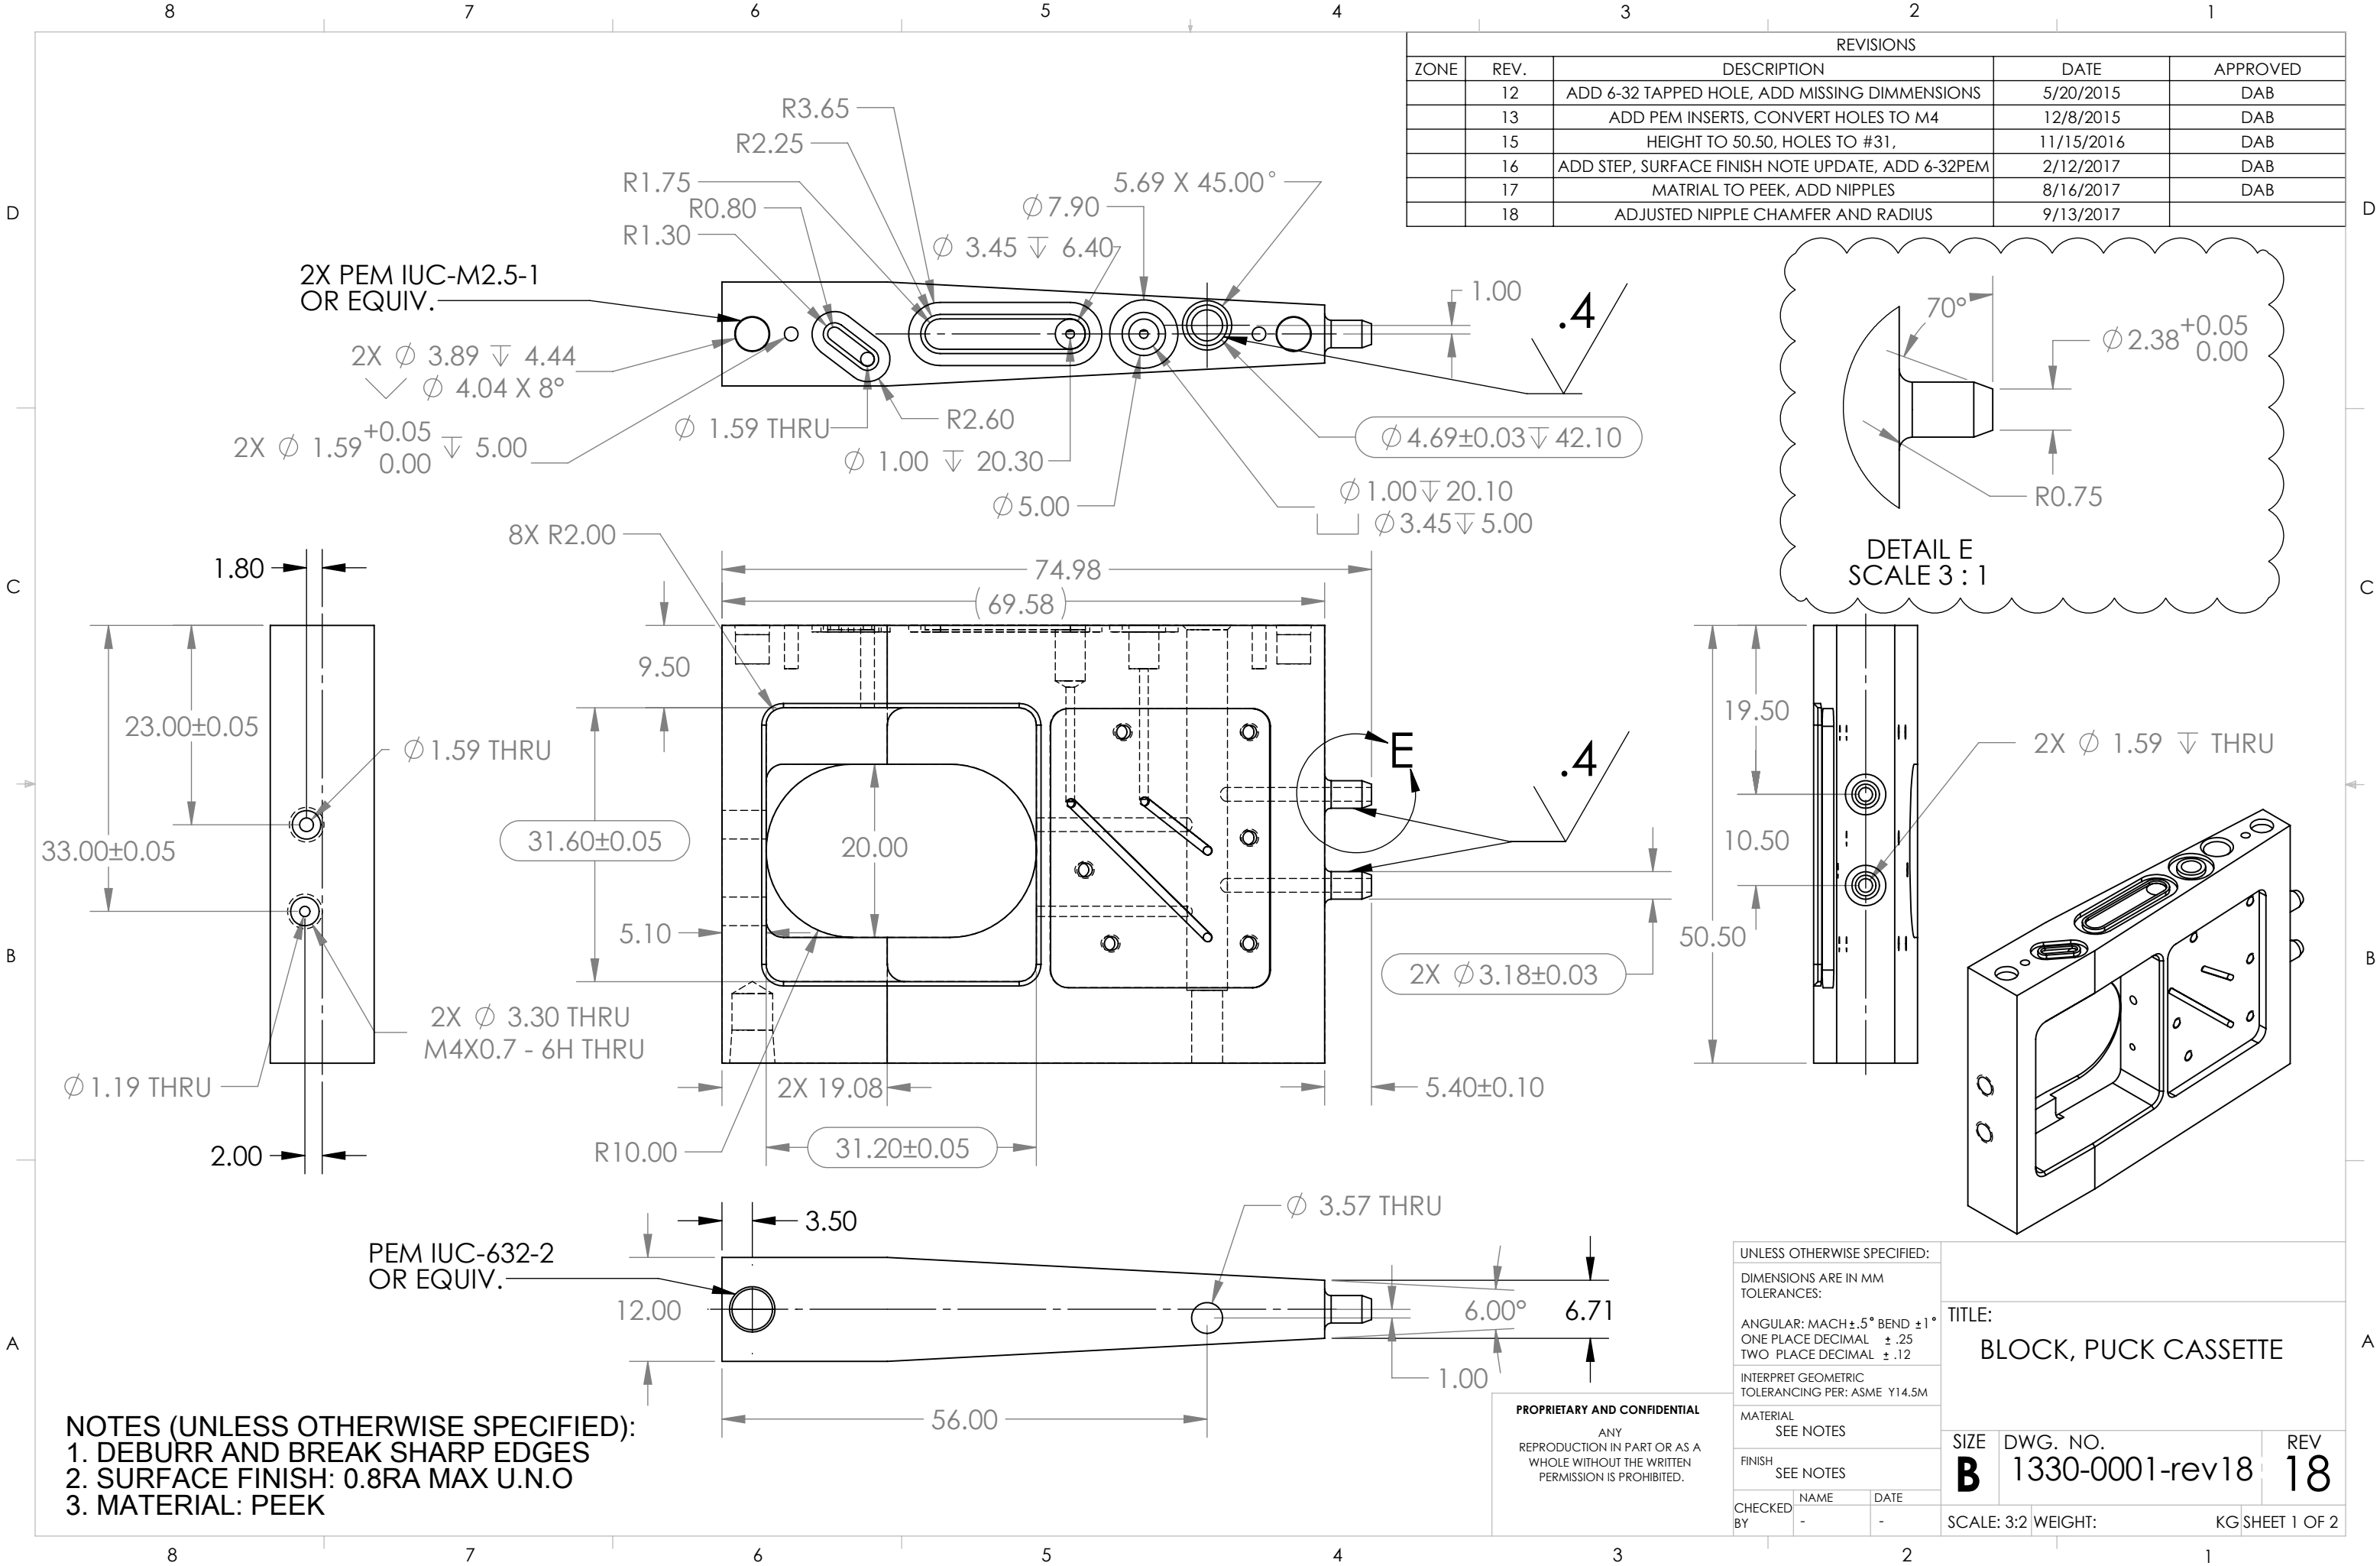

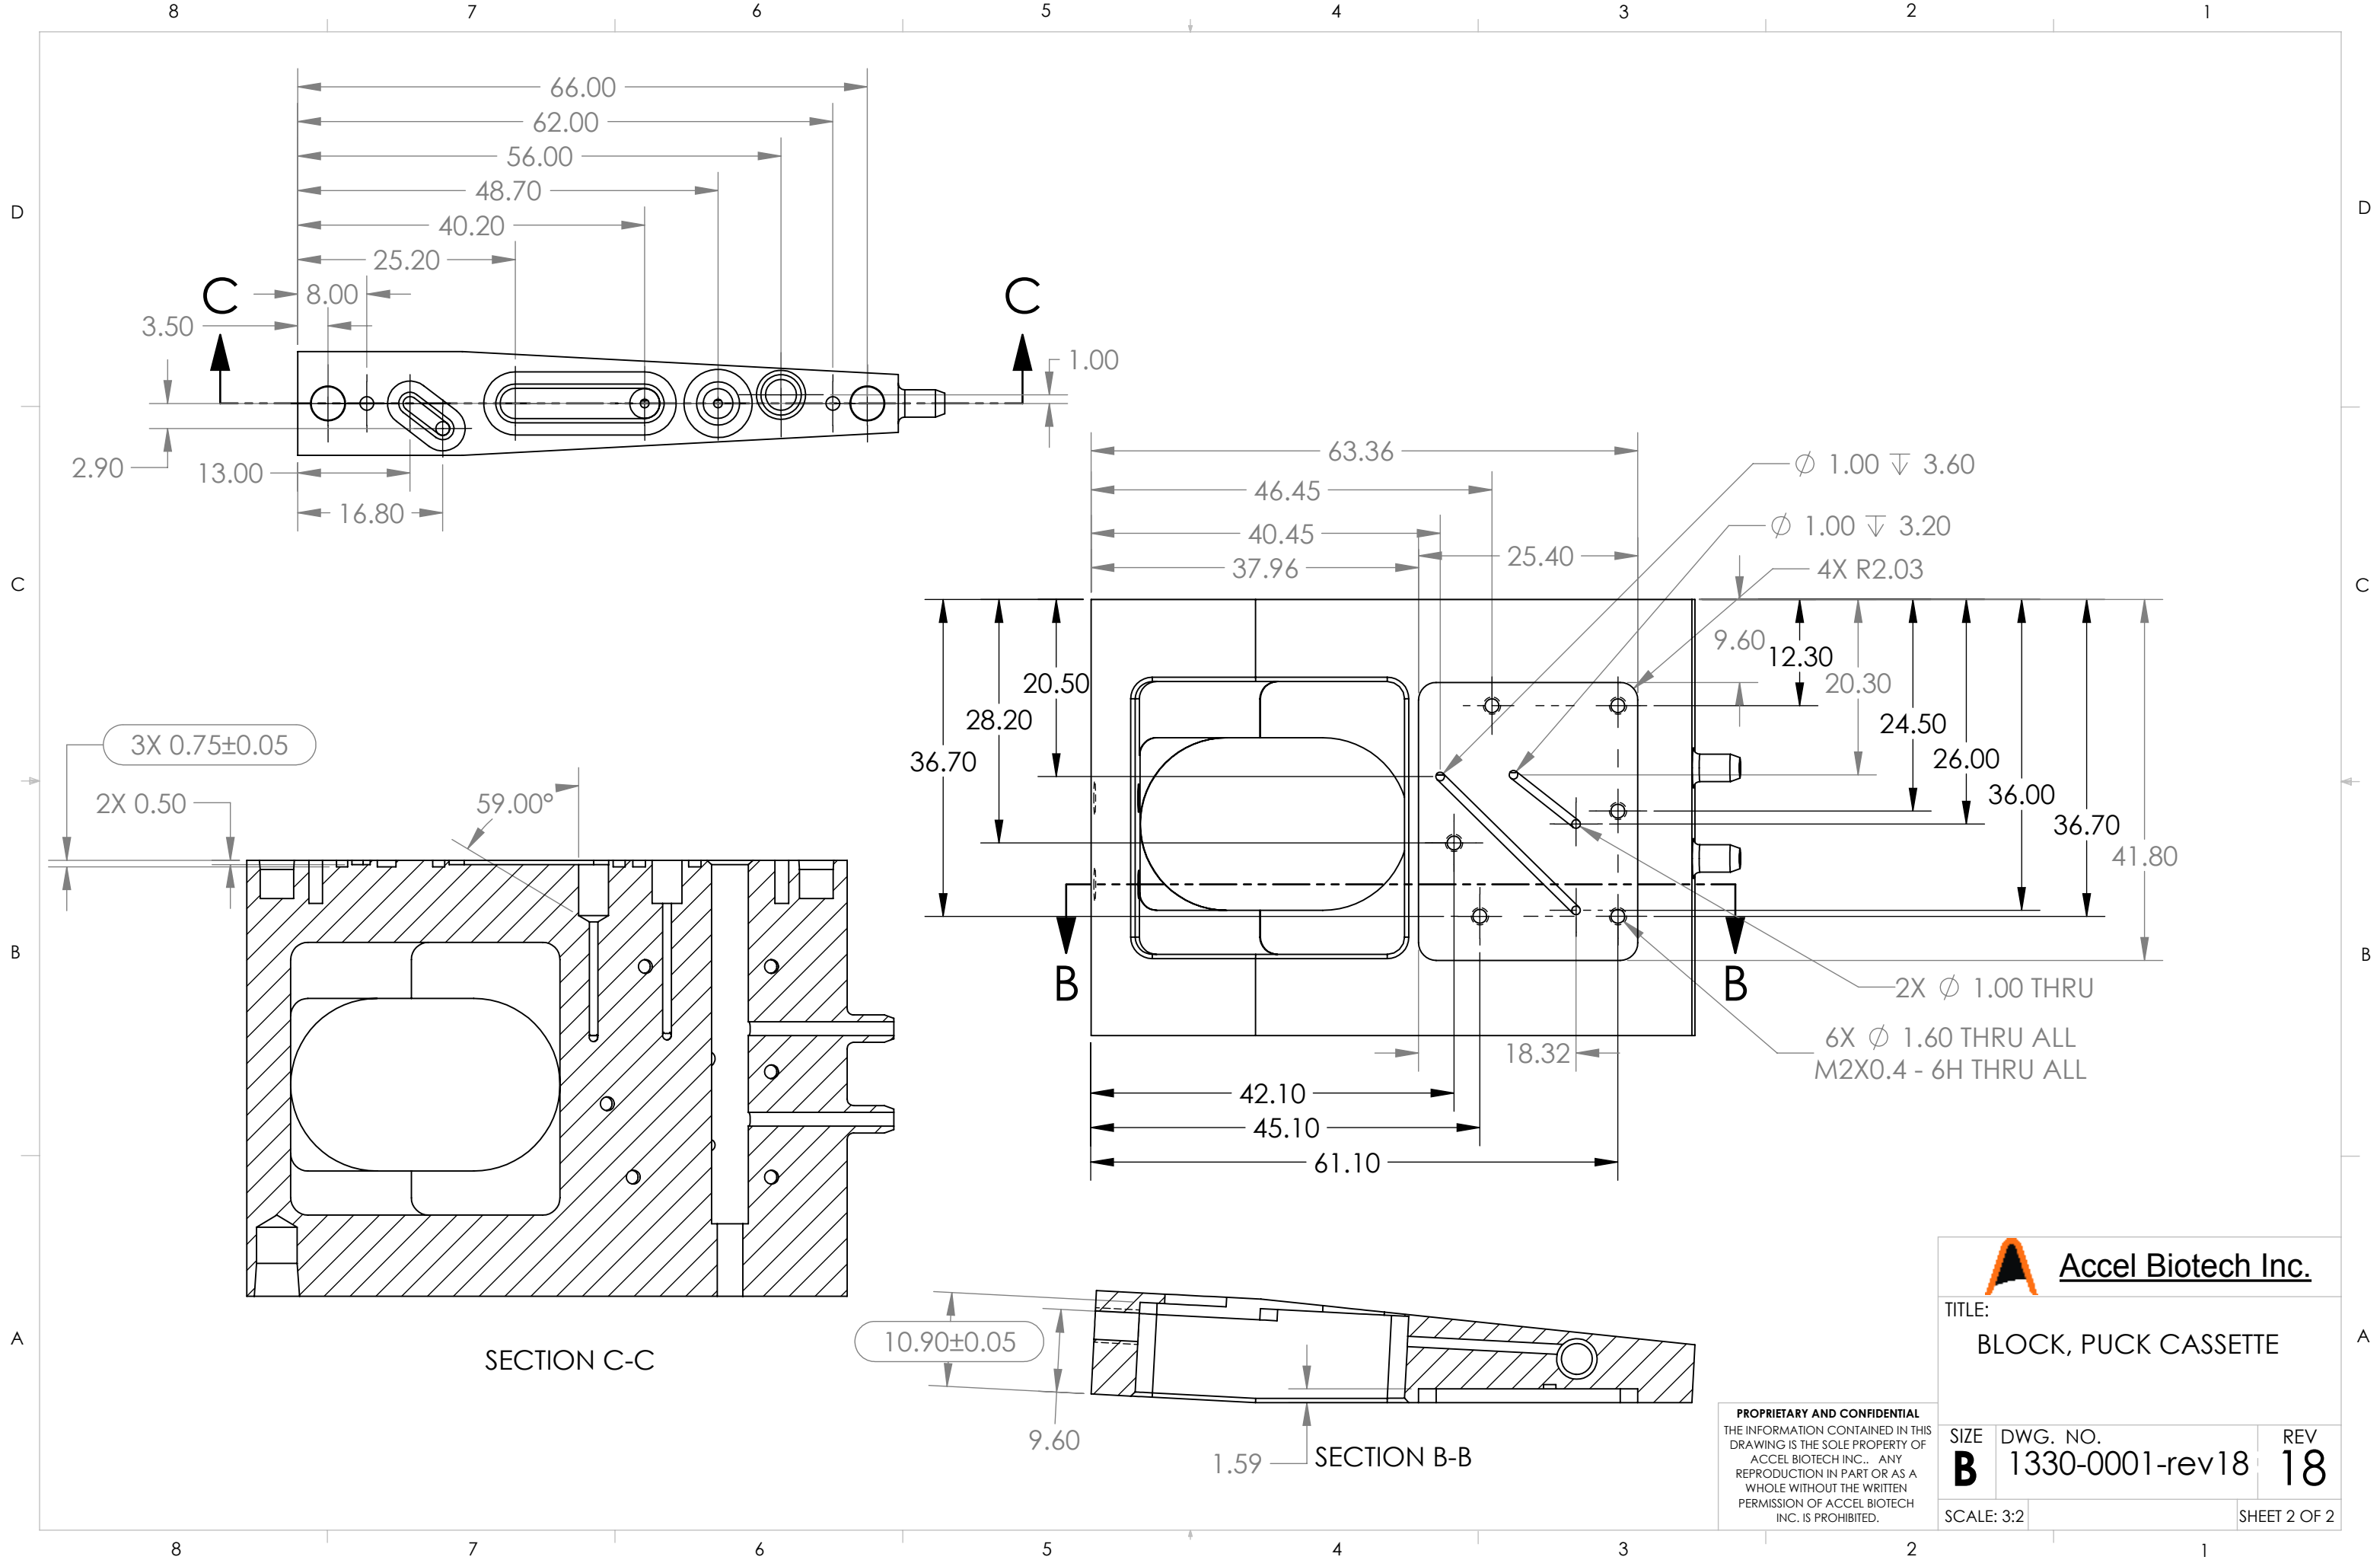

Accel Biotech Inc.

TITLE:
BLOCK, PUCK CASSETTE

PROPRIETARY AND CONFIDENTIAL
THE INFORMATION CONTAINED IN THIS
DRAWING IS THE SOLE PROPERTY OF
ACCEL BIOTECH INC.. ANY
REPRODUCTION IN PART OR AS A
WHOLE WITHOUT THE WRITTEN
PERMISSION OF ACCEL BIOTECH
INC. IS PROHIBITED.

SIZE B	DWG. NO. 1330-0001-rev18	REV 18
SCALE: 3:2		SHEET 2 OF 2