
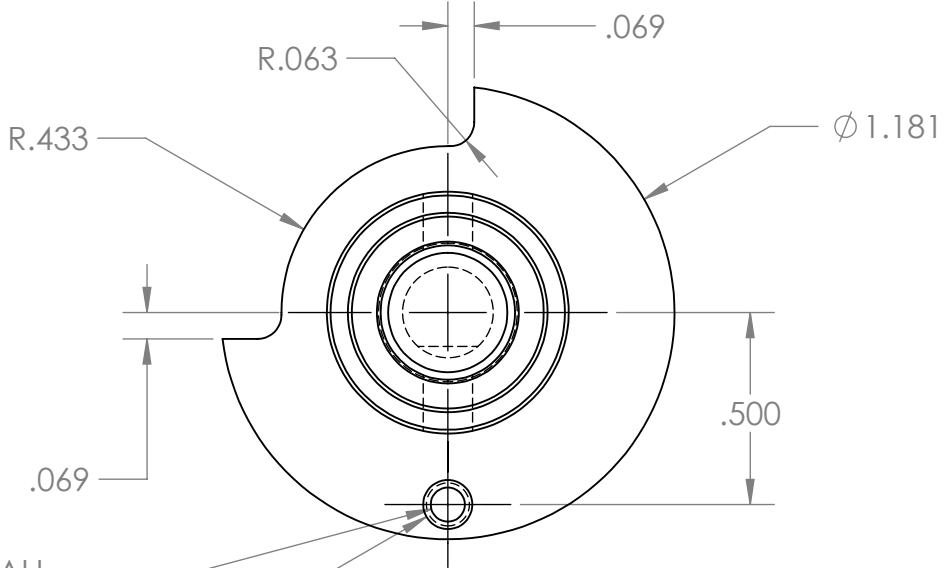


THE INFORMATION CONTAINED IN THIS DRAWING IS THE SOLE PROPERTY OF MBARI ANY REPRODUCTION IN PART OR WHOLE WITHOUT THE WRITTEN PERMISSION OF MBARI IS PROHIBITED.



REVISIONS			
REV.	DESCRIPTION	DATE	APPROVED
	INITIAL RELEASE		

A REDUCED THICKNESS

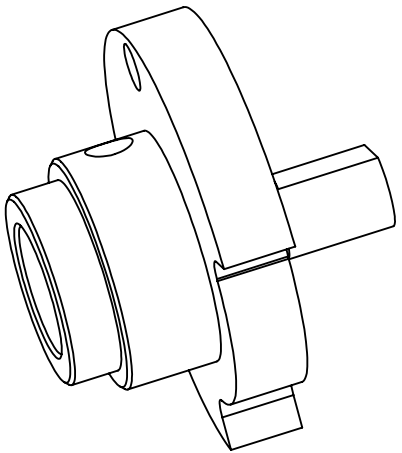


Ø .089 THRU ALL
4-40 UNC THRU ALL

Ø .129 ∇ .089
Ø .126 ∇ .079

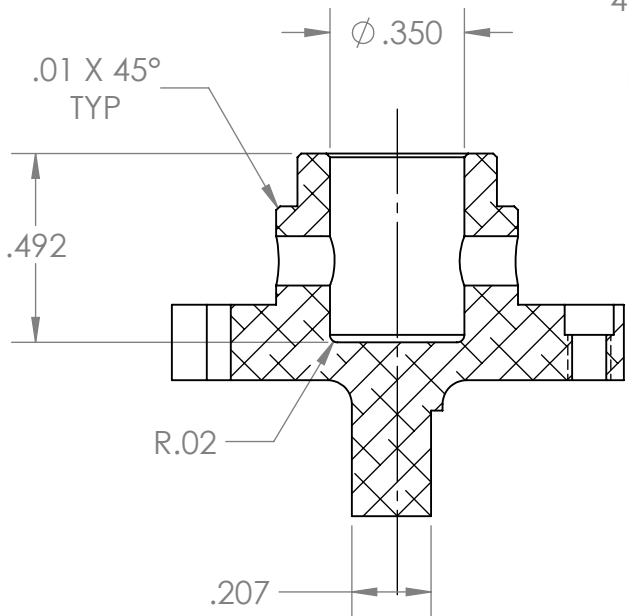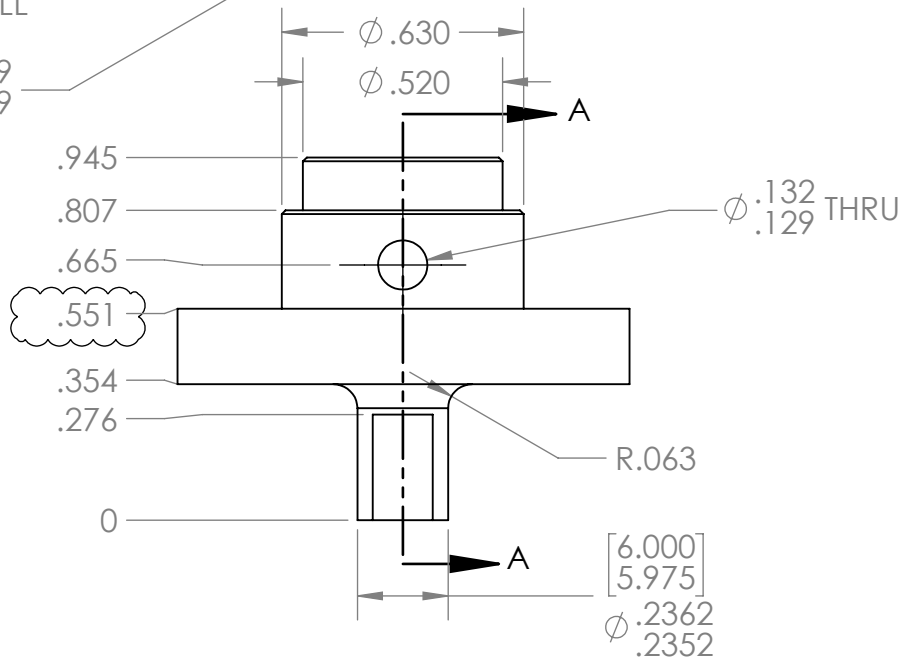

SECTION A-A

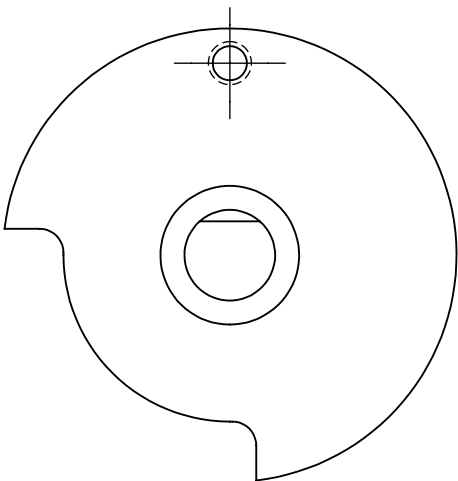

BILL OF MATERIALS

Shop / Q.C.		UNLESS OTHERWISE SPECIFIED TOLERANCES ARE:				APPROVALS		DATE	Monterey Bay Aquarium Research Institute			
Inspector		1 PLACE DIM $\pm 1/16$	2 PLACE DIM $\pm .02$	3 PLACE DIM $\pm .005$	ANGLES $\pm 1^\circ$	DRAWN	NAME	9/27/00	MBARI 7700 Sandholdt RD. Moss Landing, CA 95039 PH: (831) 775-1700			
Shop Foreman		1. DIMENSIONS ARE IN INCHES 2. DIMENSION LIMITS HELD AFTER PLATING. 3. REMOVE BURRS AND SHARP EDGES .015 MAX. 4. MACHINED FILLET RADII .0150-.030. 5. MACHINED DIAMETERS ON A COMMON CENTERLINE CONCENTRIC WITHIN .005 6. PERPENDICULARITY & PARALLELISM OF MACHINED SURFACES .002 PER INCH, MAX .012 INCHES FOR SINGLE SURFACE.				ENGINEER	NAME	9/27/00				
Engineer						CHECKED						
NEXT ASSY Description	NEXT ASSY Number					PROJECT NO.	XXX		MBARI-300-10669_D			
						PROJECT	ZZZZZZZZ					
Application		DO NOT SCALE DRAWING				WEIGHT			SIZE B	DWG. NO.	100XXXDWG	REV. A
									SCALE 2:1	CAD FILE: MECH ENG ON TORNADO	SHEET 1 OF 1	