
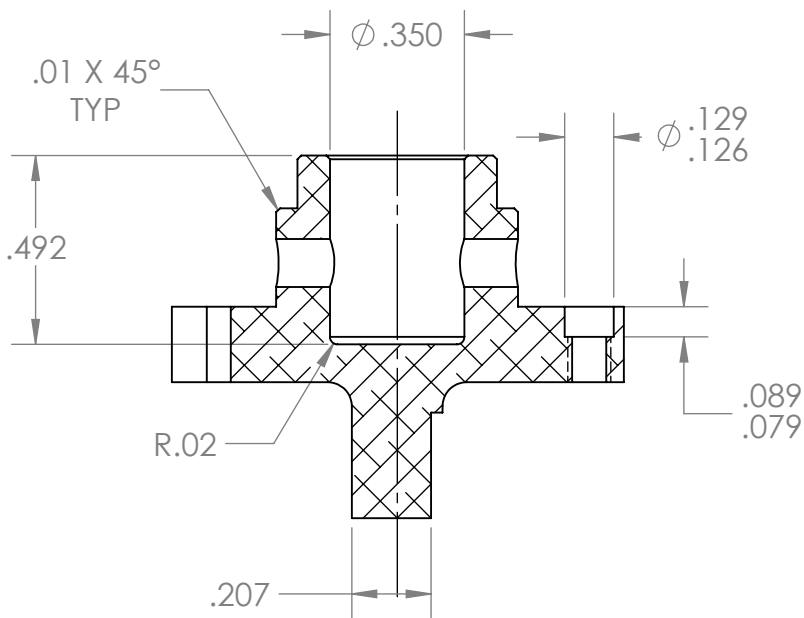
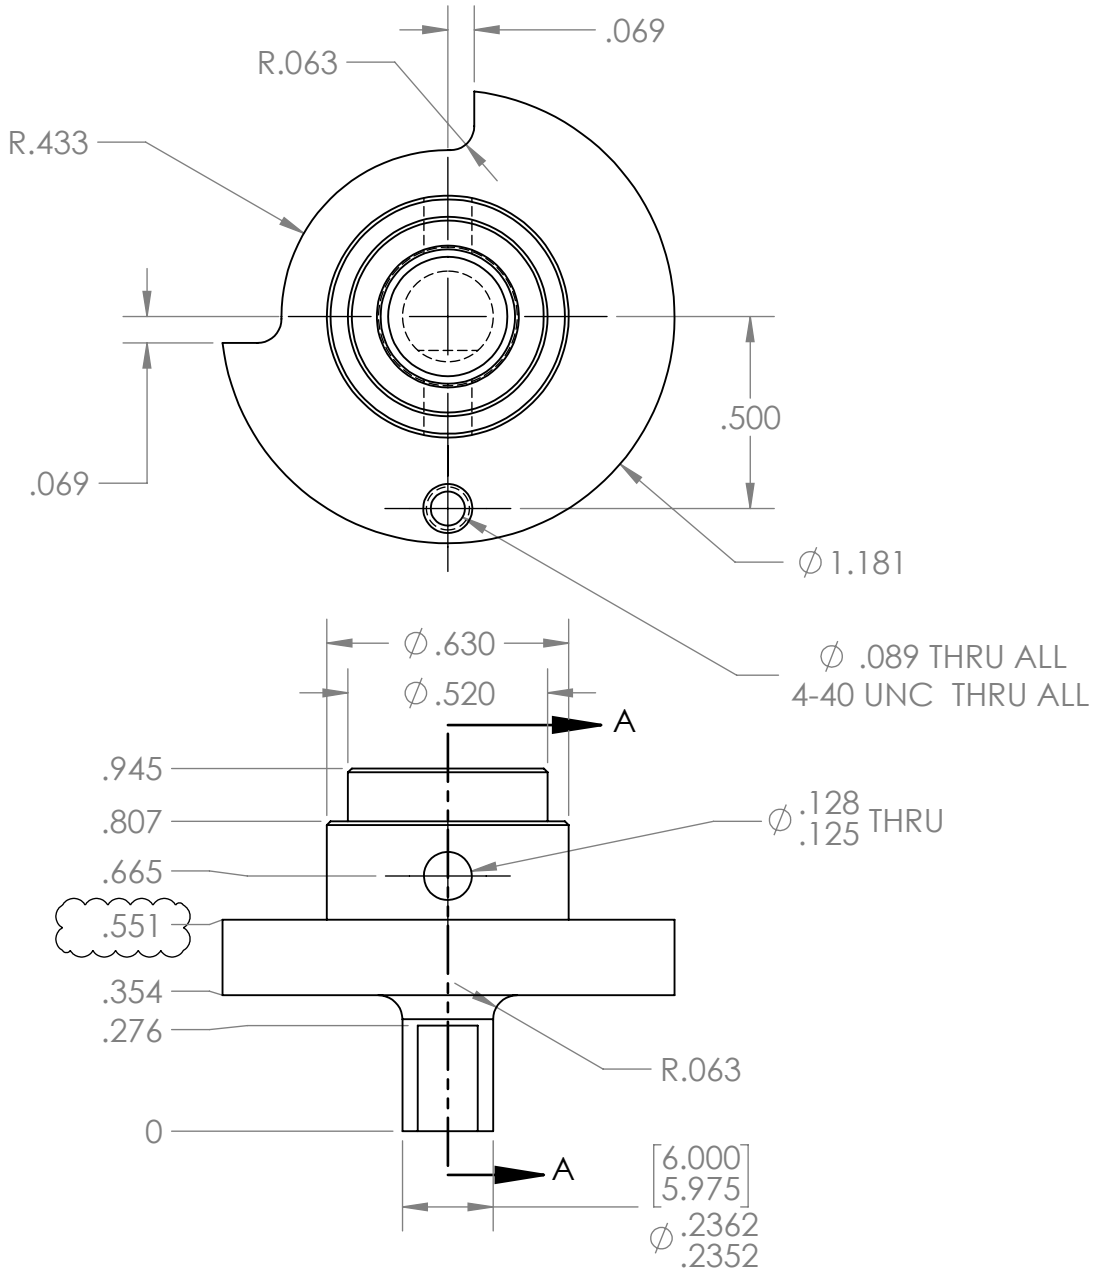



THE INFORMATION CONTAINED IN THIS DRAWING IS THE SOLE PROPERTY OF MBARI ANY REPRODUCTION IN PART OR WHOLE WITHOUT THE WRITTEN PERMISSION OF MBARI IS PROHIBITED.

REVISIONS			
REV.	DESCRIPTION	DATE	APPROVED
	INITIAL RELEASE		

A REDUCED THICKNESS

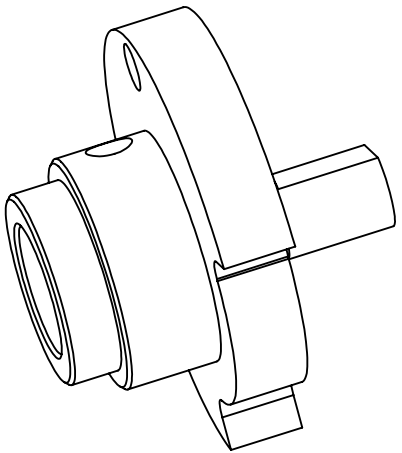

SECTION A-A

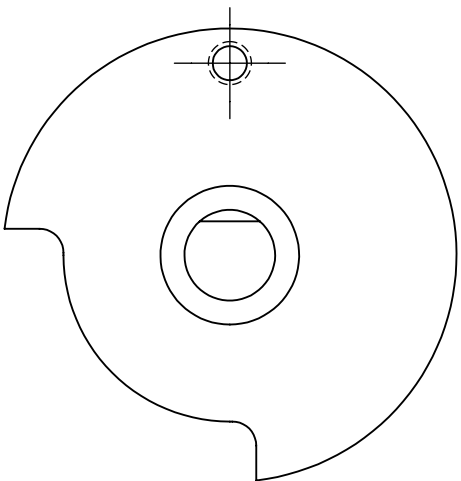

BILL OF MATERIALS

Shop / Q.C.		UNLESS OTHERWISE SPECIFIED TOLERANCES ARE:				APPROVALS	DATE	Monterey Bay Aquarium Research Institute		
Inspector		1 PLACE DIM ±1/16	2 PLACE DIM ±.02	3 PLACE DIM ±.005	ANGLES ±1°	DRAWN	NAME	9/27/00	MBARI 7700 Sandholdt RD. Moss Landing, CA 95039 PH: (831) 775-1700	
Shop Foreman		1. DIMENSIONS ARE IN INCHES 2. DIMENSION LIMITS HELD AFTER PLATING. 3. REMOVE BURRS AND SHARP EDGES .015 MAX. 4. MACHINED FILLET RADII .0150-.030. 5. MACHINED DIAMETERS ON A COMMON CENTERLINE CONCENTRIC WITHIN .005 6. PERPENDICULARITY & PARALLELISM OF MACHINED SURFACES .002 PER INCH, MAX .012 INCHES FOR SINGLE SURFACE.				ENGINEER	NAME	9/27/00		
Engineer						CHECKED				
NEXT ASSY Description	NEXT ASSY Number					PROJECT NO.	XXX		MBARI-300-10669_D	
						PROJECT	ZZZZZZZZ			
Application		DO NOT SCALE DRAWING				WEIGHT			SIZE B	DWG. NO. 100XXXDWG
									SCALE 2:1	CAD FILE: MECH ENG ON TORNADO
									SHEET 1	OF 1