
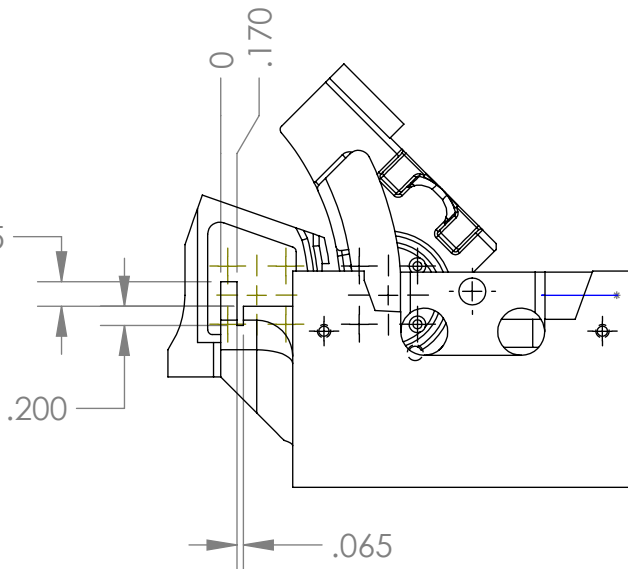
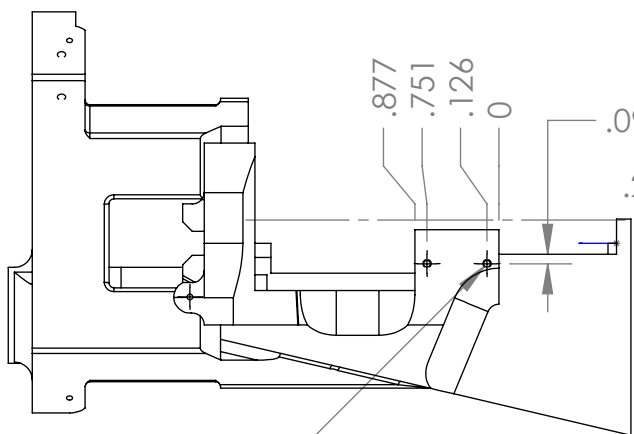
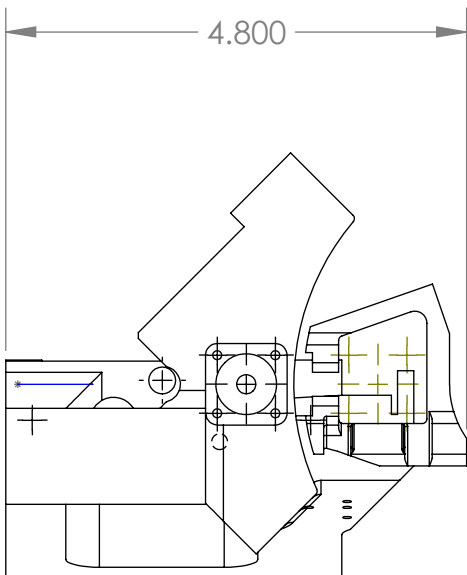
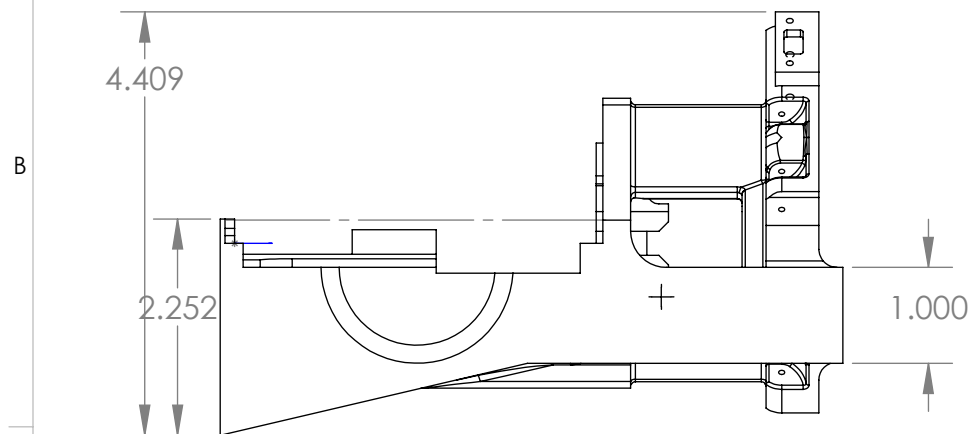
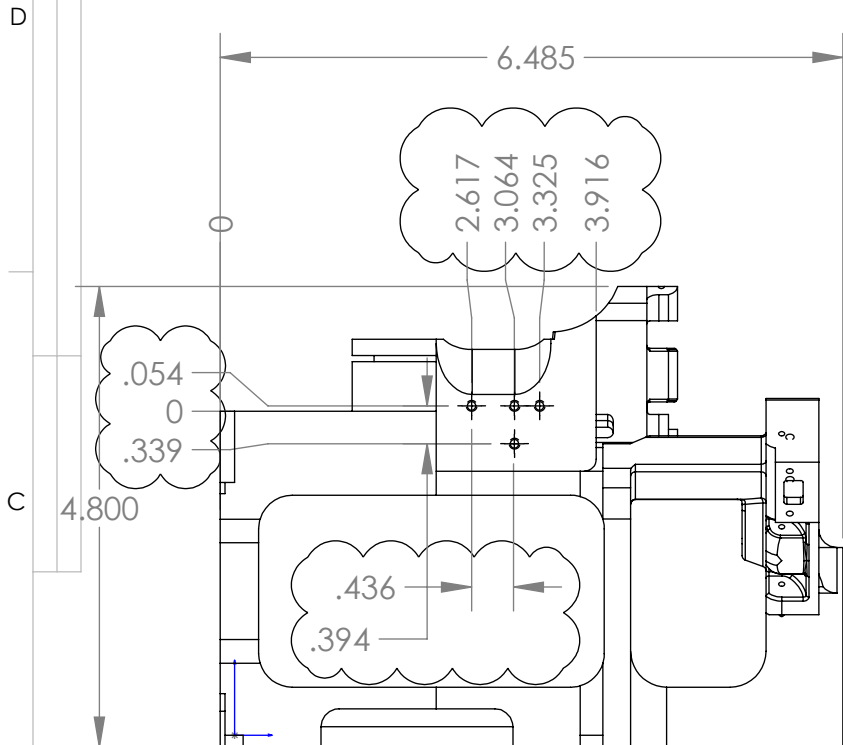


THE INFORMATION CONTAINED IN THIS DRAWING IS THE SOLE PROPERTY OF MBARI ANY REPRODUCTION IN PART OR WHOLE WITHOUT THE WRITTEN PERMISSION OF MBARI IS PROHIBITED.

REVISIONS			
REV.	DESCRIPTION	DATE	APPROVED
	INITIAL RELEASE		

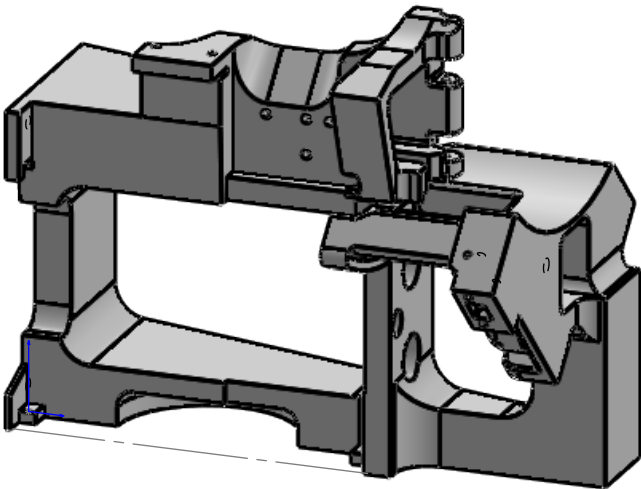

2X $\varnothing$.070 ∇ .625
2-56 UNC ∇ .172

BILL OF MATERIALS																			
NEXT ASSY Description		NEXT ASSY Number	UNLESS OTHERWISE SPECIFIED TOLERANCES ARE:				APPROVALS		DATE										
			1 PLACE DIM ±1/16	2 PLACE DIM ±.02	3 PLACE DIM ±.005	ANGLES ±1°	DRAWN		9/9/2014										
THIRD ANGLE PROJECTION			1. DIMENSIONS ARE IN INCHES 2. DIMENSION LIMITS HELD AFTER PLATING. 3. REMOVE BURRS AND SHARP EDGES .015 MAX. 4. MACHINED FILLET RADII .0150-.030. 5. MACHINED DIAMETERS ON A COMMON CENTERLINE CONCENTRIC WITHIN .005 6. PERPENDICULARITY & PARALLELISM OF MACHINED SURFACES .002 PER INCH, MAX .012 INCHES FOR SINGLE SURFACE.				ENGINEER		pargett										
							CHECKED												
							PROJECT NO.		901205										
							PROJECT												
							WEIGHT												
			DO NOT SCALE DRAWING																
Monterey Bay Aquarium Research Institute MBARI 7700 Sandholdt RD. Moss Landing, CA 95039 PH: (831) 775-1700  G3 ESP Bench Cartridge Holder <table><tr><td>SIZE</td><td>DWG. NO.</td><td>REV.</td></tr><tr><td>B</td><td>202052</td><td></td></tr></table><table><tr><td>SCALE</td><td>1:2</td><td>CAD FILE:</td><td>SHEET 1 OF 1</td></tr></table>										SIZE	DWG. NO.	REV.	B	202052		SCALE	1:2	CAD FILE:	SHEET 1 OF 1
SIZE	DWG. NO.	REV.																	
B	202052																		
SCALE	1:2	CAD FILE:	SHEET 1 OF 1																

Status: