


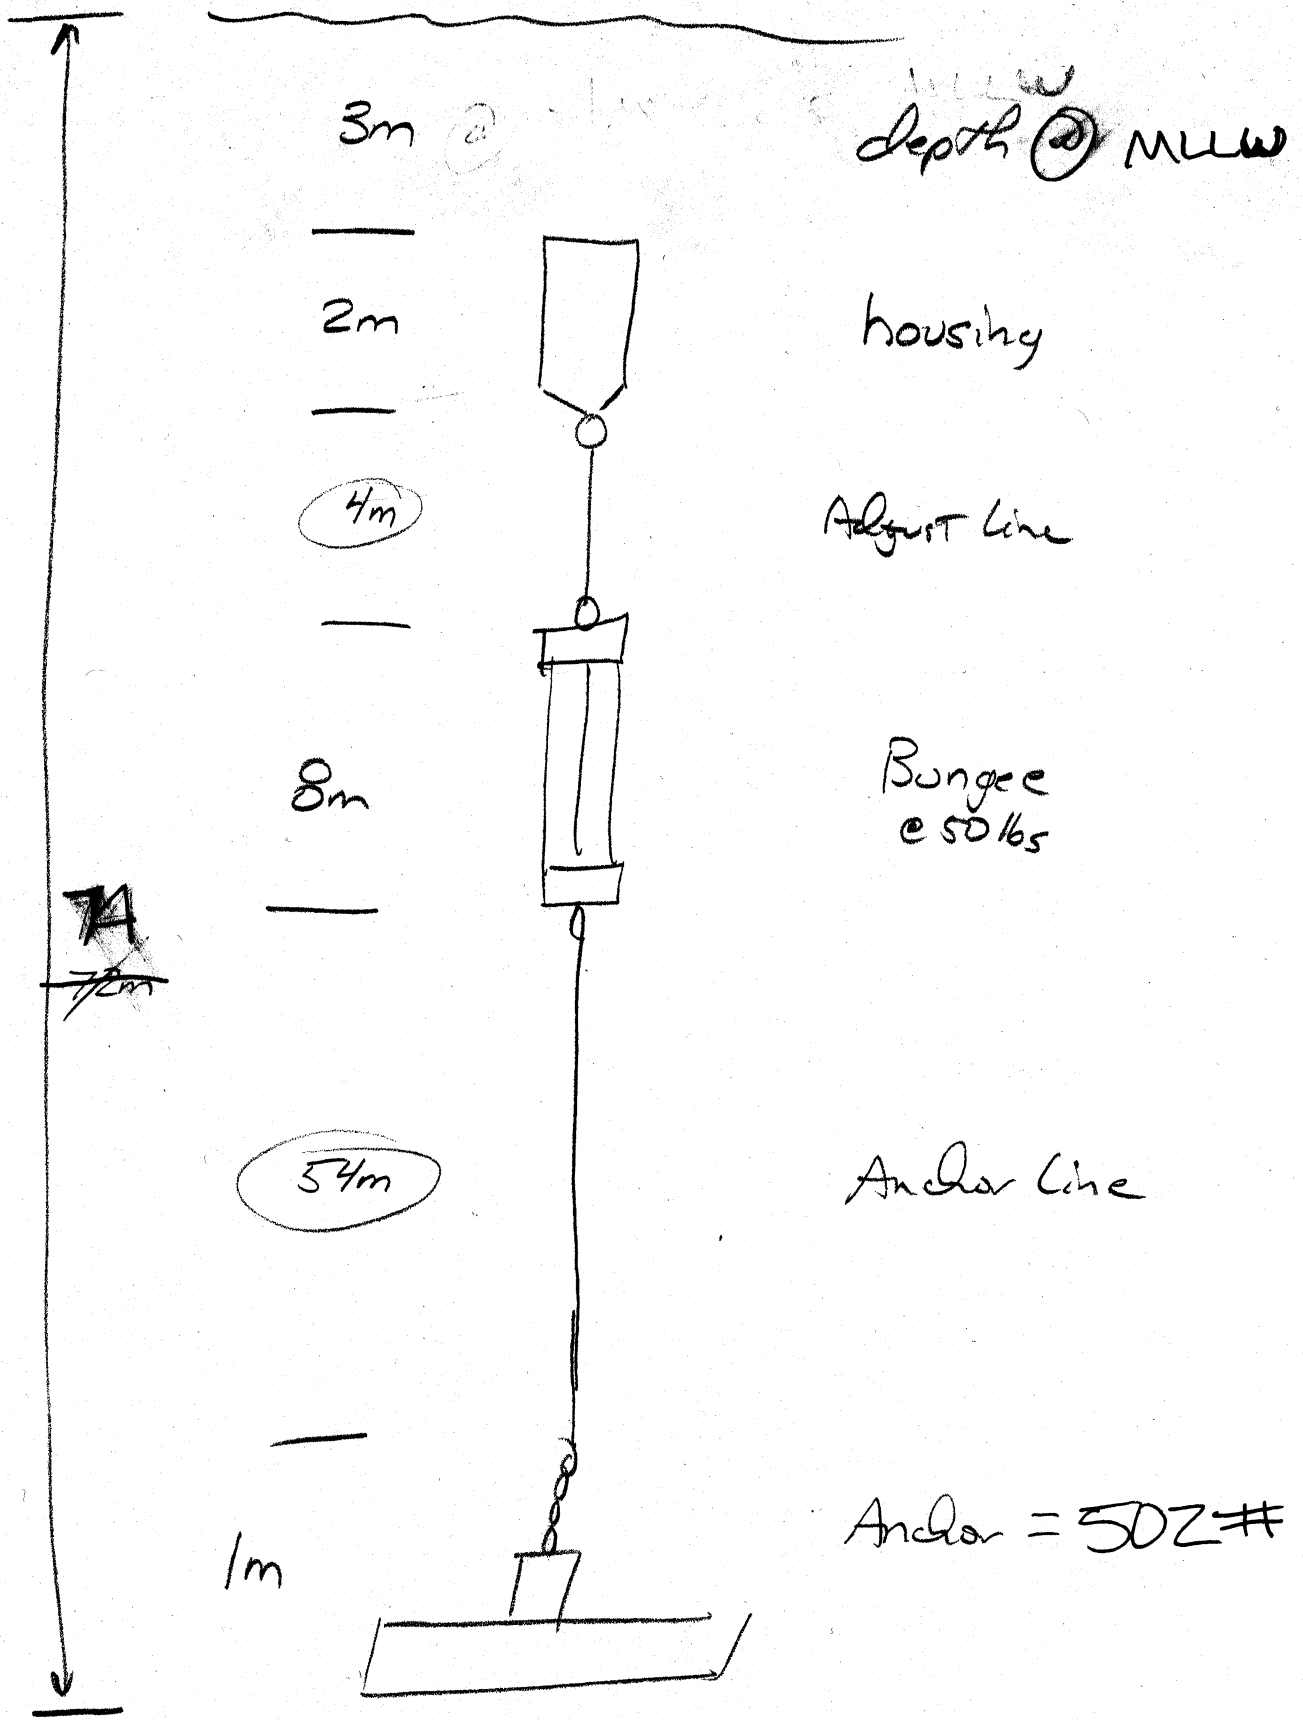

Fixed Length = 14m

8/17/04 ZEPHYR DEPLOYMENT