

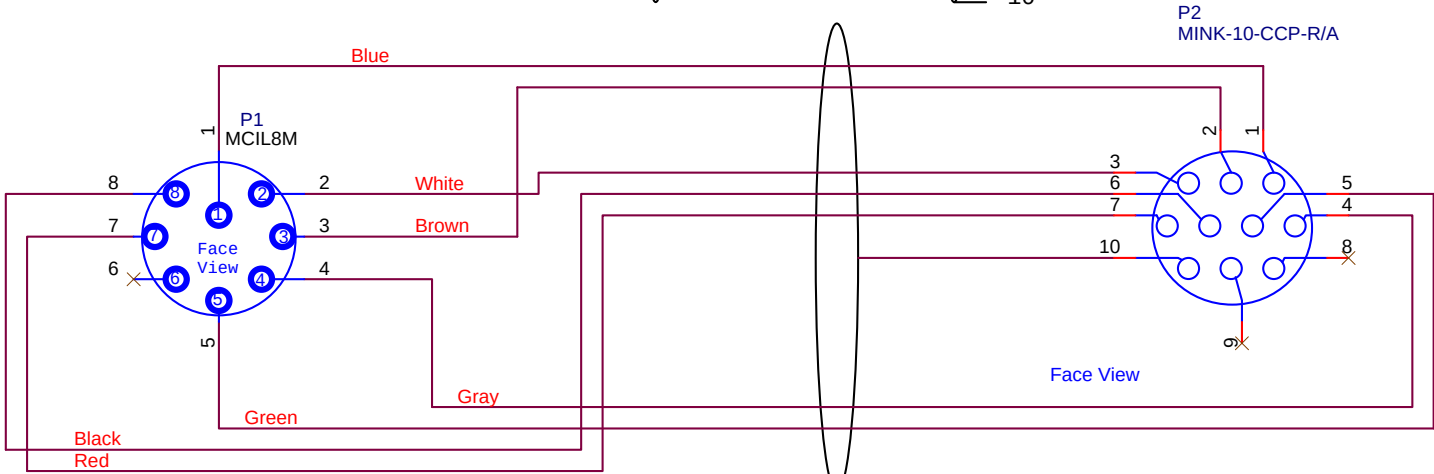
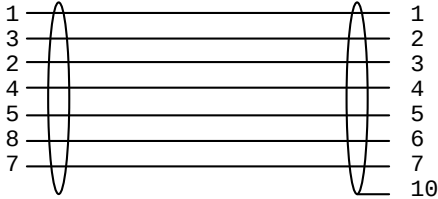
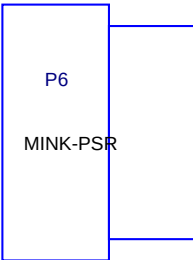
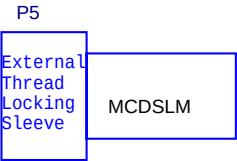


These were backwards; Pin 8 is power

P1 Pin	Function	Color	Gauge
1	CD (in)	Blue	20
2	Tx (Data out)	White	20
3	Rx (Data in)	Brown	20
4	CTS (in)	Gray	20
5	Sig Gnd	Green	16
6	DTR (out)	Green	20
7	PWR GND	Red	16
8	PWR	Black	16

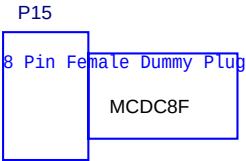


Falmat FM051-597-A Rev A

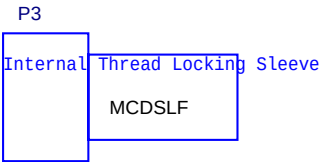

GiGi

Bale

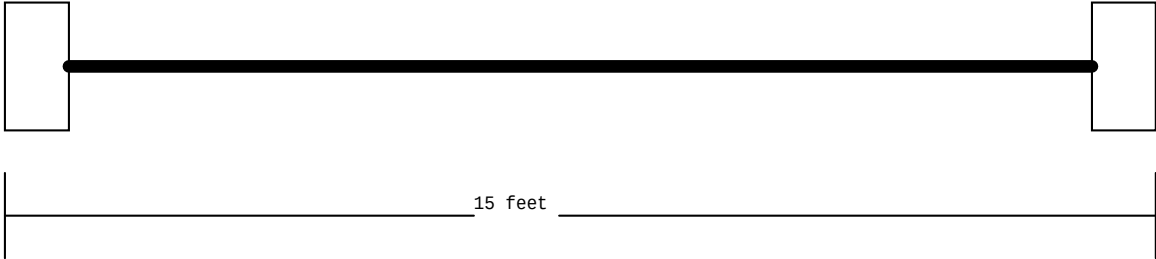

MONTEREY BAY AQUARIUM RESEARCH INSTITUTE

7700 SANDHOLDT ROAD

MOSS LANDING, CA 95039

(831) 775-1700 www.mbari.org

Copyright MBARI 2000



Title GiGi to EM Cable (CAB2)			Number _	
Size B	Engineer Scott Jensen	Layout _	Filename ESP_System	Rev 0.0.1
	Date: Wednesday, August 03, 2011	Sheet 1	of 1	