


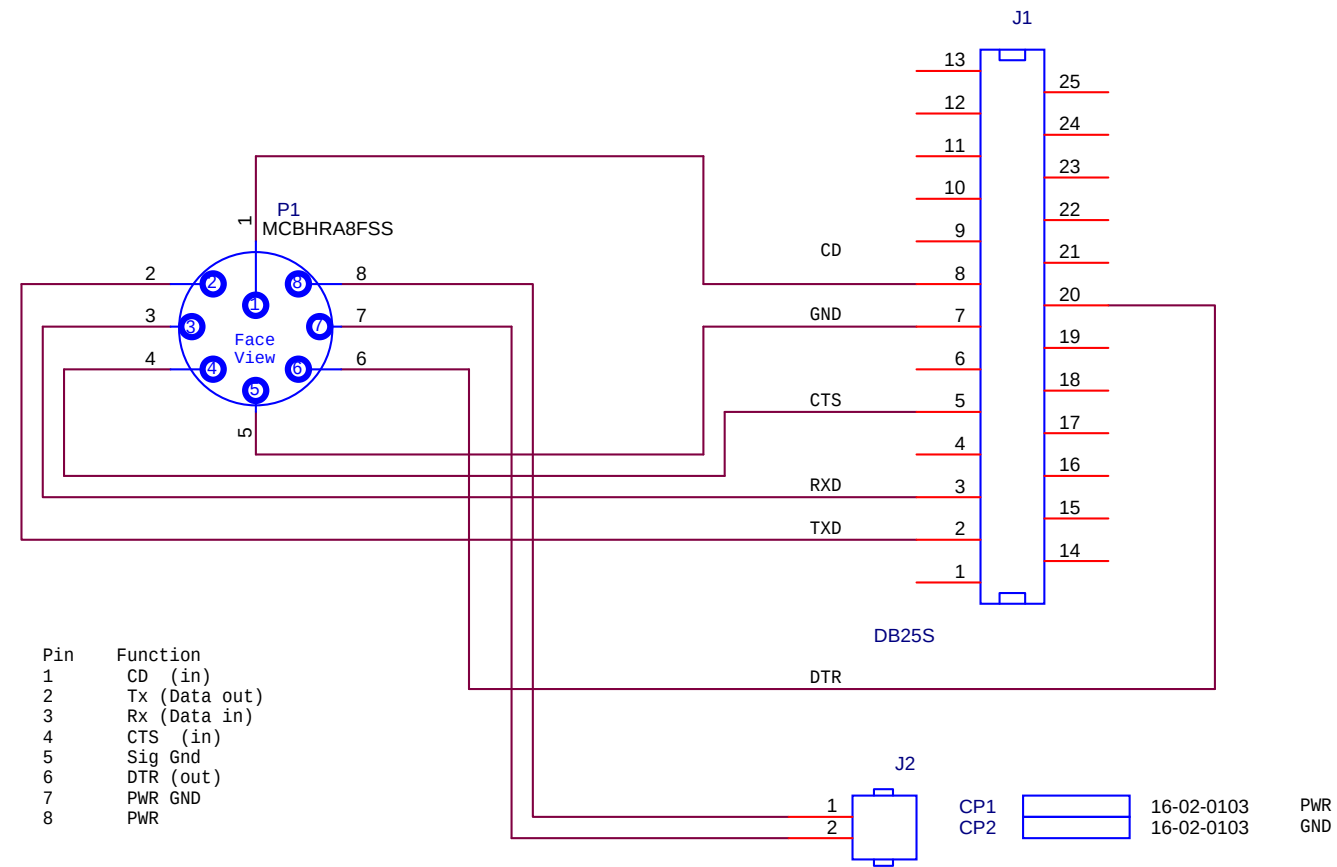

These were backwards. Sleepy pin 1 is power