


"THIS PRINT IS THE PROPERTY OF LEBUS INTERNATIONAL, INC., AND IS ACCEPTED WITH THE CLEAR UNDERSTANDING AND AGREEMENT THAT IT IS TO BE USED ONLY FOR QUOTATION OR MANUFACTURING PURPOSES AT THE DIRECTION OF LEBUS INTERNATIONAL, INC., AND MUST BE RETURNED ON DEMAND, AND FURTHER THAT THIS PRINT WILL NOT BE REPRODUCED, COPIED, OR DUPLICATED IN ANY MANNER WHATSOEVER OR USED FOR ANY OTHER PURPOSE EXCEPT BY PERMISSION OF LEBUS INTERNATIONAL, INC."

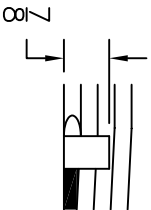


Entry Detail


Half scale

(6" starter end filler only!)

First Full Groove

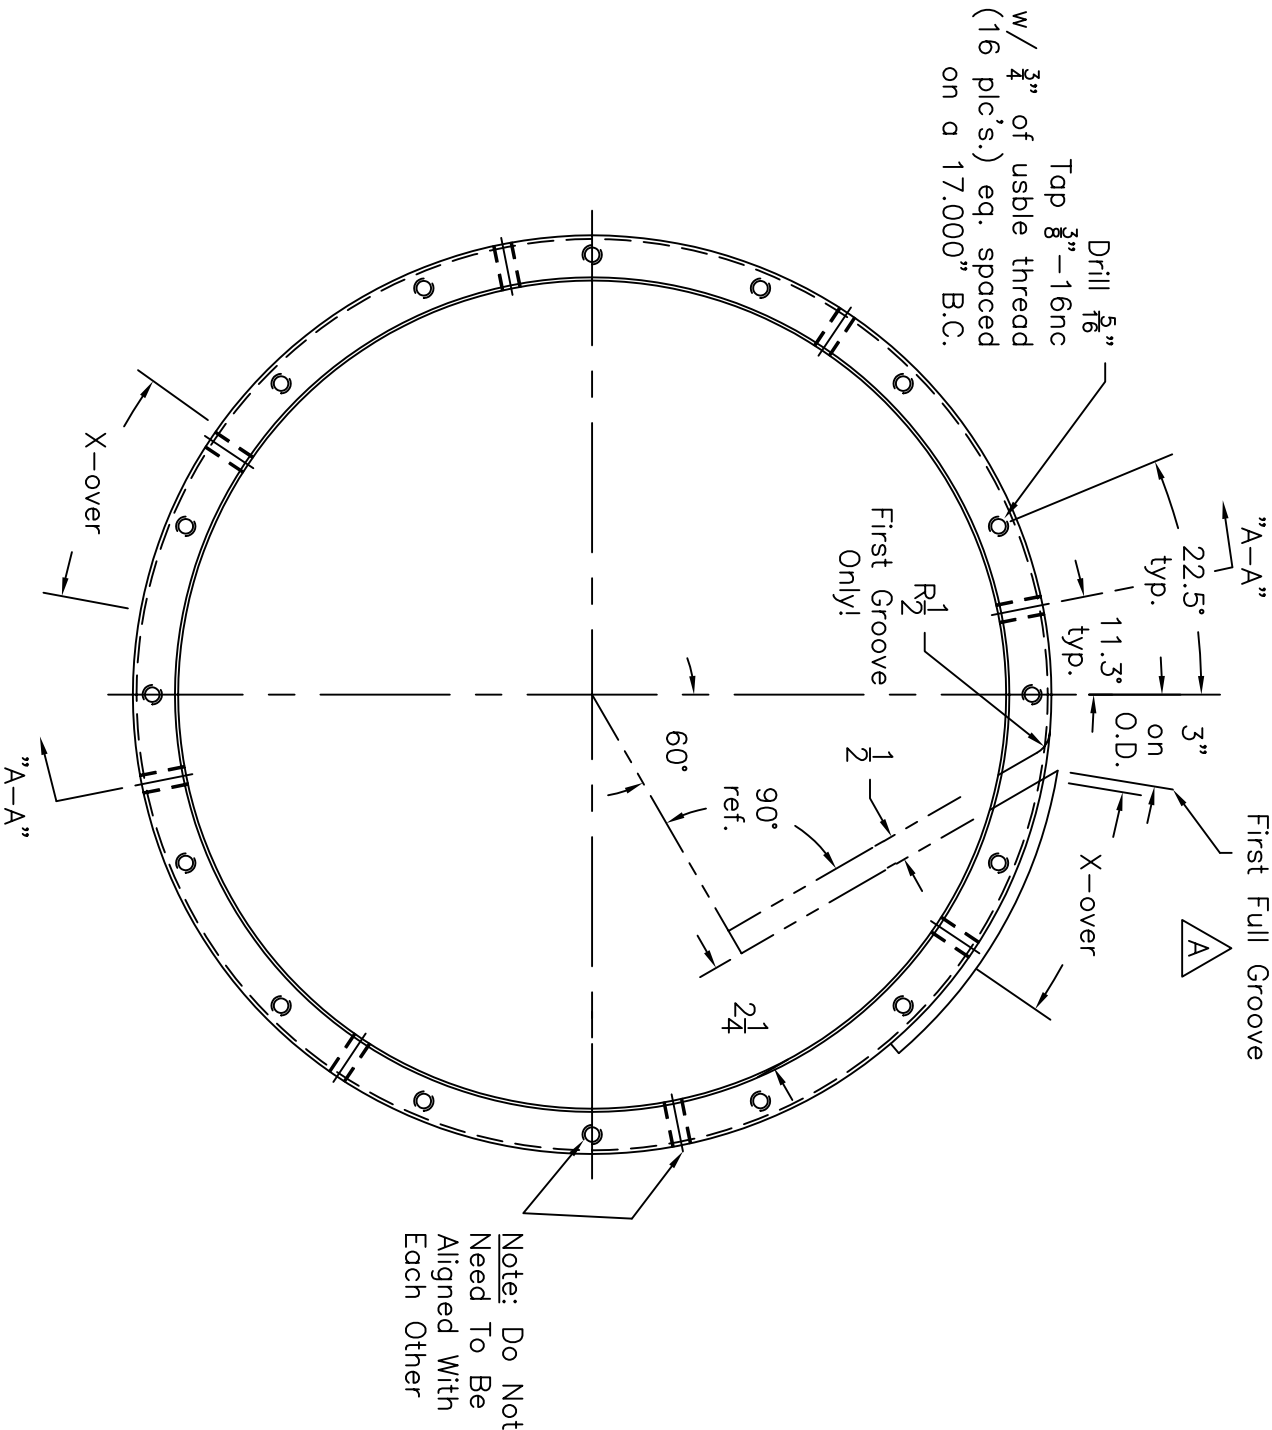

REVISIONS			
LTR	DESCRIPTION	BY	DATE
A	Added (16) 3/8" Tapped Holes		
	Removed Counterbore & Added 1/16" x 45° Chamfer		
	Added Type II Entry	MER	5 Dec., '08

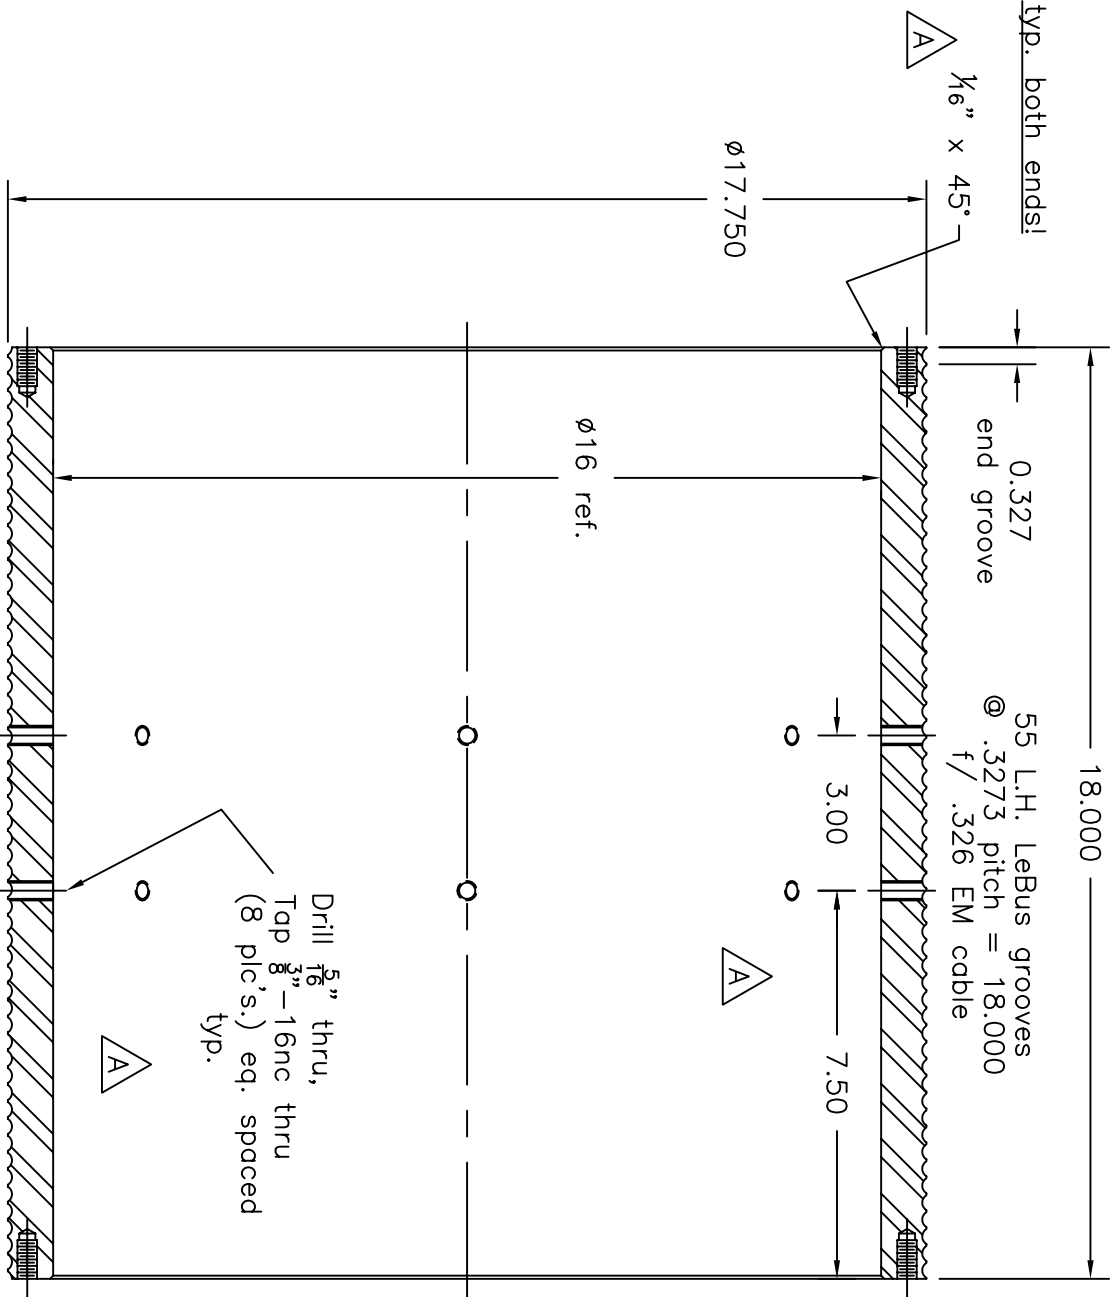

Mat'l: 1" Plate, 6061-T6 Aluminum

UNLESS OTHERWISE SPECIFIED DIMENSIONS ARE IN INCHES.	CONTR	Monterey Bay	LEBUS INTERNATIONAL, INC. LONGVIEW, TEXAS			
	DATE	6 Nov., 2008				
	DRAWN	TRB				
	APPROVAL					
TOLERANCES						
CASTINGS	±1/8"					
FABRICATING	±1/8"					
MACHINING FRACTIONS						
.XX	±.008"					
.XXX	±.004"					
	N.A.		LeBus L.H. Aluminum Core f/.326 EM cable			
	SIZE	CODE IDENT	DWG NO.			
	B	17798	P4460-010B	△		
	SCALE	1/4"=1"	WEIGHT	80#	SHEET	
					1 of 1	