


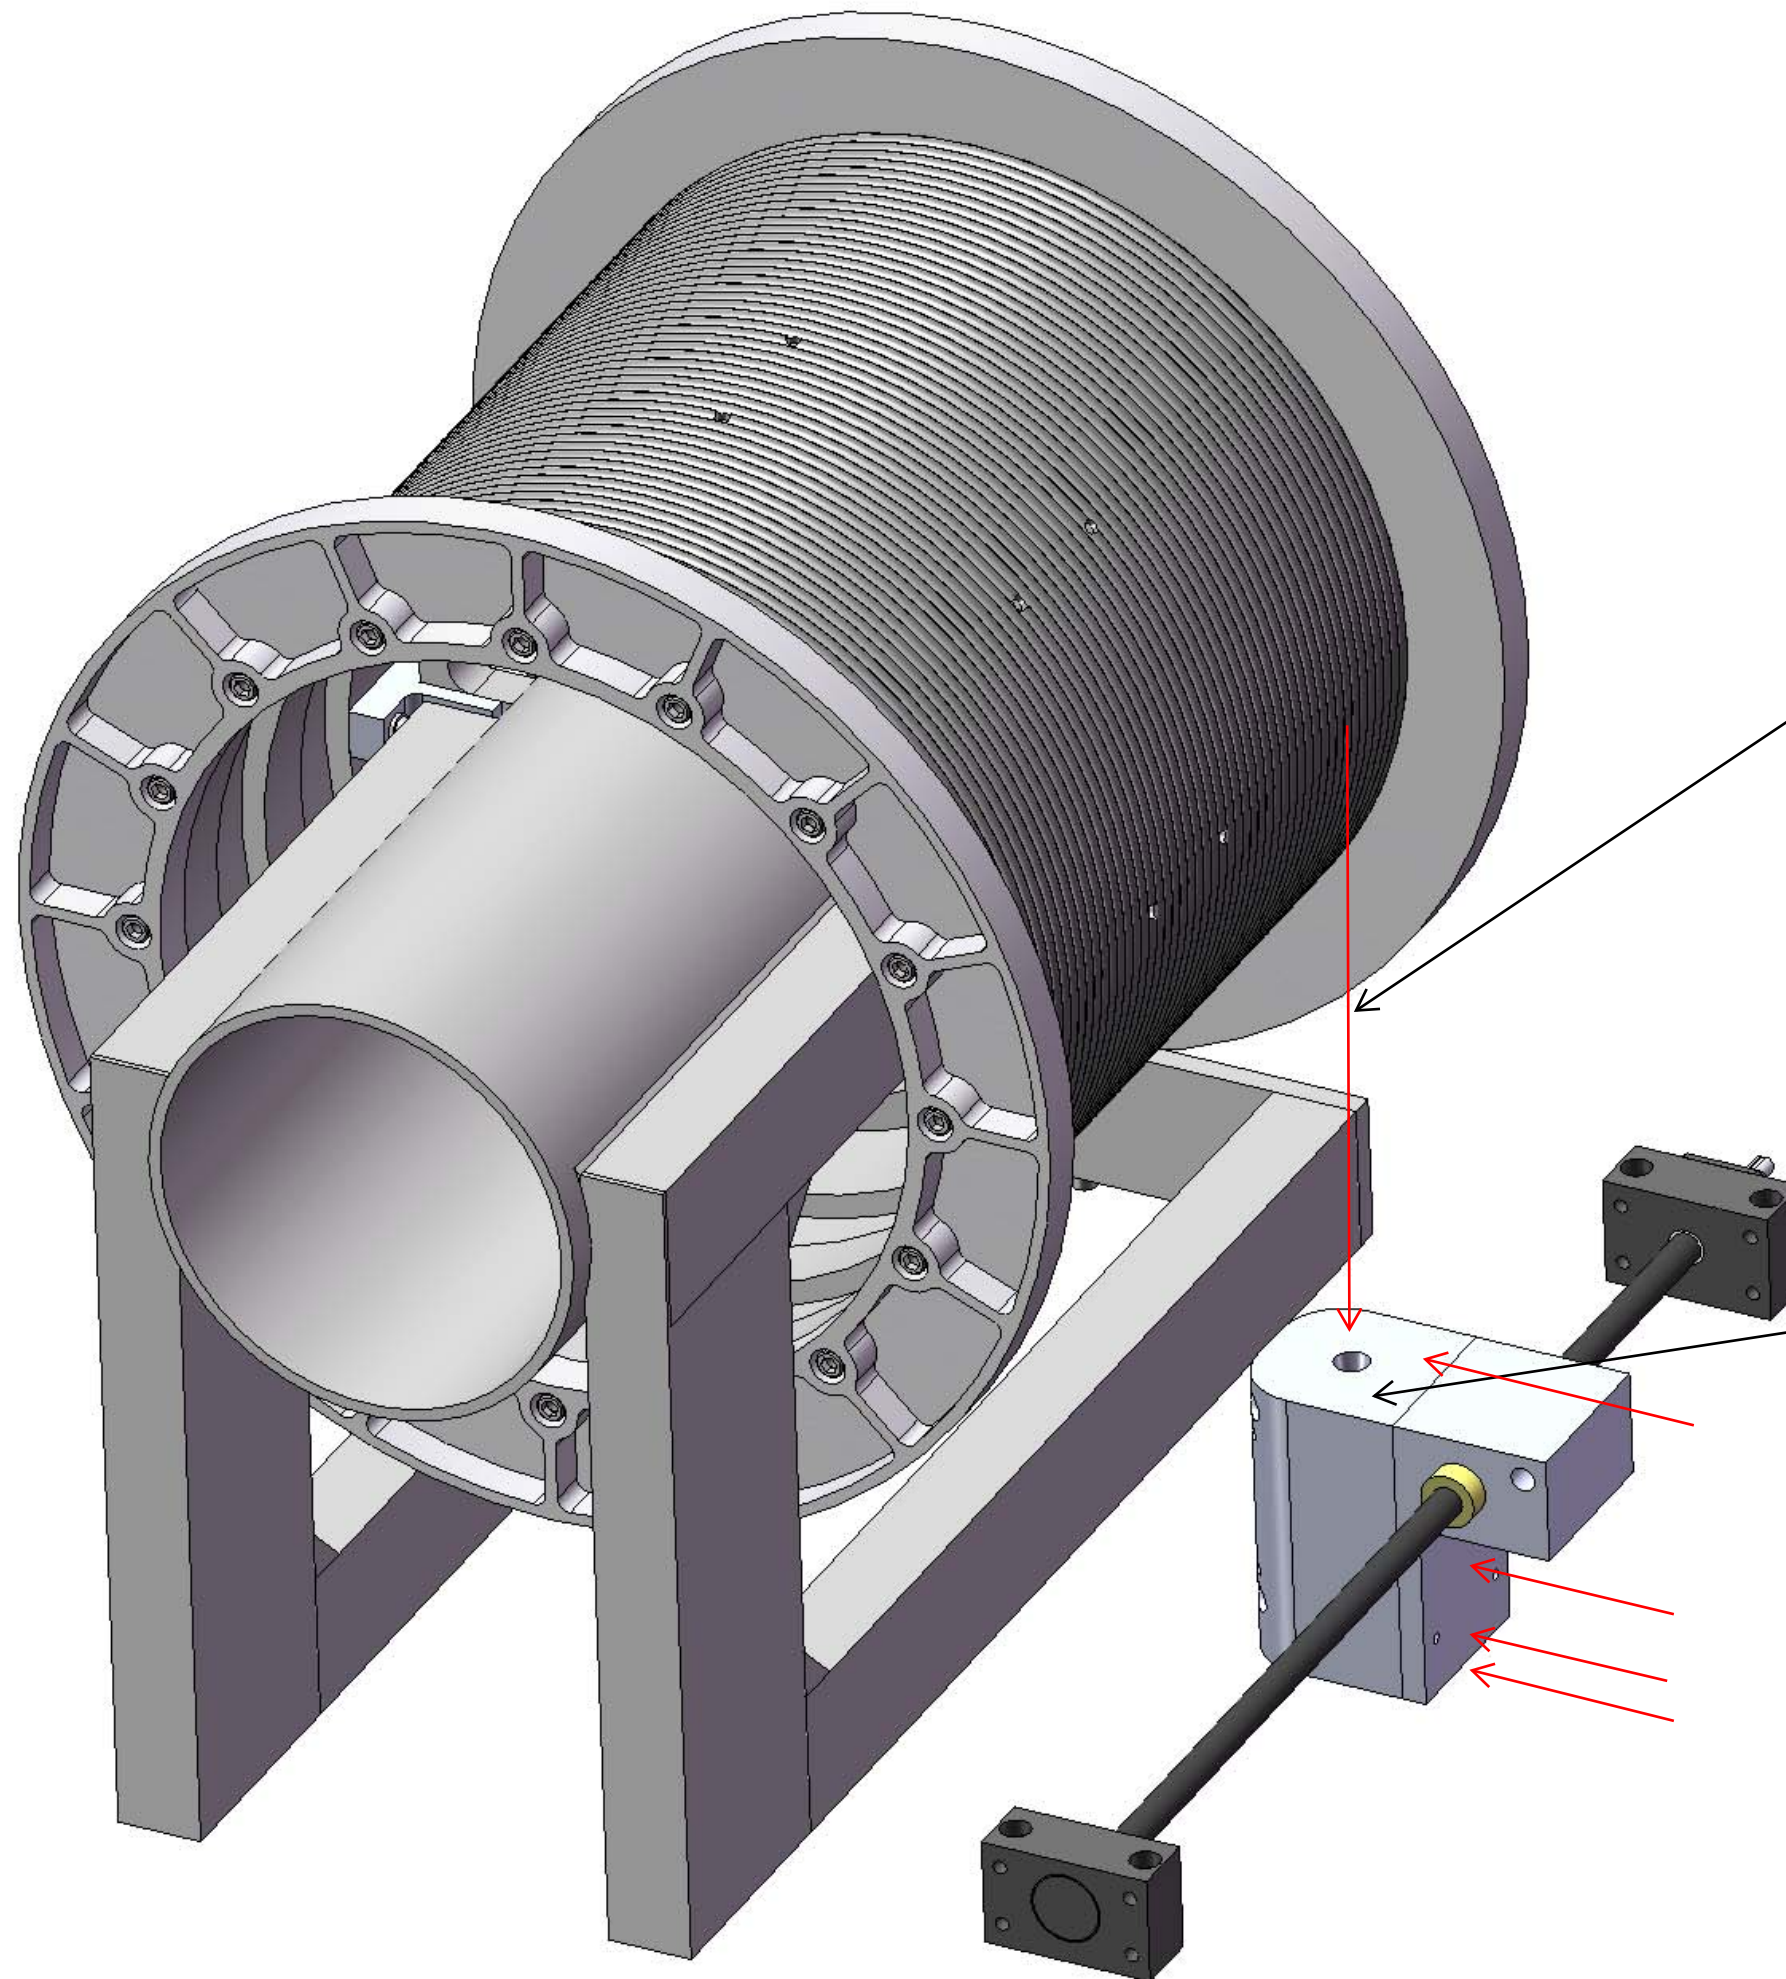

John

The red arrow represents the cable running off the top of the winch drum straight down through the cable guide

Cable Guide

The Cable Guide is about 6" top to bottom

The red arrows are possible places to put proximity sensors

