


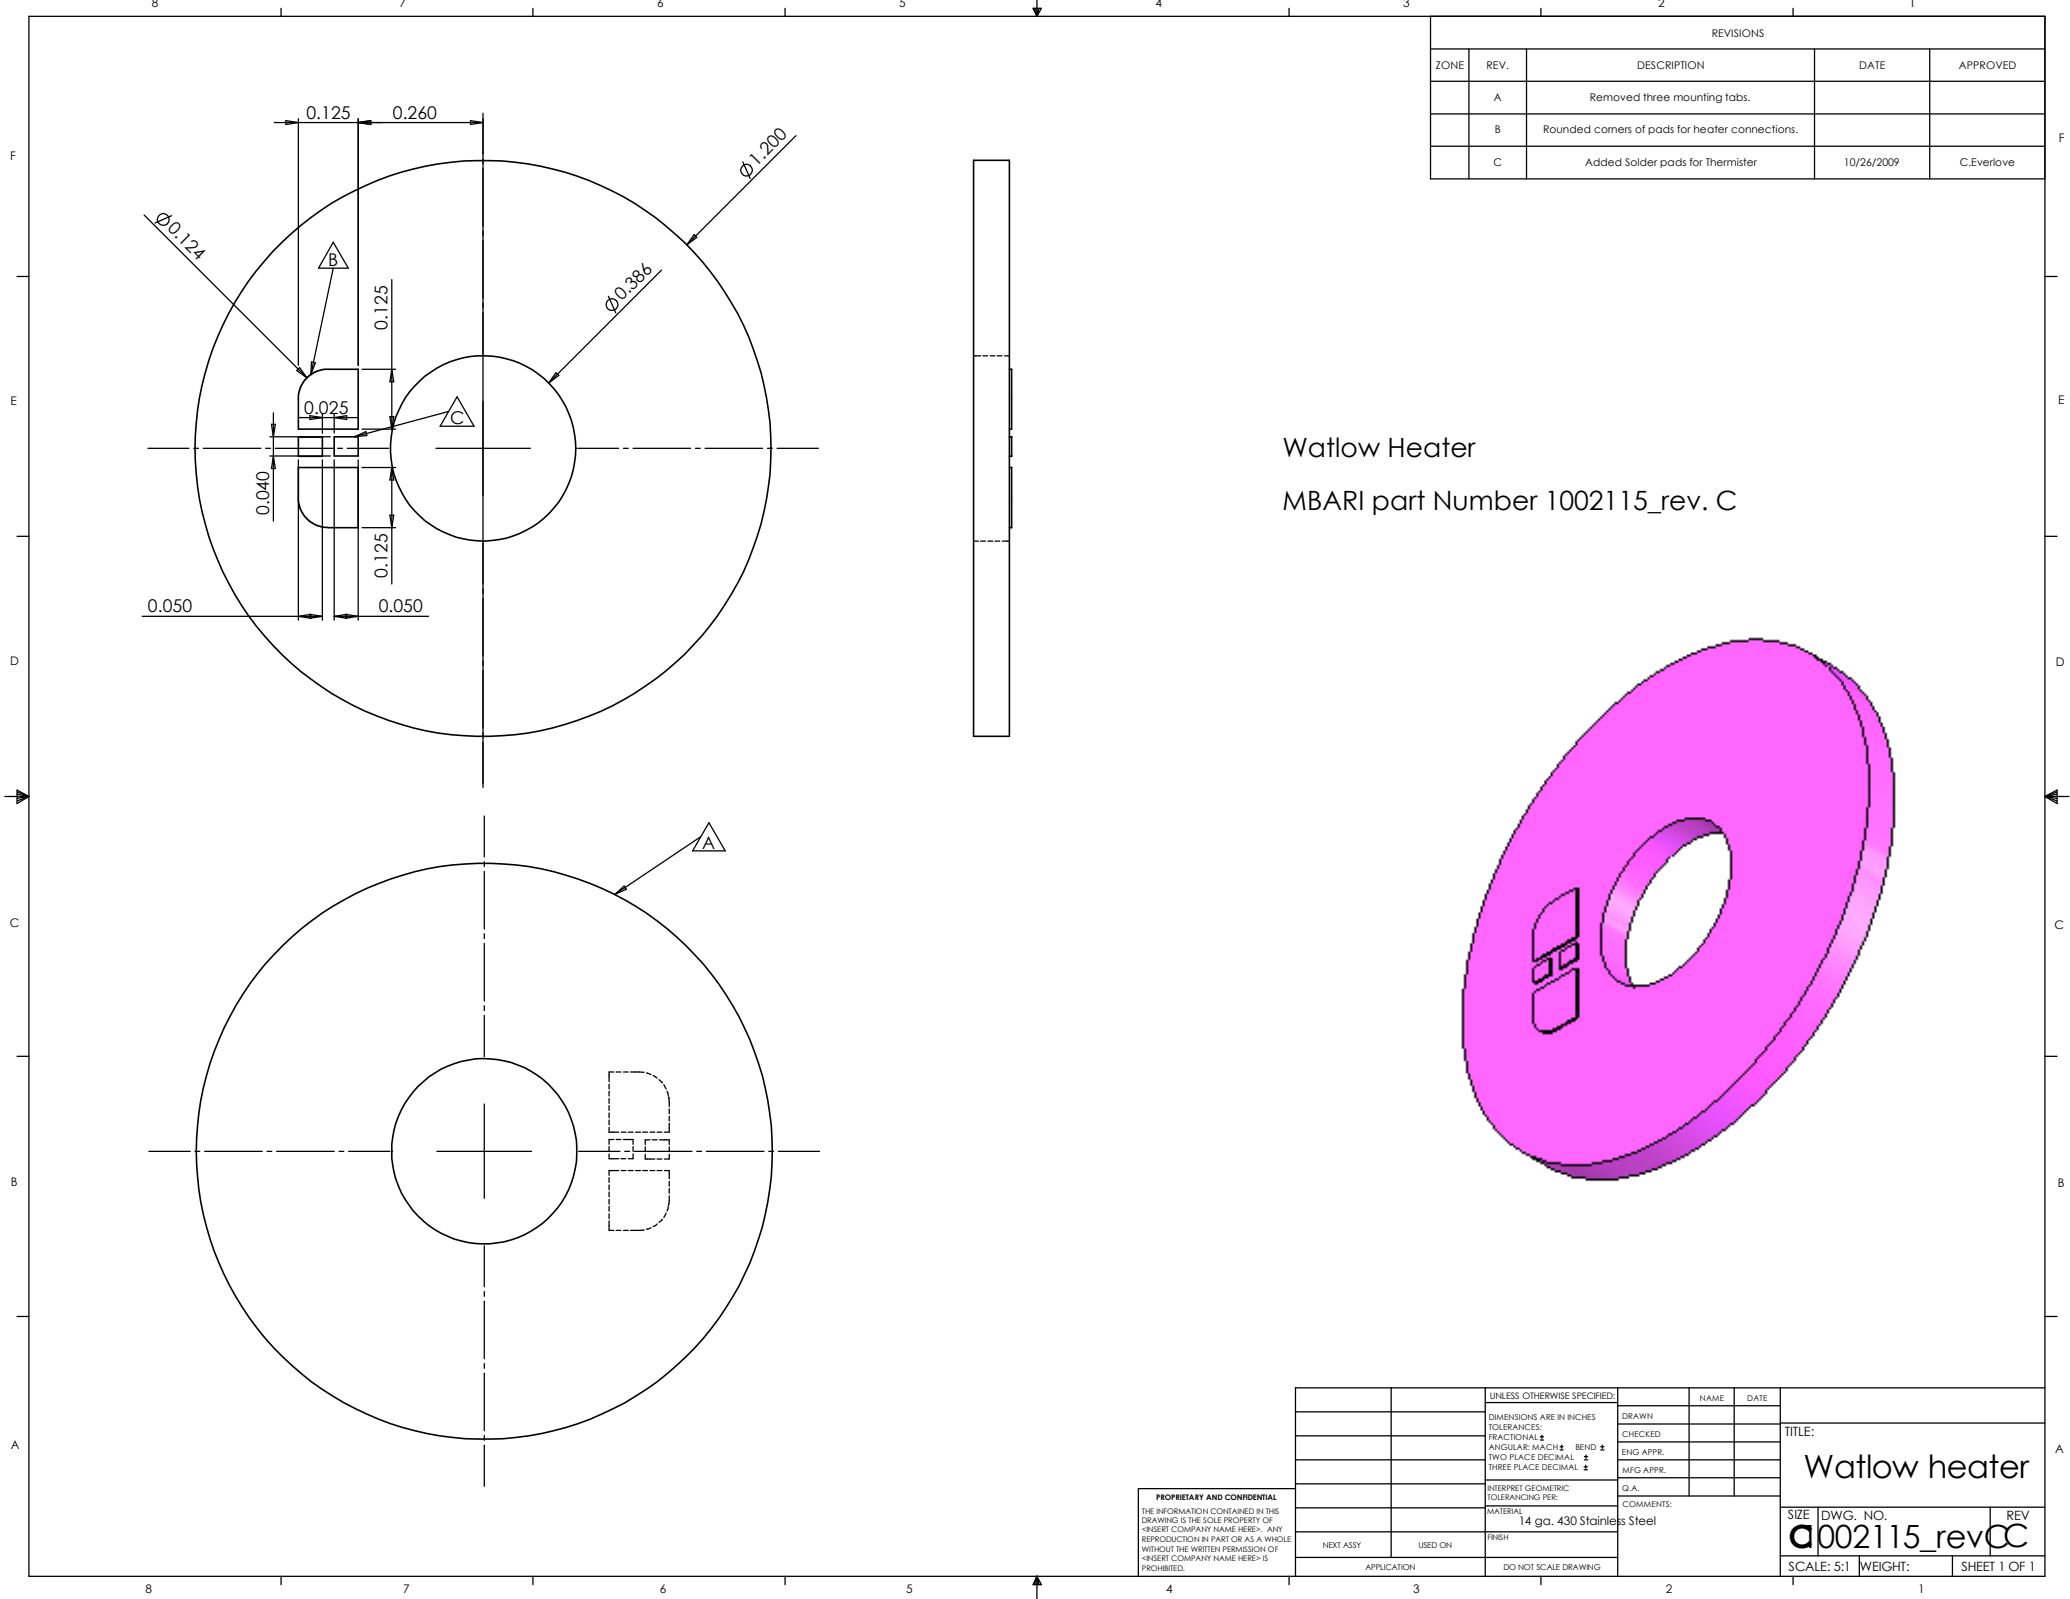

REVISIONS				
ZONE	REV.	DESCRIPTION	DATE	APPROVED
	A	Removed three mounting tabs.		
	B	Rounded corners of pads for heater connections.		
	C	Added Solder pads for Thermister	10/26/2009	C.Everlove

Watlow Heater
MBARI part Number 1002115_rev. C

PROPRIETARY AND CONFIDENTIAL
THE INFORMATION CONTAINED IN THIS
DRAWING IS THE SOLE PROPERTY OF
<INSERT COMPANY NAME HERE>. ANY
REPRODUCTION IN PART OR AS A WHOLE
WITHOUT THE WRITTEN PERMISSION OF
<INSERT COMPANY NAME HERE> IS
PROHIBITED.

		UNLESS OTHERWISE SPECIFIED:		NAME	DATE		
		DIMENSIONS ARE IN INCHES	DRAWN				
		TOLERANCES:	CHECKED				
		FRACTIONAL: $\pm$	ENG APPR.				
		ANGULAR: MACH $\pm$ BEND $\pm$	MFG APPR.				
		TWO PLACE DECIMAL $\pm$	D.A.				
		THREE PLACE DECIMAL $\pm$	COMMENTS:				
		INTERPRET GEOMETRIC TOLERANCING PER:					
		MATERIAL					
		14 ga. 430 Stainless Steel					
		FINISH					
NEXT ASSY	USED ON	APPLICATION	DO NOT SCALE DRAWING				

TITLE:
Watlow heater

SIZE DWG. NO.
A002115_revCC

SCALE: 5:1 WEIGHT: SHEET 1 OF 1