


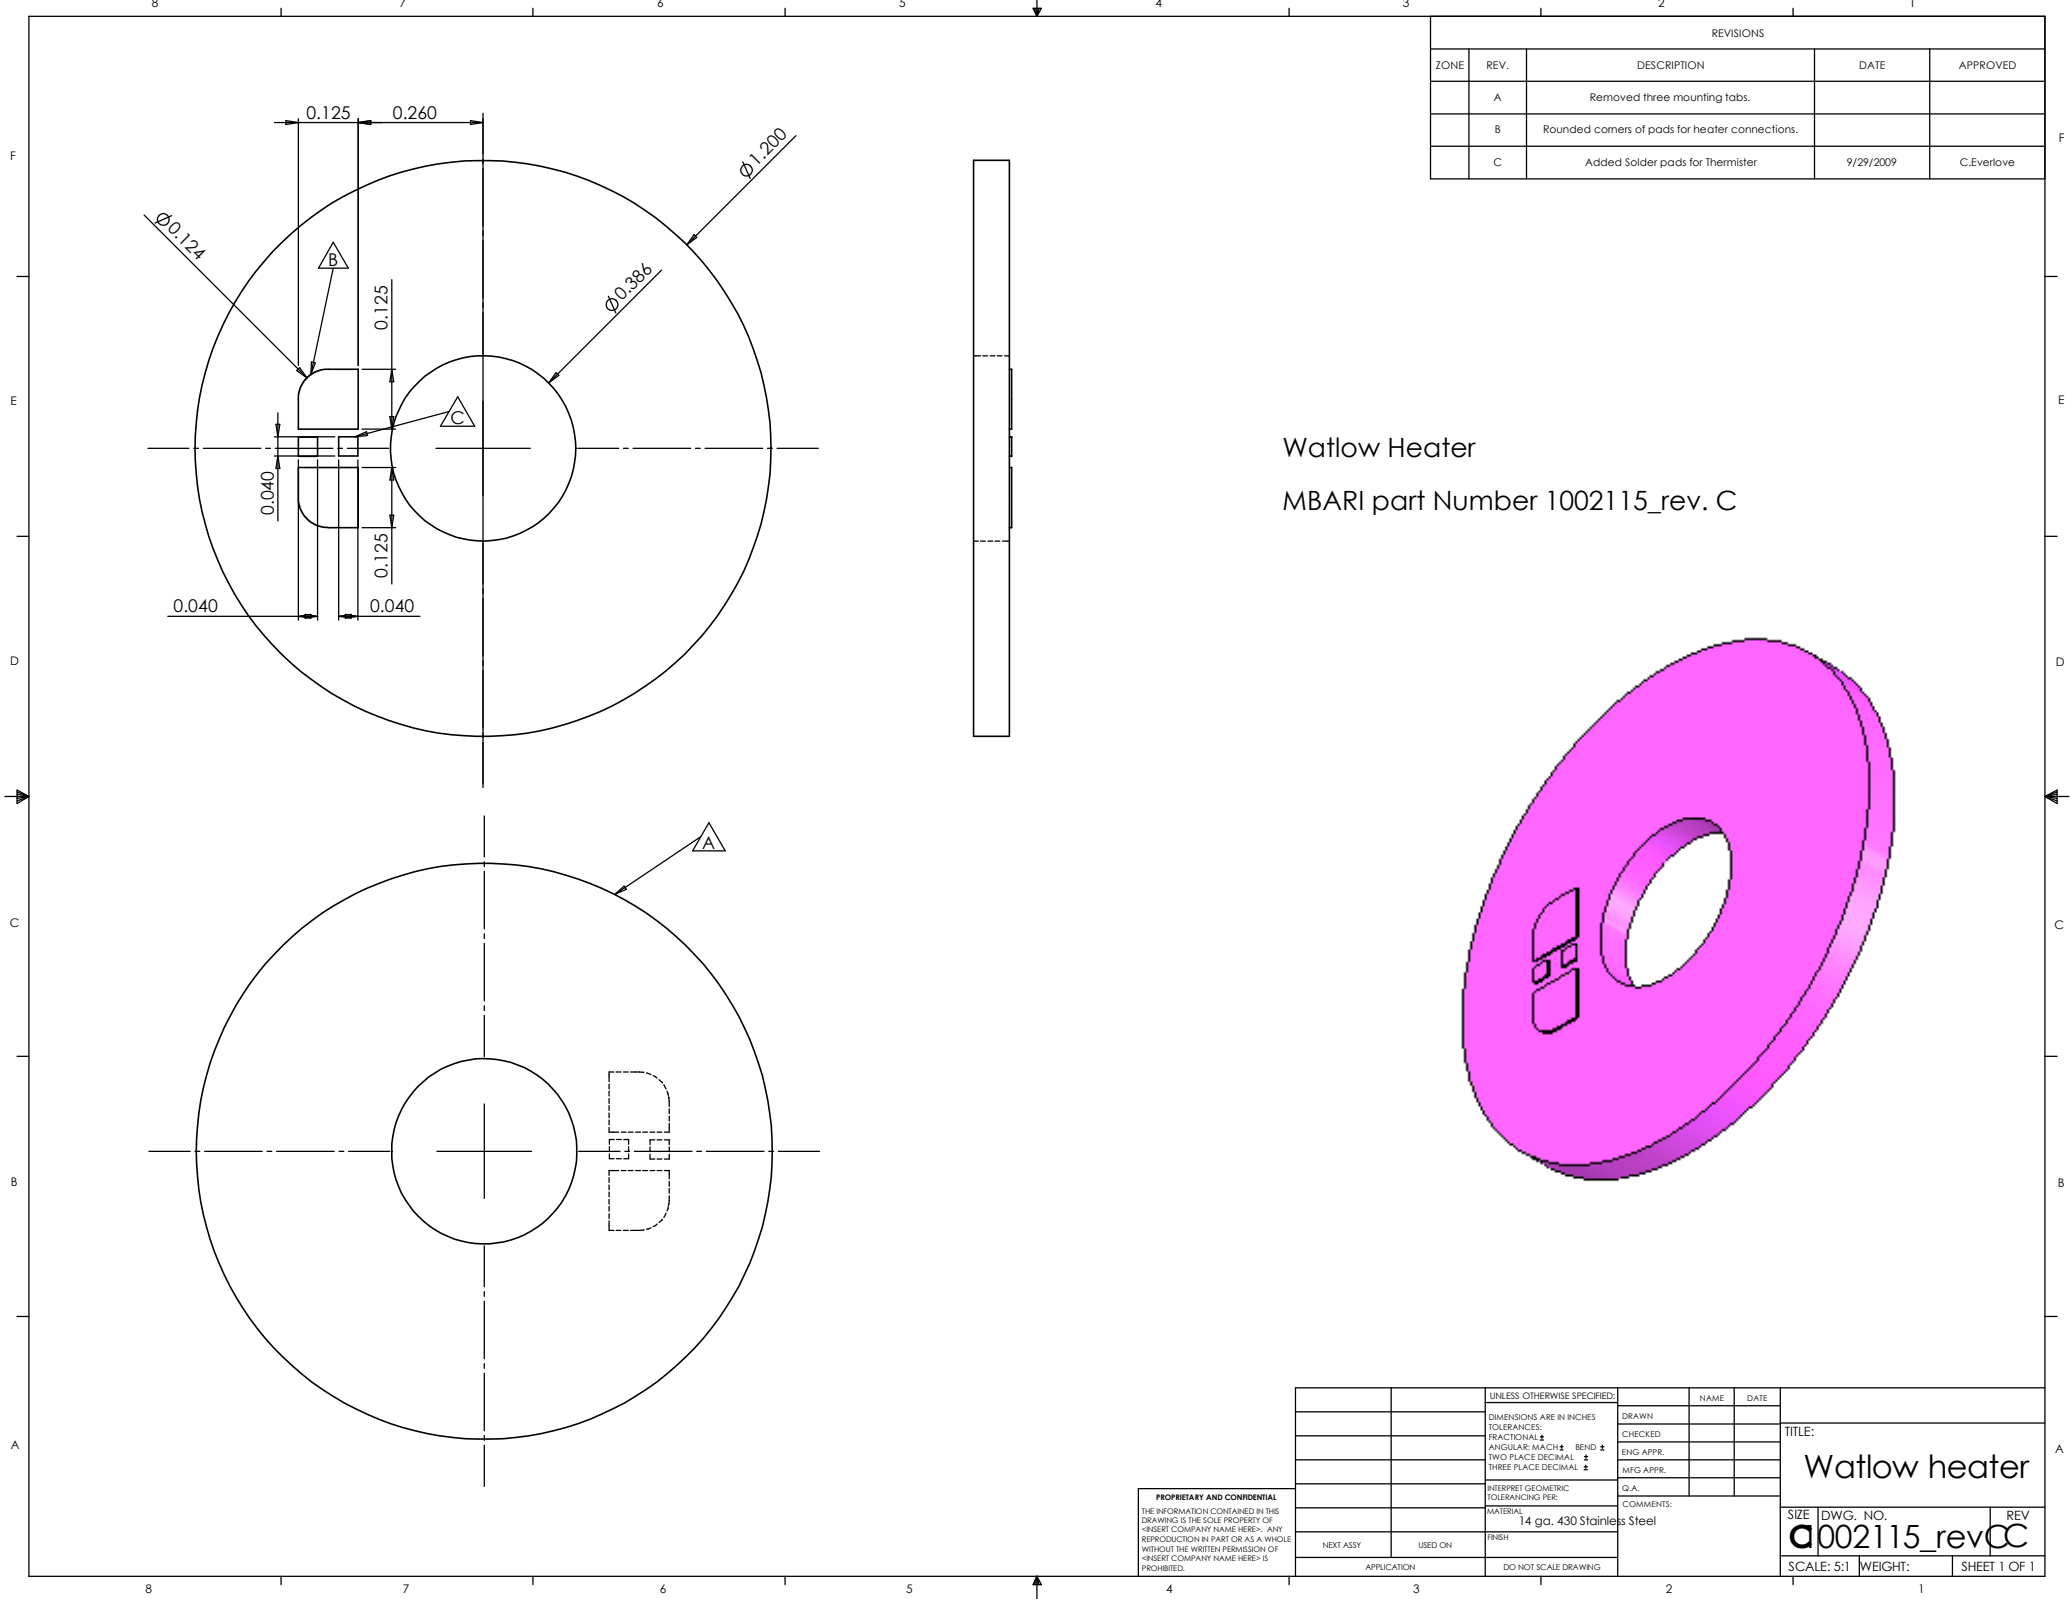

REVISIONS				
ZONE	REV.	DESCRIPTION	DATE	APPROVED
	A	Removed three mounting tabs.		
	B	Rounded corners of pads for heater connections.		
	C	Added Solder pads for Thermister	9/29/2009	C.Everlove

Watlow Heater
MBARI part Number 1002115_rev. C

PROPRIETARY AND CONFIDENTIAL
THE INFORMATION CONTAINED IN THIS
DRAWING IS THE SOLE PROPERTY OF
<INSERT COMPANY NAME HERE>. ANY
REPRODUCTION IN PART OR AS A WHOLE
WITHOUT THE WRITTEN PERMISSION OF
<INSERT COMPANY NAME HERE> IS
PROHIBITED.

UNLESS OTHERWISE SPECIFIED:		NAME	DATE	TITLE:	
DIMENSIONS ARE IN INCHES		DRAWN			
TOLERANCES:		CHECKED		Watlow heater	
FRACTIONAL: $\pm$		ENG APPR.			
ANGULAR: MACH $\pm$ BEND $\pm$		D.A.			
TWO PLACE DECIMAL: $\pm$		COMMENTS:		SIZE DWG. NO. REV	
THREE PLACE DECIMAL: $\pm$					
INTERPRET GEOMETRIC TOLERANCING PER:				SCALE: 5:1 WEIGHT: SHEET 1 OF 1	
MATERIAL					
14 ga. 430 Stainless Steel				a002115_revCC	
FINISH					
NEXT ASSY	USED ON				
APPLICATION		DO NOT SCALE DRAWING			