


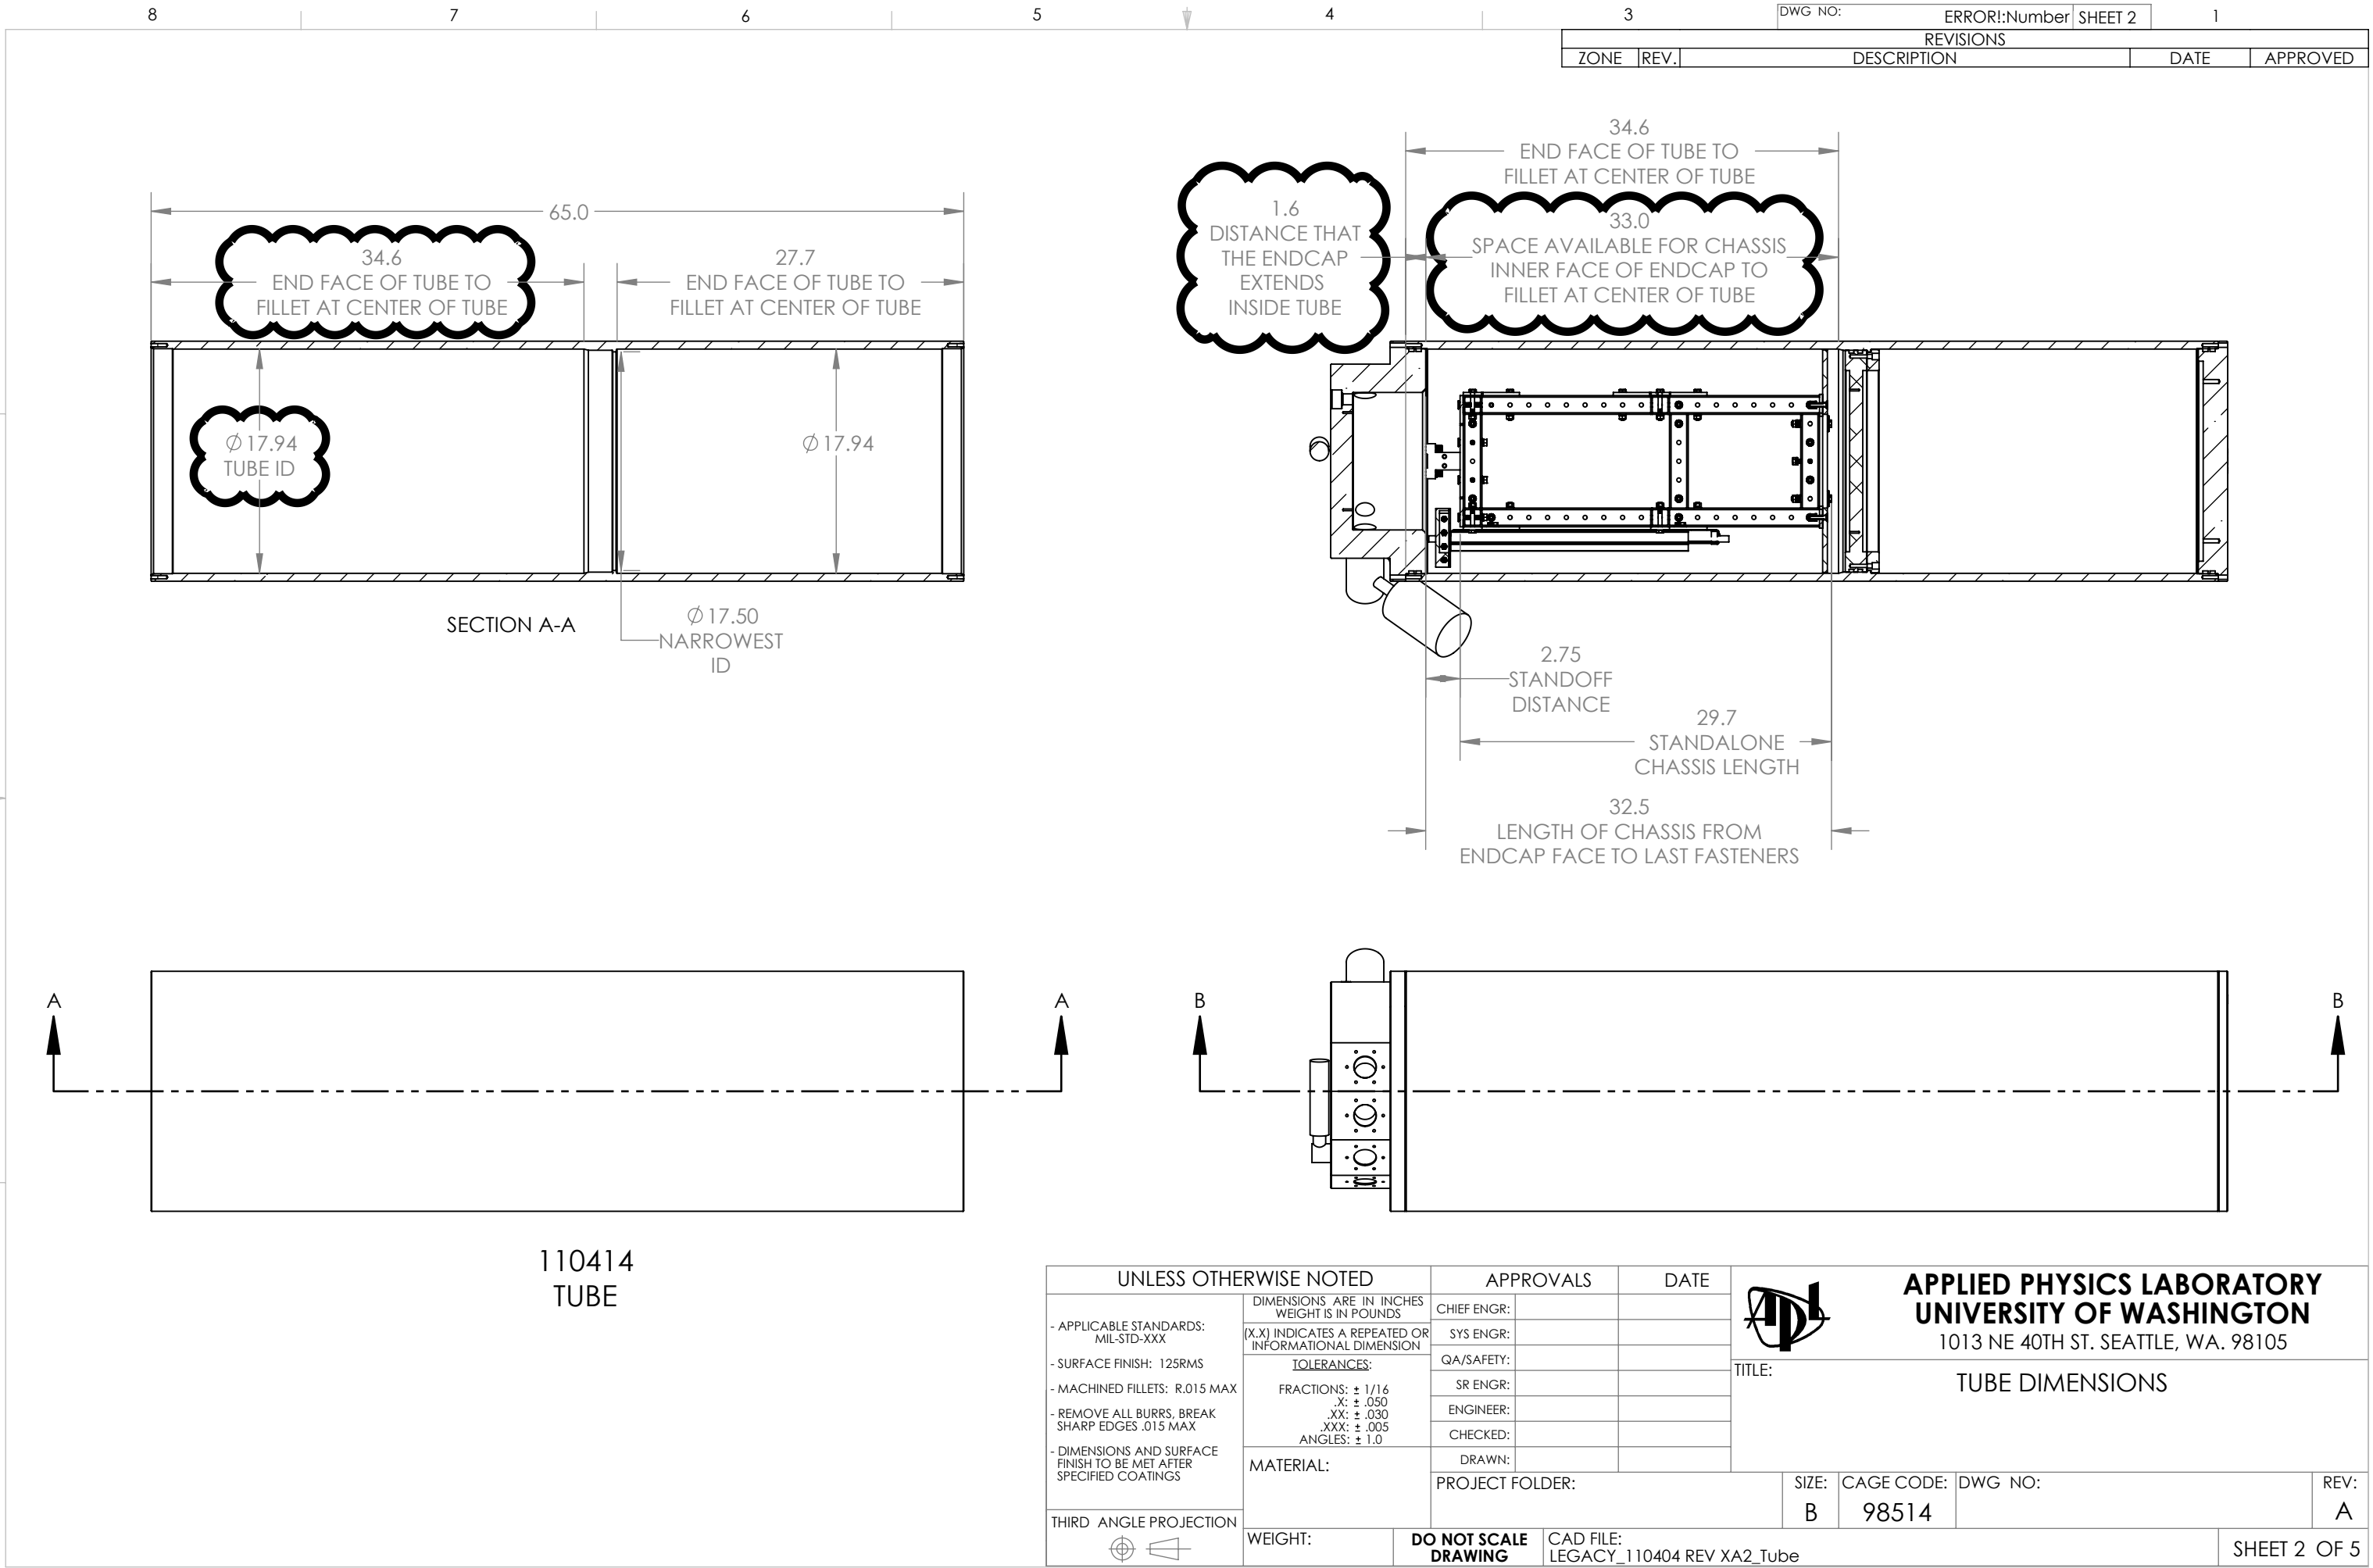

UNLESS OTHERWISE NOTED		APPROVALS		DATE	APL APPLIED PHYSICS LABORATORY UNIVERSITY OF WASHINGTON 1013 NE 40TH ST. SEATTLE, WA. 98105				
- APPLICABLE STANDARDS: MIL-STD-XXX - SURFACE FINISH: 125RMS - MACHINED FILLETS: R.015 MAX - REMOVE ALL BURRS, BREAK SHARP EDGES .015 MAX - DIMENSIONS AND SURFACE FINISH TO BE MET AFTER SPECIFIED COATINGS	DIMENSIONS ARE IN INCHES WEIGHT IS IN POUNDS		CHIEF ENGR:		TITLE: TUBE DIMENSIONS				
	(X.X) INDICATES A REPEATED OR INFORMATIONAL DIMENSION		SYS ENGR:						
	TOLERANCES:		QA/SAFETY:						
	FRACTIONS: ± 1/16 .X: ± .050 .XX: ± .030 .XXX: ± .005 ANGLES: ± 1.0		SR ENGR:						
	MATERIAL:		ENGINEER:						
			CHECKED:						
			DRAWN:						
THIRD ANGLE PROJECTION 		PROJECT FOLDER:			SIZE: B	CAGE CODE: 98514	DWG NO:		REV: A
		WEIGHT:	DO NOT SCALE DRAWING	CAD FILE: LEGACY_110404 REV XA2_Tube					SHEET 2 OF 5