
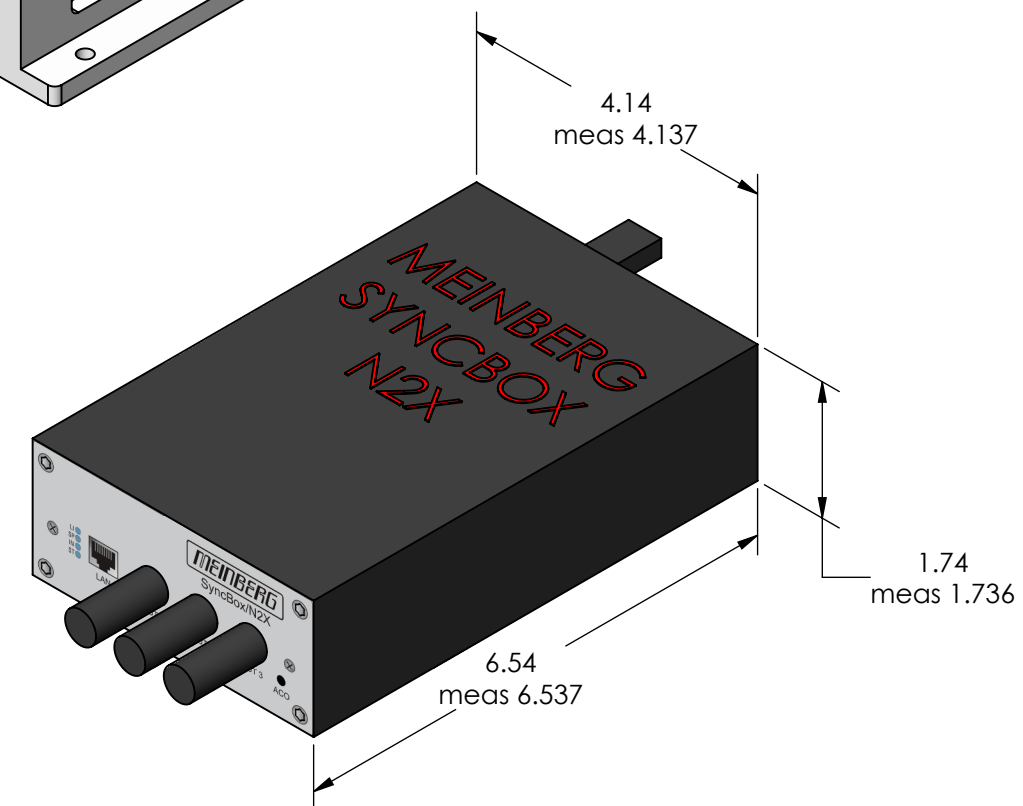
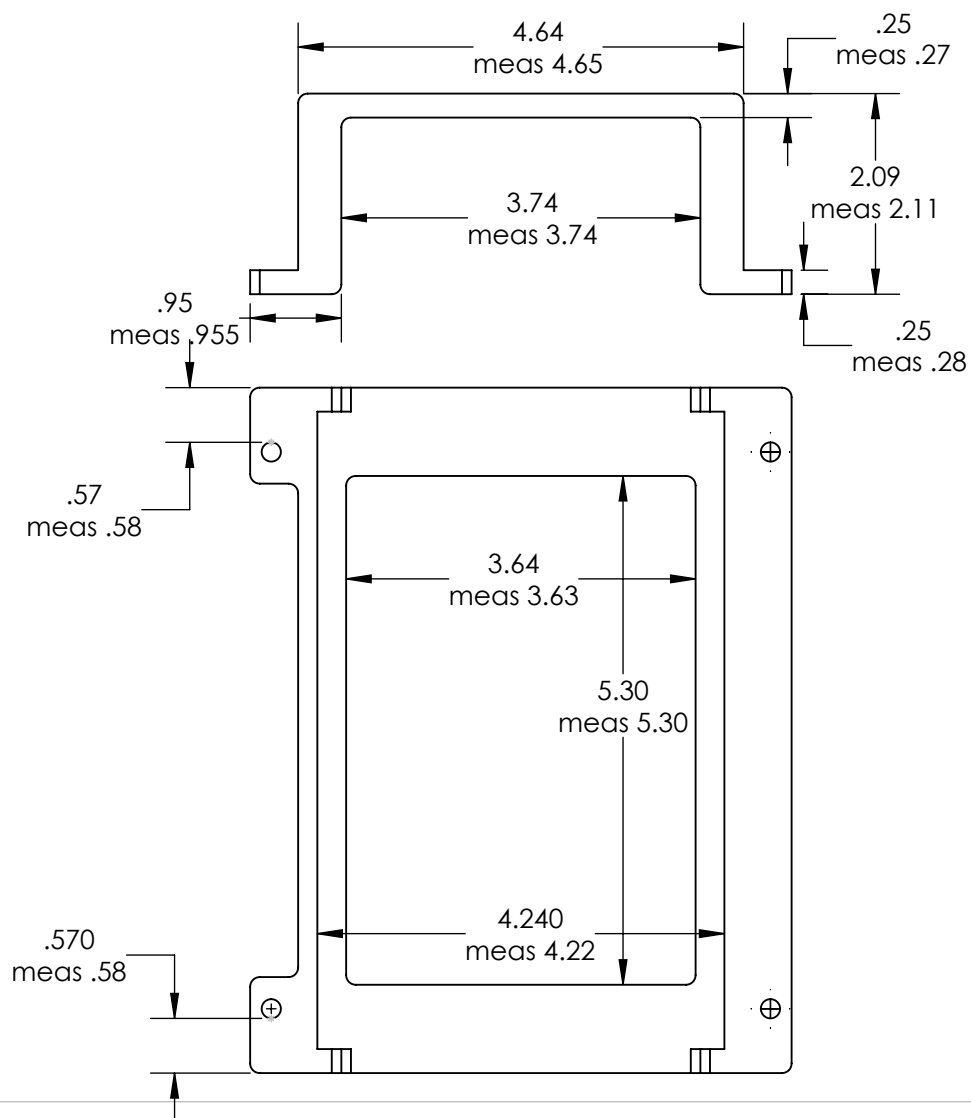
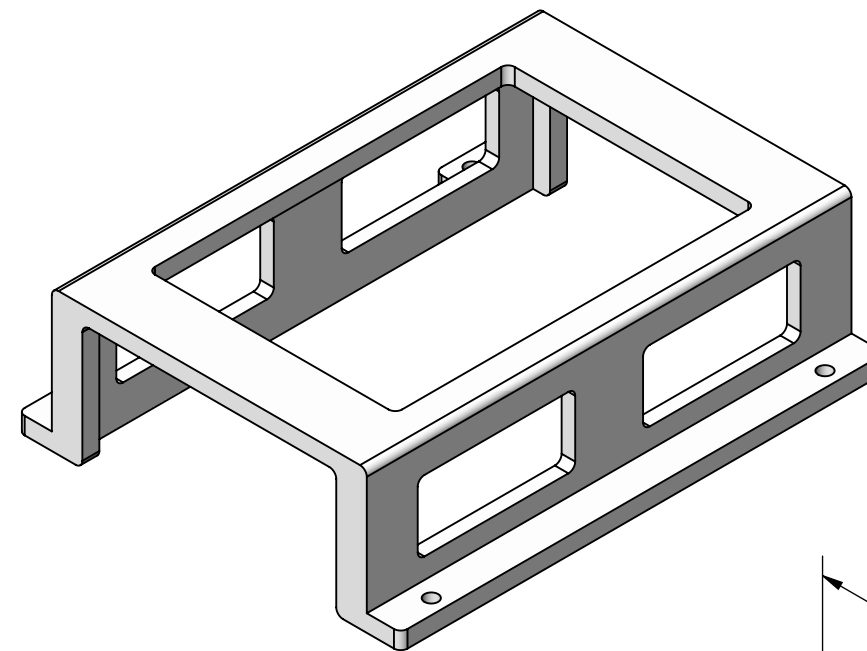


NOTES:
BREAK SHARP EDGES

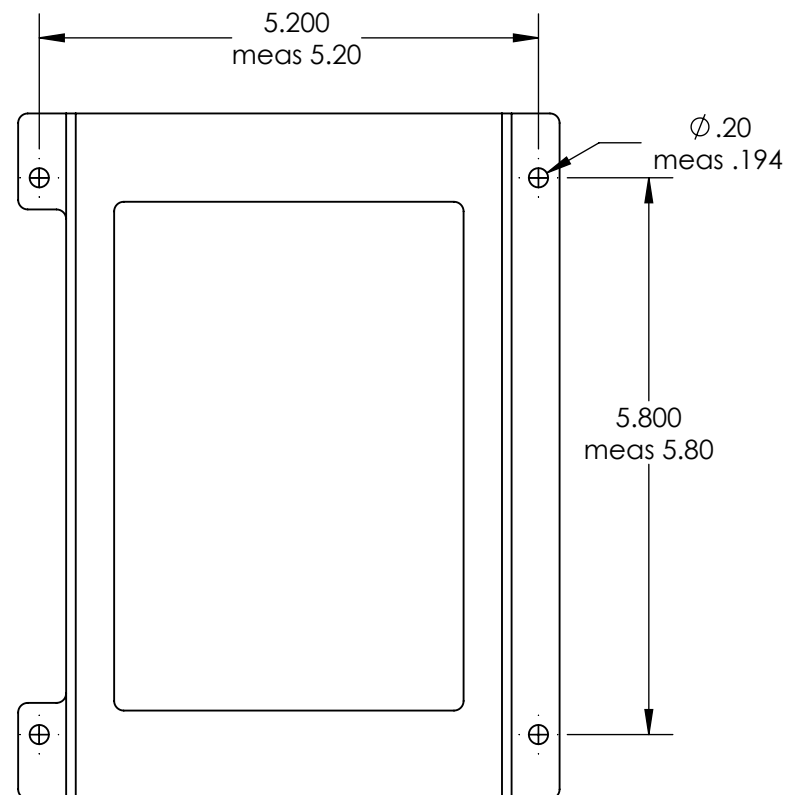

UNLESS OTHERWISE NOTED			APPROVALS		DATE		 APPLIED PHYSICS LABORATORY UNIVERSITY OF WASHINGTON 1013 NE 40TH ST. SEATTLE, WA. 98105			
- APPLICABLE STANDARDS: MIL-STD-XXX - SURFACE FINISH: 125RMS - MACHINED FILLETS: R.015 MAX - REMOVE ALL BURRS, BREAK SHARP EDGES .015 MAX - DIMENSIONS AND SURFACE FINISH TO BE MET AFTER SPECIFIED COATINGS	DIMENSIONS ARE IN INCHES WEIGHT IS IN POUNDS		CHIEF ENGR:				TITLE: MOUNT BRACKET, MEINBERG SYNCBOX			
	(X.X) INDICATES A REPEATED OR INFORMATIONAL DIMENSION		SYS ENGR:							
	<u>TOLERANCES:</u>		QA/SAFETY:							
	FRACTIONS: $\pm 1/16$.X: $\pm .050$.XX: $\pm .030$.XXX: $\pm .005$ ANGLES: ± 1.0		SR ENGR:							
			ENGINEER:		JESS NOE --/--/----					
			CHECKED:							
	MATERIAL:		DRAWN:		JESS NOE --/--/----					
Material <not specified>		PROJECT FOLDER:				SIZE:	CAGE CODE:	DWG NO:	REV:	
---						B	98514		90565	A
THIRD ANGLE PROJECTION		DO NOT SCALE DRAWING		CAD FILE: 90565				SHEET 1 OF 1		
		WEIGHT: 0.301								