




NOTES:
BREAK SHARP EDGES

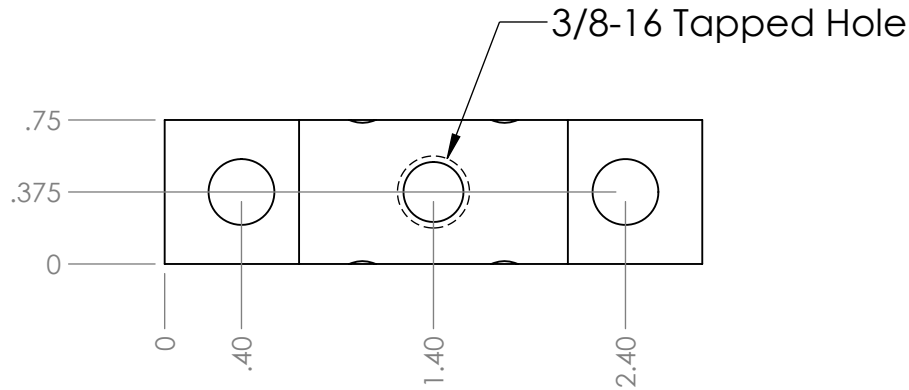

1.65
ESTIMATE
OF LENGTH
FROM PHOTO

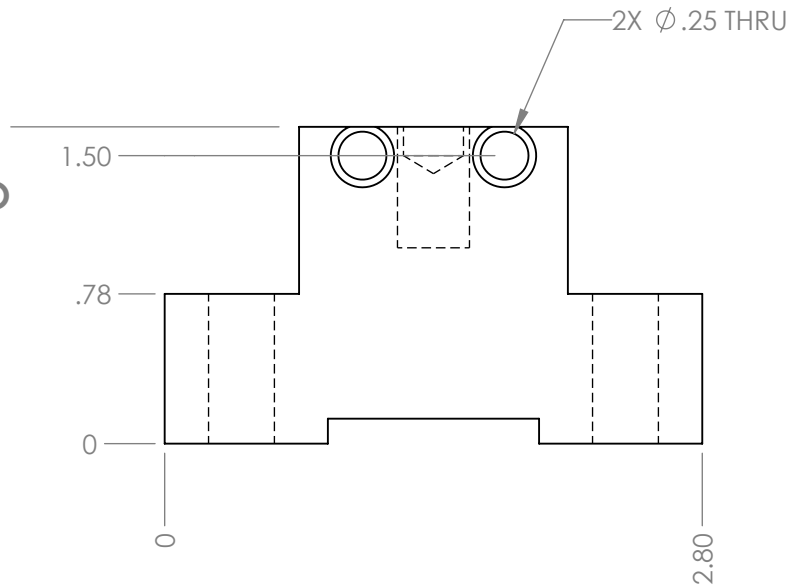

DEPTH OF TAPPED HOLE?

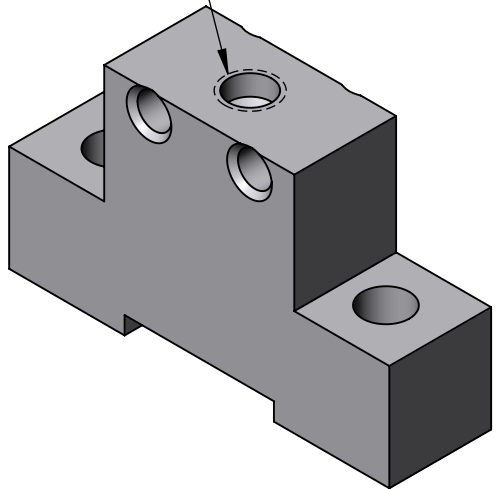

APL SHOP INFORMATION	
Worktag	XXX-XXX
TASK #	AAA
QUANTITY	x
ORIGINATOR	JESS NOE
PHONE #	206-218-6167
EMAIL	noej@uw.edu

UNLESS OTHERWISE NOTED		APPROVALS		DATE	APL APPLIED PHYSICS LABORATORY UNIVERSITY OF WASHINGTON 1013 NE 40TH ST. SEATTLE, WA. 98105				
- APPLICABLE STANDARDS: MIL-STD-XXX - SURFACE FINISH: 125RMS - MACHINED FILLETS: R.015 MAX - REMOVE ALL BURRS, BREAK SHARP EDGES .015 MAX - DIMENSIONS AND SURFACE FINISH TO BE MET AFTER SPECIFIED COATINGS	DIMENSIONS ARE IN INCHES WEIGHT IS IN POUNDS	CHIEF ENGR:			TITLE: LEGACY, 110665-001 CHASSIS SUPPORT BRACKET				
	(X,X) INDICATES A REPEATED OR INFORMATIONAL DIMENSION	SYS ENGR:							
	TOLERANCES:	QA/SAFETY:							
	FRACTIONS: ± 1/16 .X: ± .050 .XX: ± .030 .XXX: ± .005 ANGLES: ± 1.0	SR ENGR:							
	MATERIAL: 6061-T6 Aluminum	ENGINEER:	JESS NOE	--/--/----					
		CHECKED:							
THIRD ANGLE PROJECTION 		DRAWN:	JESS NOE	--/--/----	SIZE:	CAGE CODE:	DWG NO:	REV:	
		PROJECT FOLDER:			B	98514		A	
		MARS LEGACY							
WEIGHT: 0.216		DO NOT SCALE DRAWING	CAD FILE: ACTUAL BUILD_LEGACY_110665-001 XA_Chassis Support Bracket					SHEET 1 OF 1	