DWG NO: 86239 SHEET 1

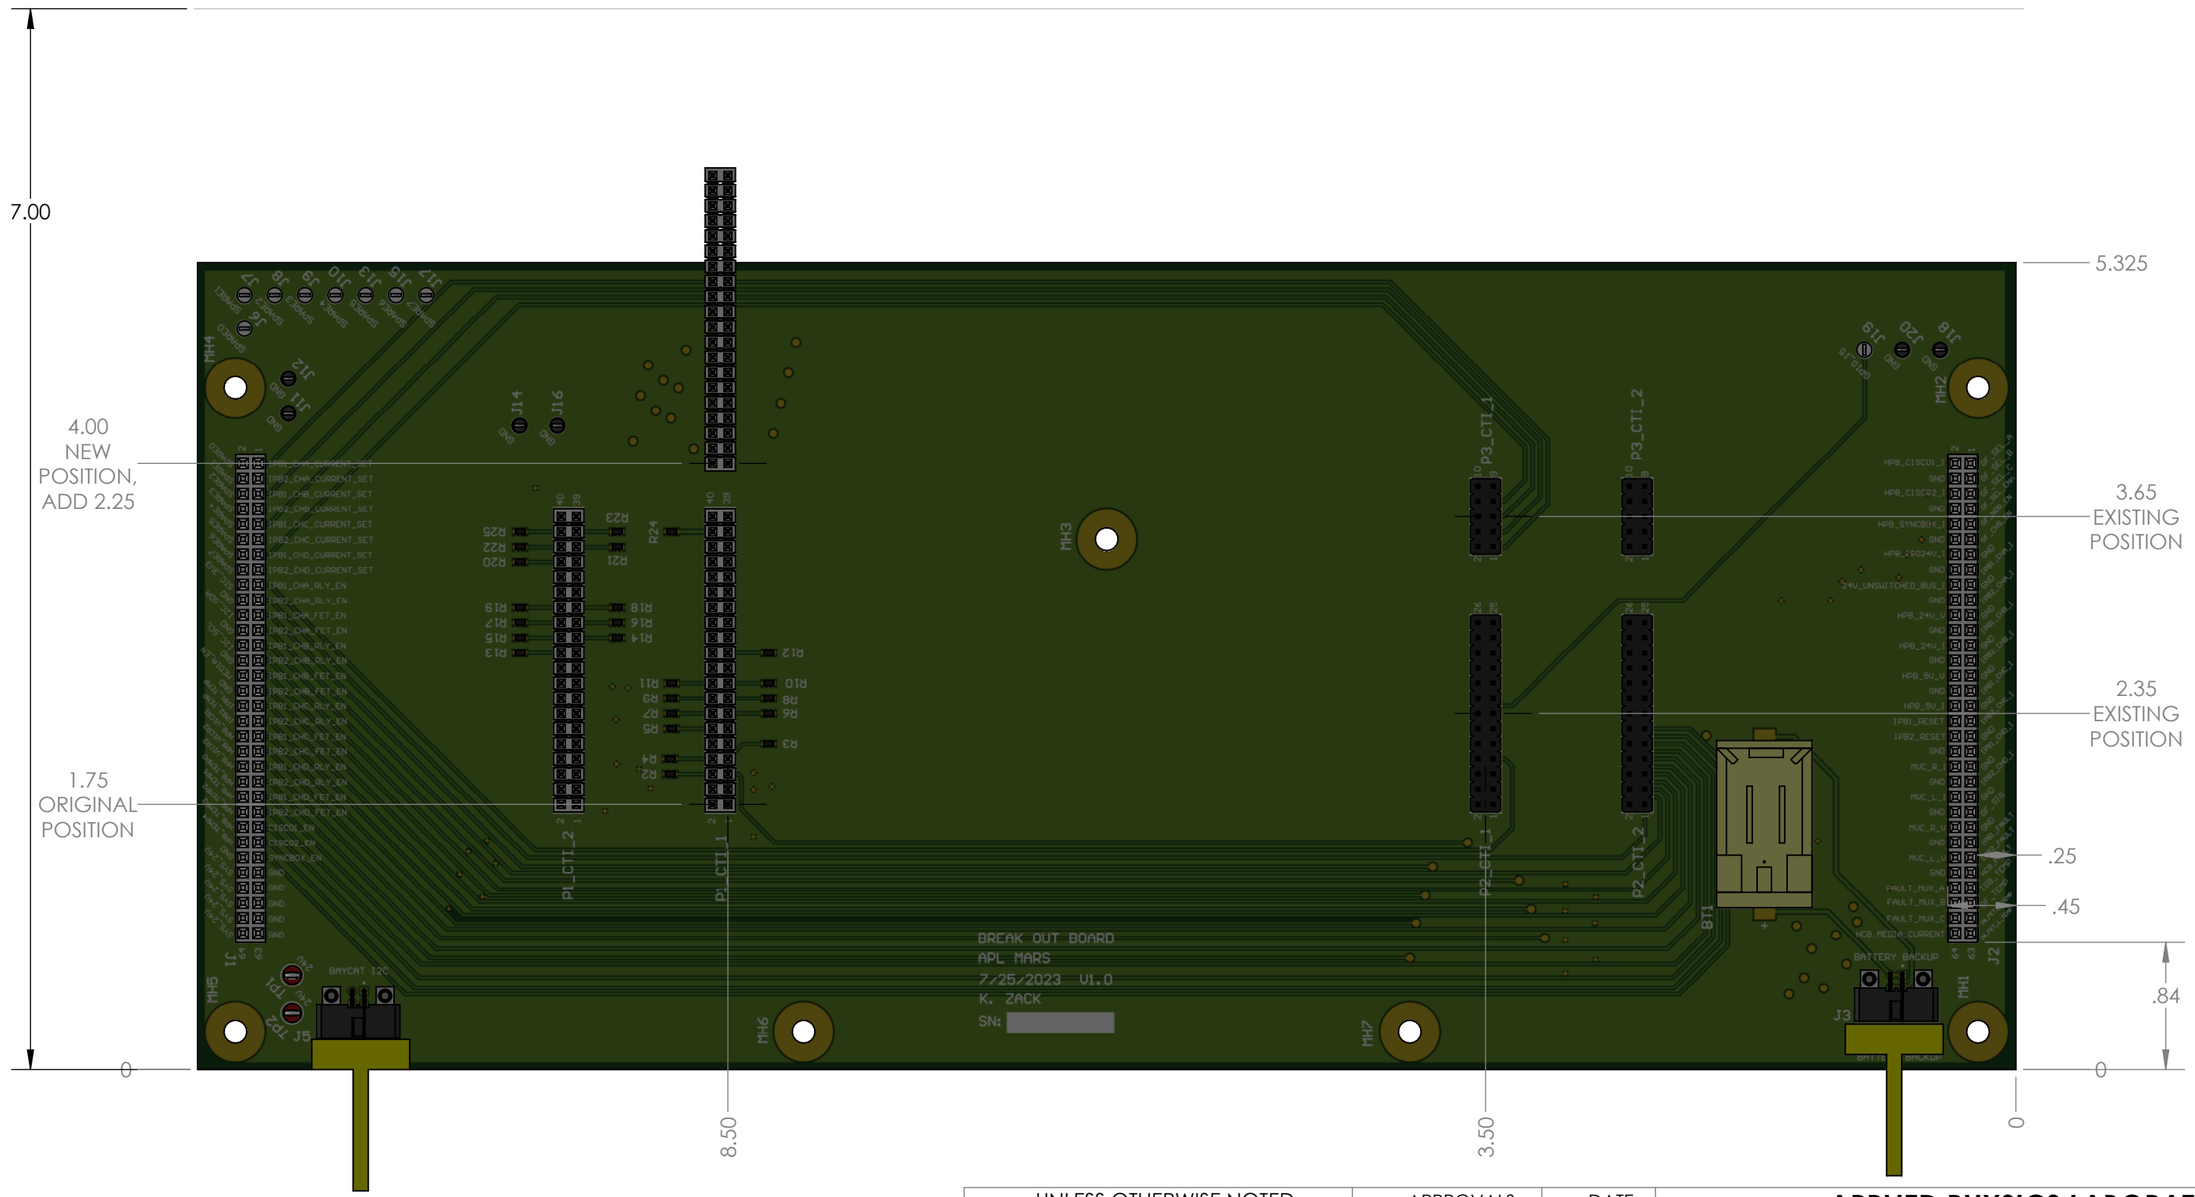

UNLESS OTHERWISE NOTED		APPROVALS	DATE
- APPLICABLE STANDARDS: MIL-STD-XXX - SURFACE FINISH: 125RMS - MACHINED FILLETS: R.015 MAX - REMOVE ALL BURRS, BREAK SHARP EDGES .015 MAX - DIMENSIONS AND SURFACE FINISH TO BE MET AFTER SPECIFIED COATINGS	DIMENSIONS ARE IN INCHES WEIGHT IS IN POUNDS (X.X) INDICATES A REPEATED OR INFORMATIONAL DIMENSION TOLERANCES: FRACTIONS: ± 1/16 .X: ± .050 .XX: ± .030 .XXX: ± .005 ANGLES: ± 1.0	CHIEF ENGR:	
		SYS ENGR:	
		QA/SAFETY:	
		SR ENGR:	
		ENGINEER: JESS NOE	--/--/----
		CHECKED:	
	MATERIAL: Material <not specified>	DRAWN: JESS NOE	--/--/----
THIRD ANGLE PROJECTION	WEIGHT: 0.183	DO NOT SCALE DRAWING	CAD FILE: AsmbSub_BOB

APPLIED PHYSICS LABORATORY
UNIVERSITY OF WASHINGTON
1013 NE 40TH ST. SEATTLE, WA. 98105

TITLE: XXXXXX

PROJECT FOLDER:	SIZE:	CAGE CODE:	DWG NO:	REV:
CLAW	B	98514	86239	A

SHEET 1 OF 1