



MARS
PLIB Site 3 - GLOBAL SENTINEL
22 Mar 2007 1352 UTC to 22 Mar 2007 1500 UTC

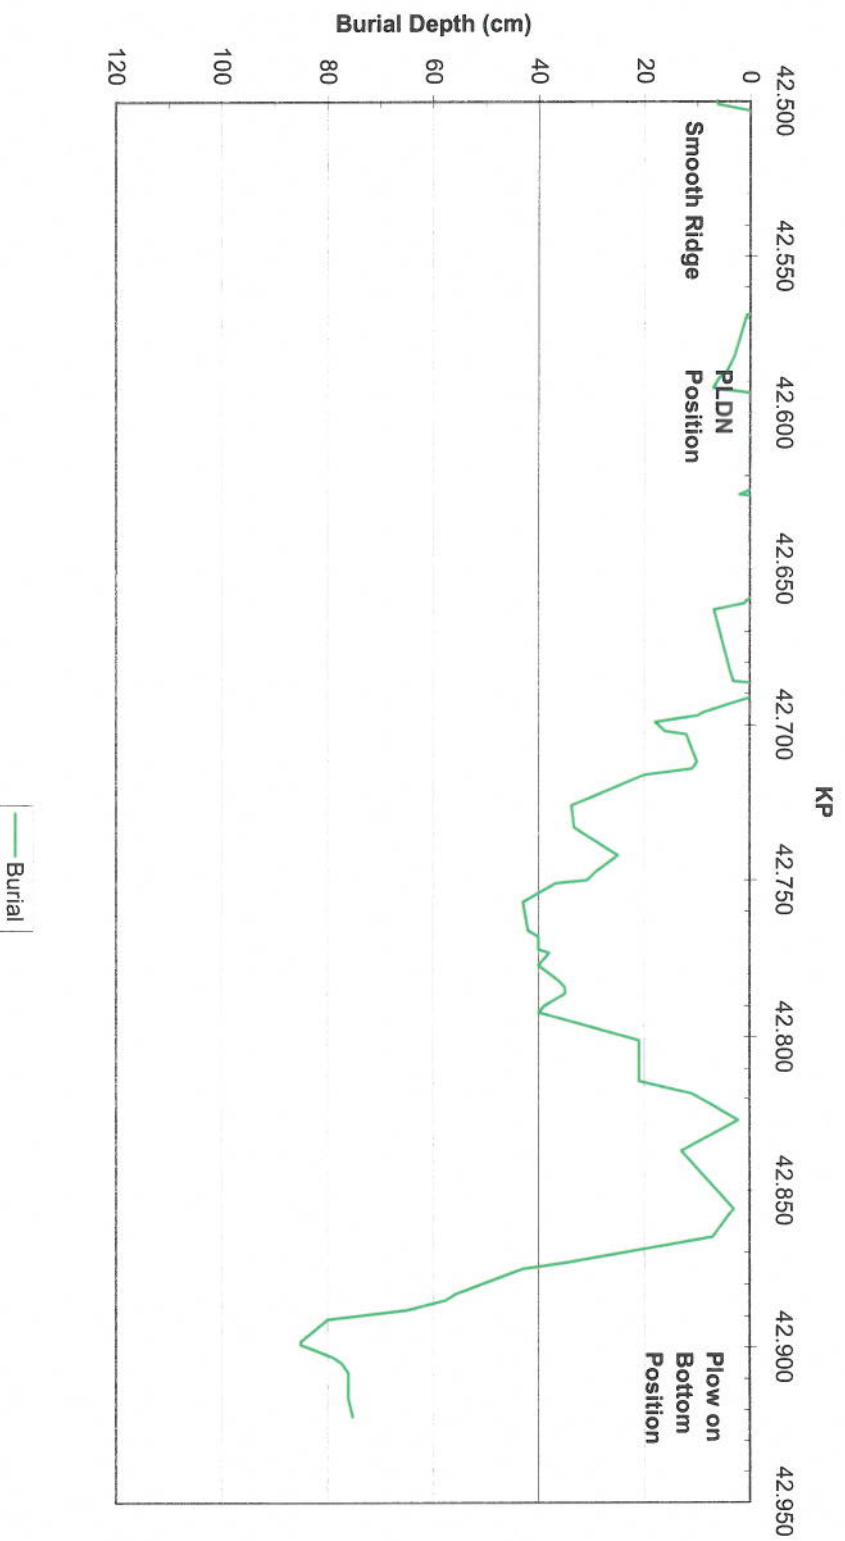

MARS
PLIB Site 4 & 5 - GLOBAL SENTINEL
01 Apr 2007 0835 UTC to 01 Apr 2007 1405 UTC

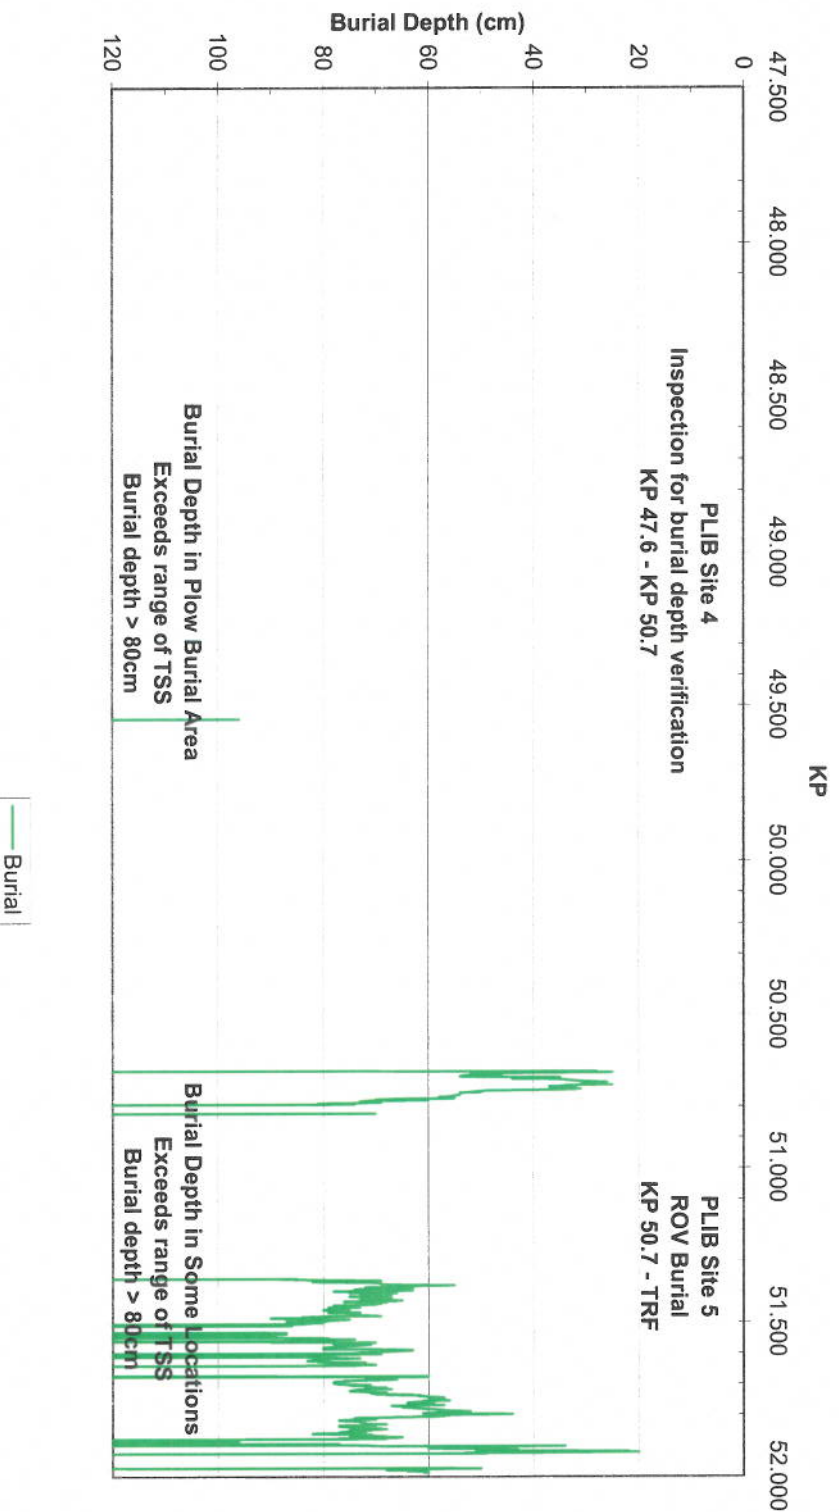

MARS
Daily Burial - GLOBAL SENTINEL
21 Mar 2007 0700 UTC to 21 Mar 2007 1455 UTC

