

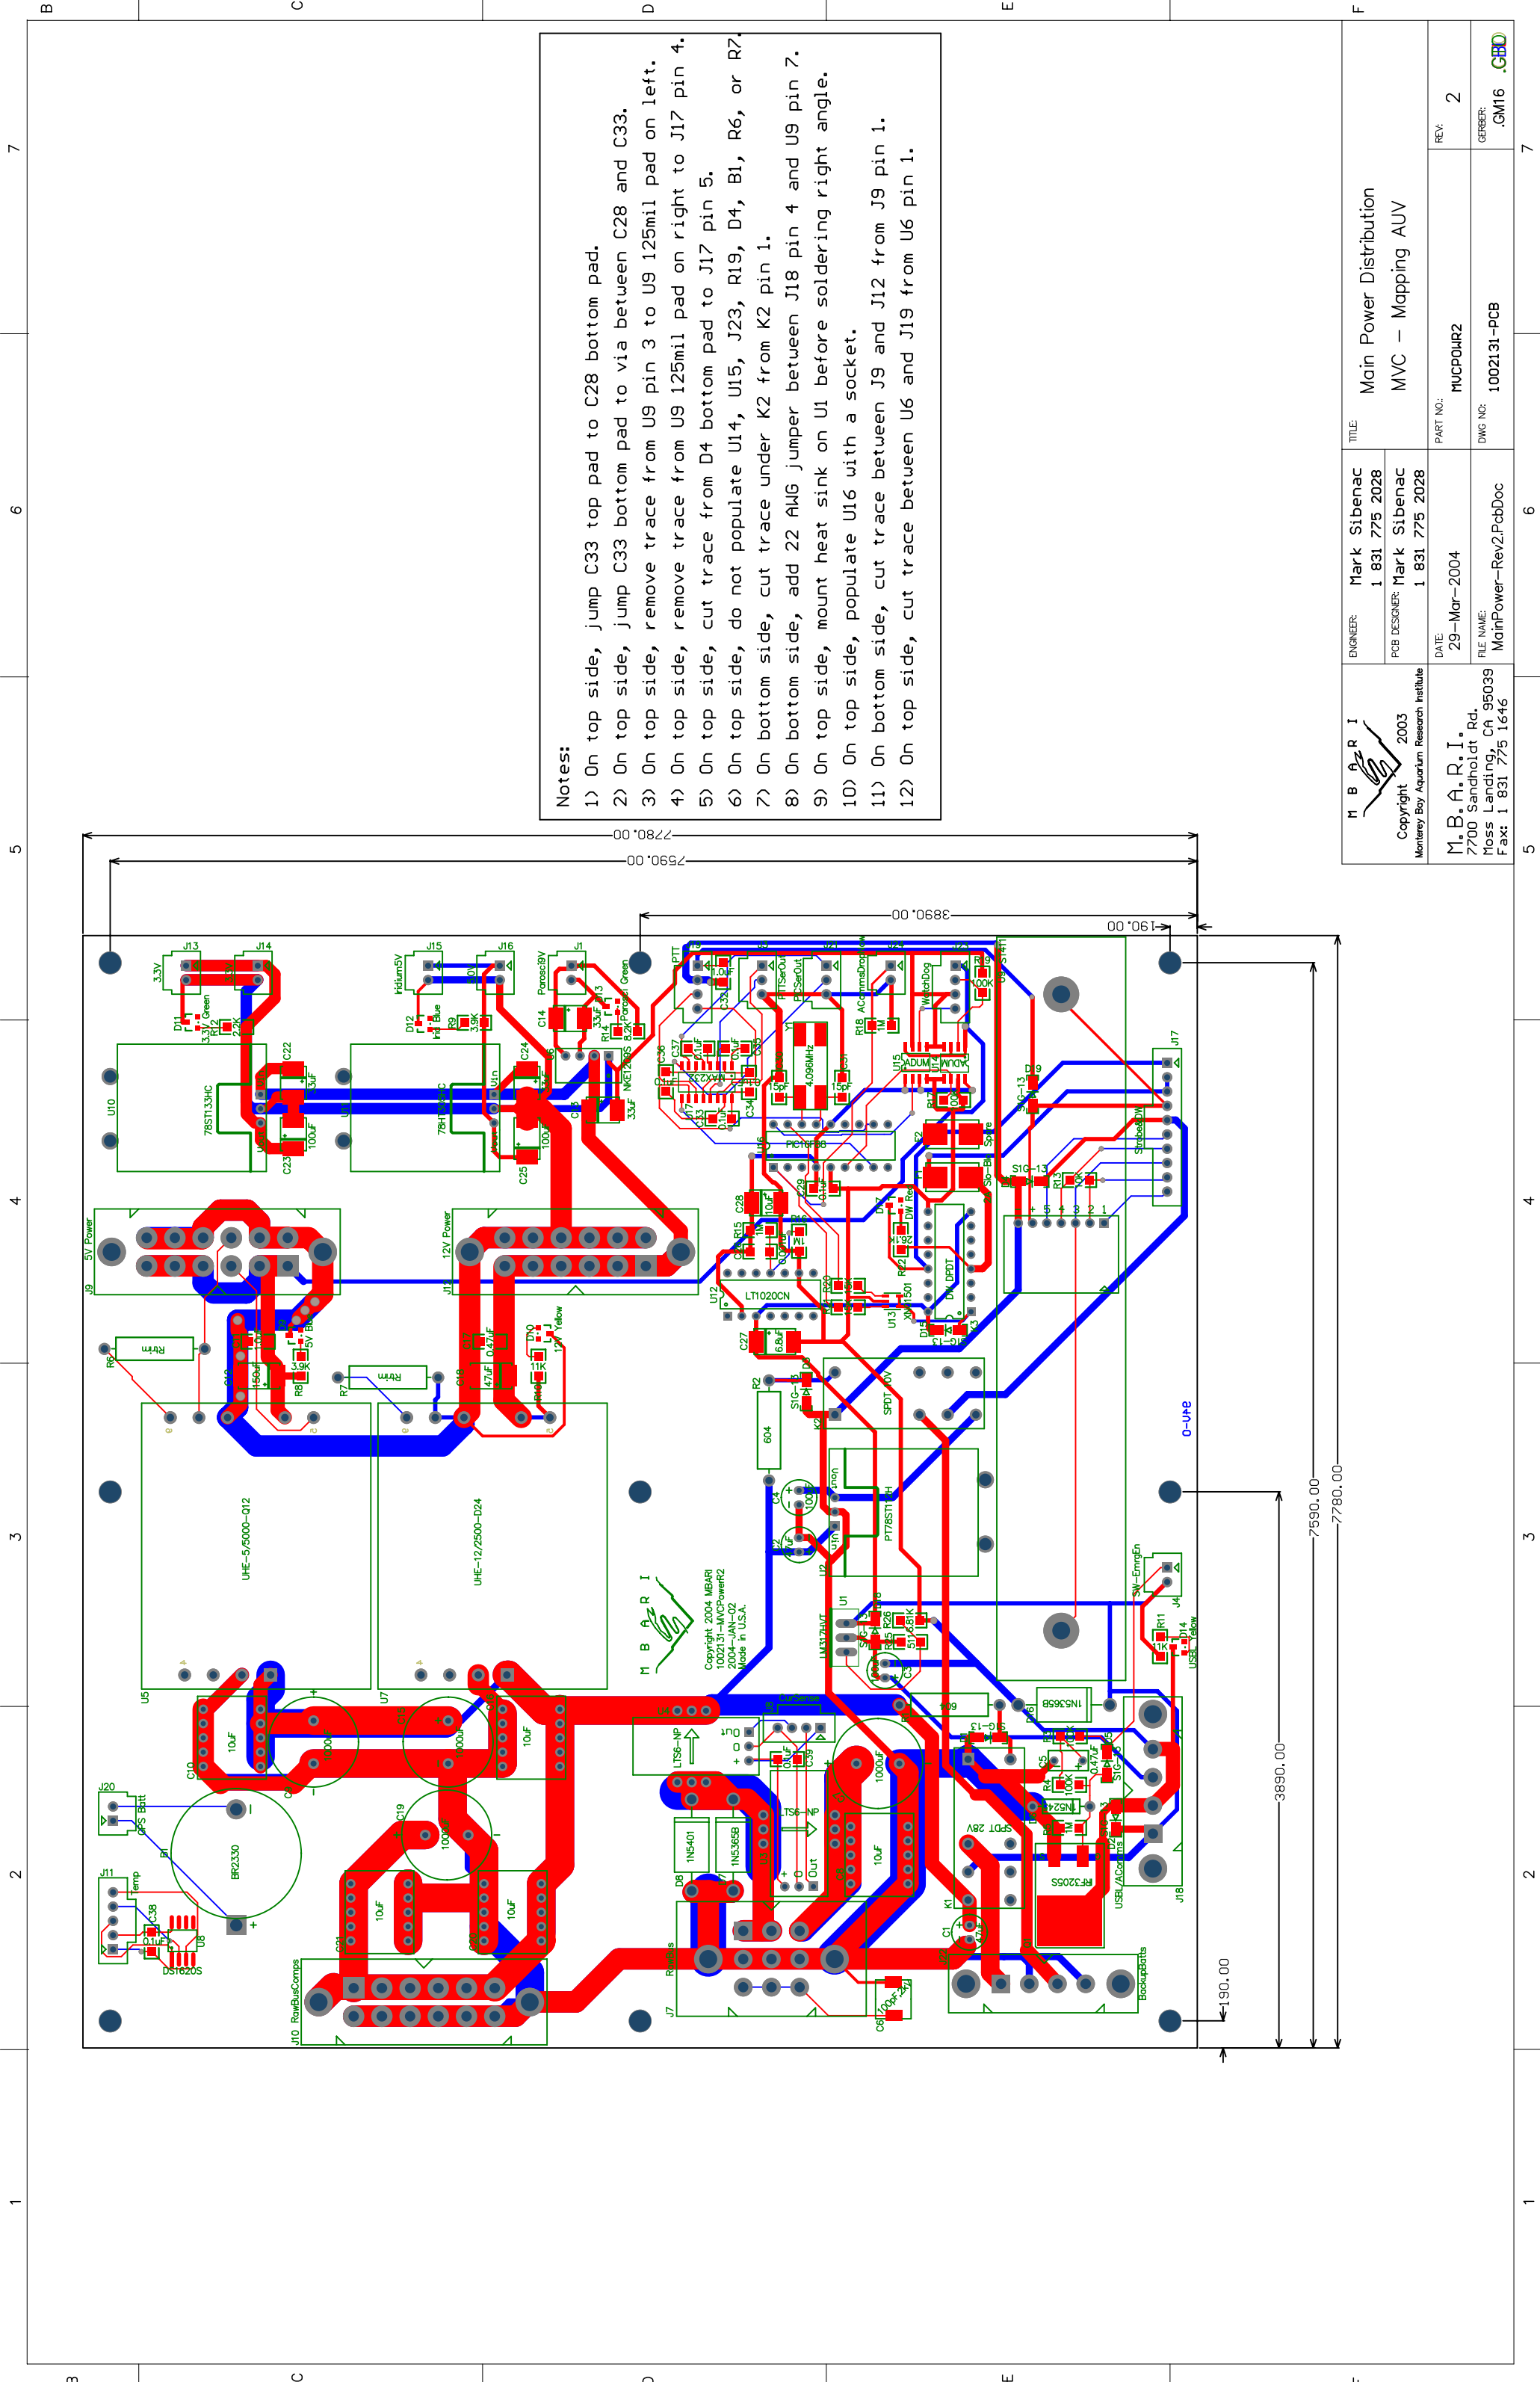
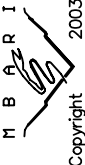


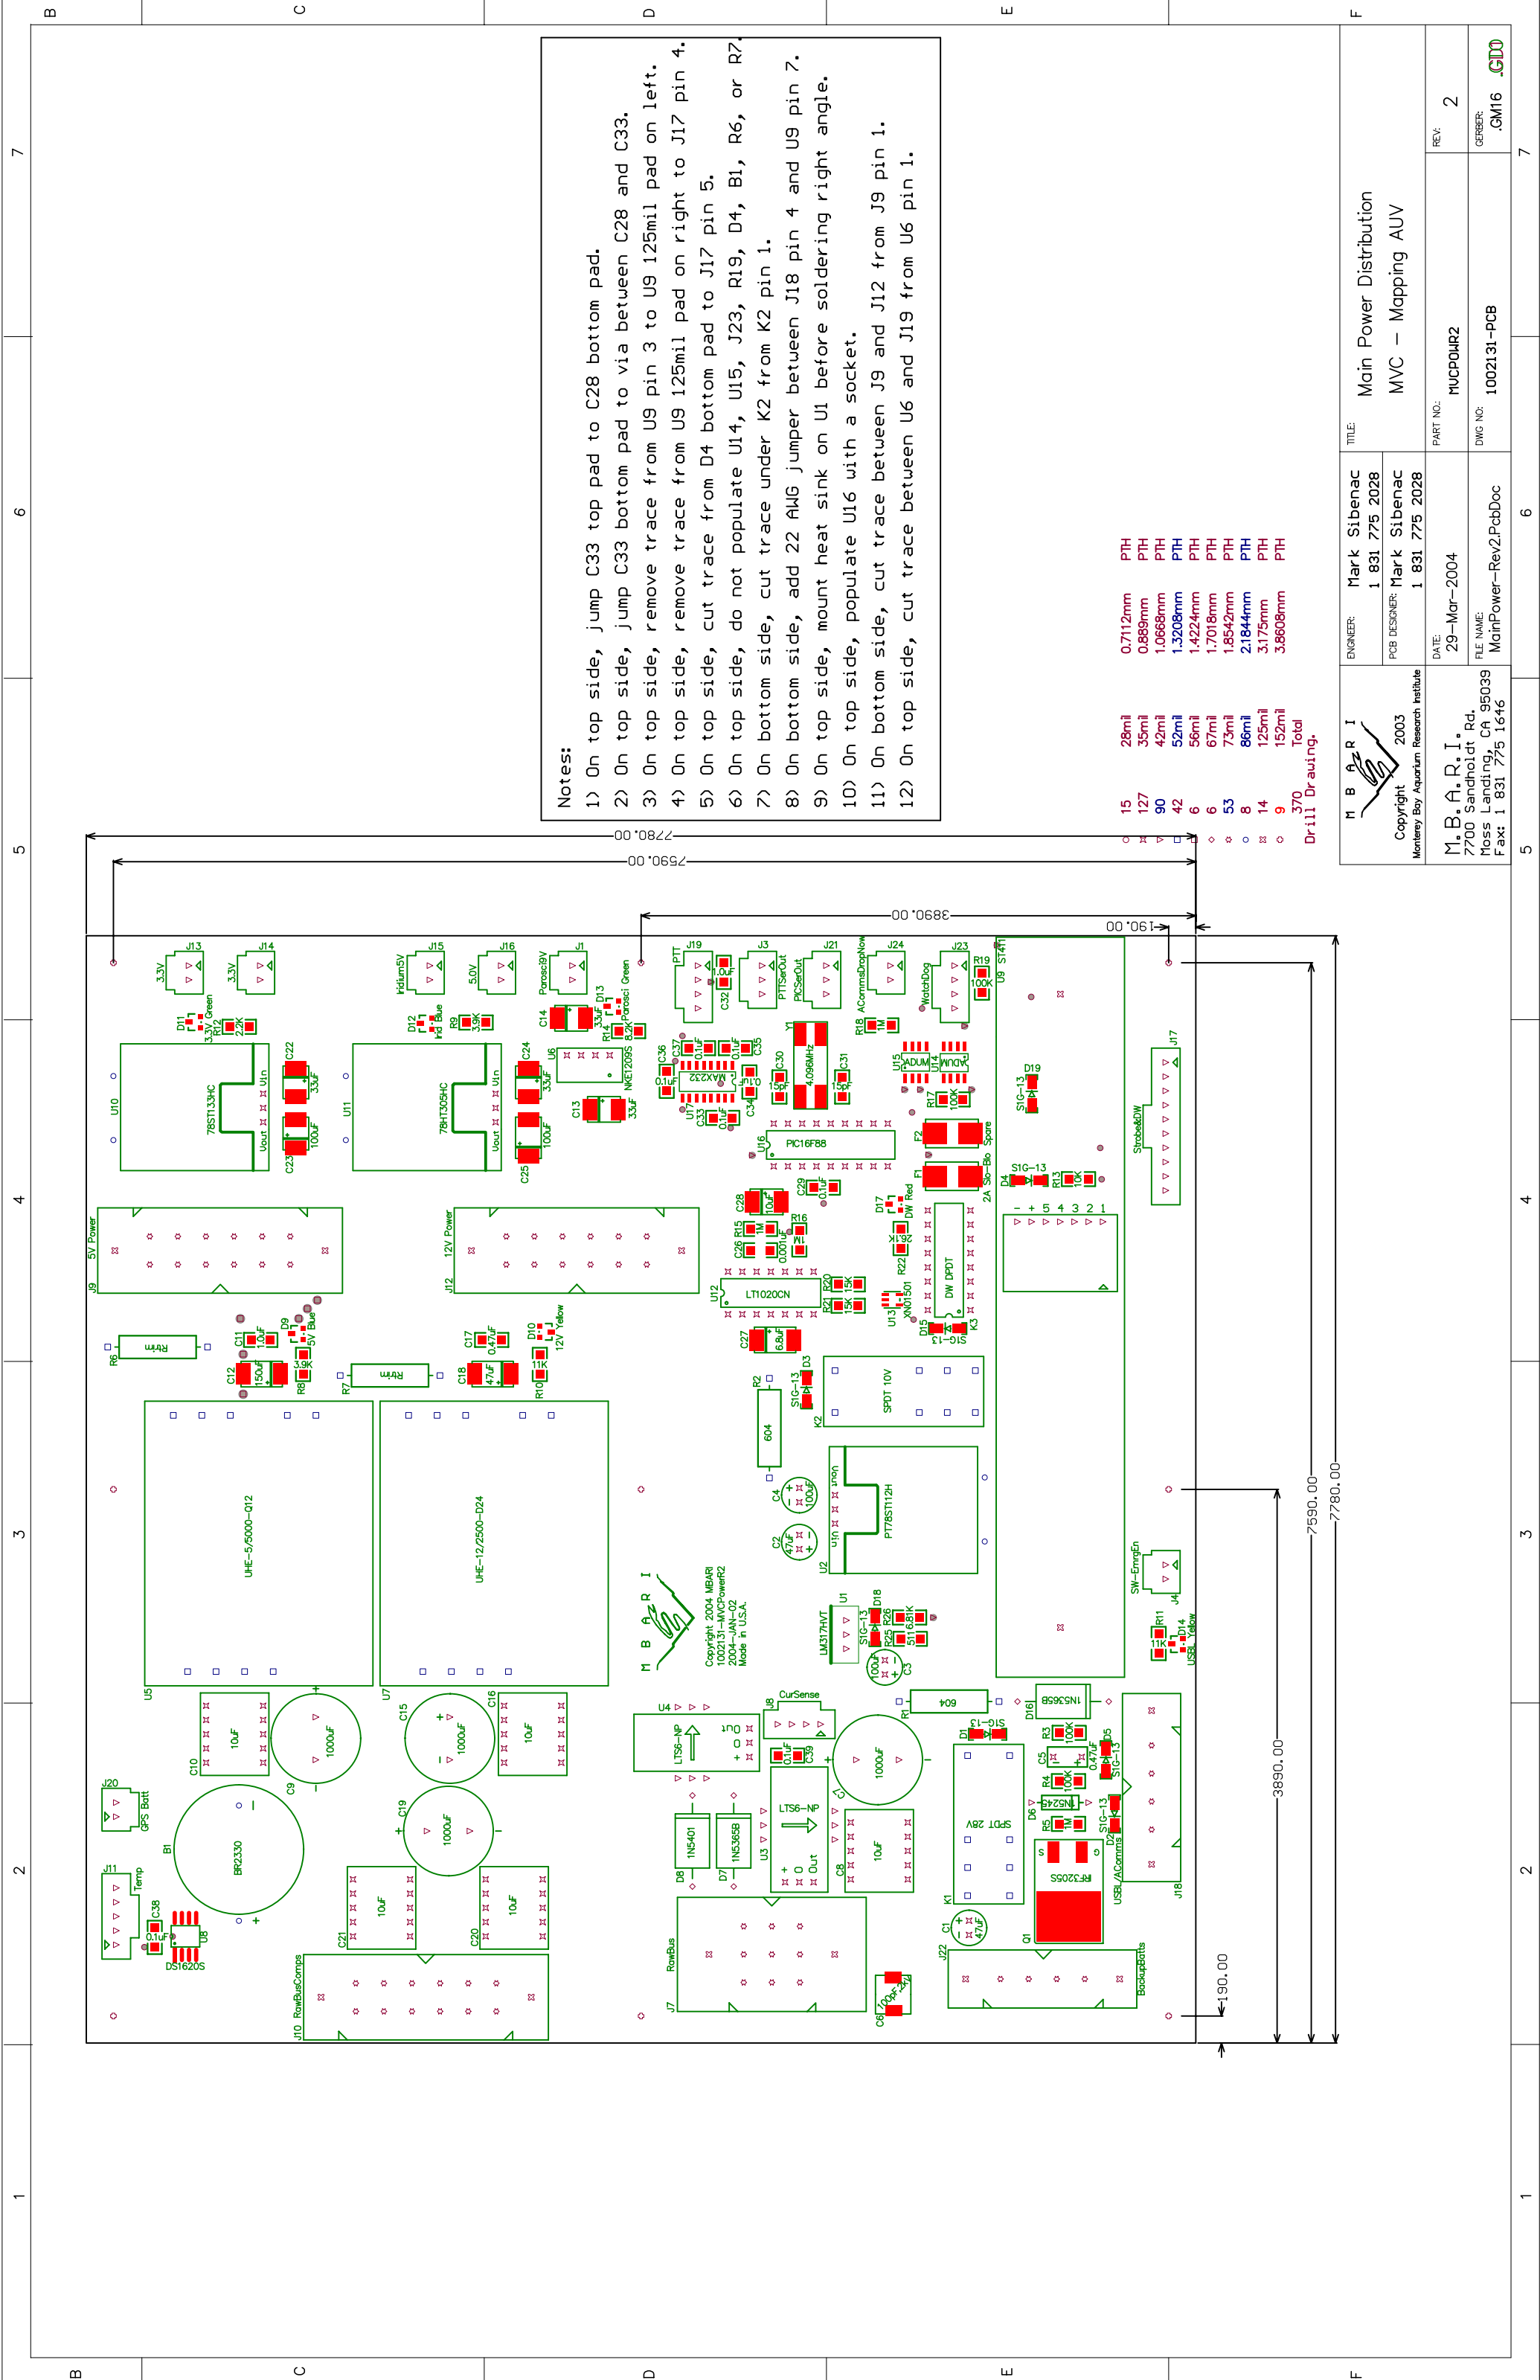

- Notes:
- 1) On top side, jump C33 top pad to C28 bottom pad.
 - 2) On top side, jump C33 bottom pad to via between C28 and C33.
 - 3) On top side, remove trace from U9 pin 3 to U9 125mil pad on left.
 - 4) On top side, remove trace from U9 125mil pad on right to J17 pin 4.
 - 5) On top side, cut trace from D4 bottom pad to J17 pin 5.
 - 6) On top side, do not populate U14, U15, J23, R19, D4, B1, R6, or R7.
 - 7) On bottom side, cut trace under K2 from K2 pin 1.
 - 8) On bottom side, add 22 AWG jumper between J18 pin 4 and U9 pin 7.
 - 9) On top side, mount heat sink on U1 before soldering right angle.
 - 10) On top side, populate U16 with a socket.
 - 11) On bottom side, cut trace between J9 and J12 from J9 pin 1.
 - 12) On top side, cut trace between U6 and J19 from U6 pin 1.

 Copyright 2003 Monterey Bay Aquarium Research Institute	ENGINEER: Mark Sibenac 1 831 775 2028	TITLE: Main Power Distribution
	PCB DESIGNER: Mark Sibenac 1 831 775 2028	MVC – Mapping AUV
M.B.A.R.I. 7700 Sandholdt Rd. Moss Landing, CA 95039 Fax: 1 831 775 1646	DATE: 29-Mar-2004	PART NO: MUCP04R2
	FILE NAME: MainPower-Rev2.PcbDoc	REV: 2 GERBER: .GM16 .GBO

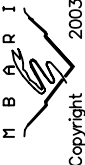

 Copyright 2003 Monterey Bay Aquarium Research Institute	ENGINEER: Mark Sibenac	TITLE: Main Power Distribution
	PCB DESIGNER: Mark Sibenac	MVC – Mapping AUV
M.B.A.R.I. 7700 Sandholdt Rd. Moss Landing, CA 95039 Fax: 1 831 775 1646	DATE: 29-Mar-2004	PART NO: MUCP04R2
	FILE NAME: MainPower-Rev2.PcbDoc	REV: 2
DWG NO: 1002131-PCB		GERBER: .G16